



PUBLIC WORKS DEPARTMENT
ENGINEERING DIVISION
156 S. BROADWAY, SUITE 150
TURLOCK, CA 95380

PHONE: (209) 668-5520
FAX: (209) 668-5563
TDD: (800) 735-2929
engineering@turlock.ca.us

Addendum No. 1

May 22, 2025

**City Project No.: 23-067, Package 3
Roads Program Capital Improvement Project**

Plan holders:

This addendum includes revisions to Plans and Specifications.

Revisions to Plans and Specifications

In the project Specifications, the following additions, deletions or modifications shall become part of the Contract Documents:

Red strikethrough text (~~text~~) indicates deletions.

Blue Underlined text (text) indicates additions.

In the project Plans, attention has been called to any modified areas but using a red revision cloud.

Item No. 1:

Delete sheets PC-1, X-3, DM-1, DM-5, DM-7, DM-8, DM-10, DM-11, L-1, L-5, L-7, L-8, L-10, L-11, CD-9, CD-13, CD-15, CD-17, G-5, G-7, G-8, G-10, G-11, DU-5, DU-7, DU-8, DU-10, DU-11, UUD-1, UUD-4, UUD-5, UUD-6, UUD-7, UUD-8, UUD-9, UUD-10, UUD-11, UUD-12, UUD-13, UUD-14, UUD-15, DP-1, TH-1, SS-1, SS-4, SS-7, SS-8, SS-10, SS-11, and SS-14,

And replace with attached sheets PC-1, X-3, DM-1, DM-5, DM-7, DM-8, DM-10, DM-11, L-1, L-5, L-7, L-8, L-10, L-11, CD-9, CD-13, CD-15, CD-17, G-5, G-7, G-8, G-10, G-11, DU-5, DU-7, DU-8, DU-10, DU-11, UUD-1, UUD-4, UUD-5, UUD-6, UUD-7, UUD-8, UUD-9, UUD-10, UUD-11, UUD-12, UUD-13, UUD-14, UUD-15, DP-1, TH-1, SS-1, SS-4, SS-7, SS-8, SS-10, SS-11, and SS-14 of this addendum.

Revisions consist of various items that clarify callouts, handling of shallow utilities, Christine Way and Heppner Way roadway and concrete reconstruction limits and grading, mid-block curb ramp near Arbor Way and Heppner Way, crosswalk removal, fence removal along Wallace St, crossing utilities with the proposed drainage system, and construction funding sign detail.

Item No. 2:

Delete Bid Schedule from project specifications and replace with attached Bid Schedule of this addendum.

Item No. 3:

Delete Table of Contents from project specifications and replace with attached Table of Contents of this addendum (see attached revised specifications).

Item No. 4:

Delete Bid Schedule from project specifications and replace with attached Bid Schedule of this addendum (see attached revised specifications).

Item No. 5:

Revise technical specifications Section 5.22 Order of Work, seventh paragraph (see attached revised specifications). Bidder's attention is called to the specific construction time constraints provided in the revisions. As noted, coordination with TUSD will be mandatory and construction in the vicinity of the school must be completed prior to the start of the new school year.

Item No. 6:

Revise technical specifications Section 8.02 Project Milestones, second paragraph, second sentence and third paragraph (see attached revised specifications).

Item No. 7:

Revise technical specifications Section 10 numbering section numbering (see attached revised specifications).

Item No. 8:

Revise technical specifications Section 10.06 Job Site Management, eighth paragraph, first sentence (see attached revised specifications).

Item No. 9:

Delete technical specifications Section 10.16 Earthwork, fourth paragraph (see attached revised specifications).

Item No. 10:

Add revised technical specifications Section 10.16A Unsuitable Material after Section 10.16 Earthwork (see attached revised specifications).

Item No. 11:

Revise technical specifications Section 10.18 Full Depth Reclamation - Cement, third paragraph, first and second bullets. (see attached revised specifications).

Item No. 12:

Add revised technical specifications Section 10.21 Excavate and Expose after Section 10.20 Minor Concrete. (see attached revised specifications).

Item No. 13:

Add revised technical specifications Section 10.22 Slurry Cement (2-Sack) after revised Section 10.21 Excavate and Expose. (see attached revised specifications).

Item No. 14:

Revise technical specifications Section 10.28 Relocate Fire Hydrant, second paragraph. (see attached revised specifications).

Item No. 15:

Revise technical specifications Section 10.33 Remove Fence, second paragraph. (see attached revised specifications).

Item No. 16:

Add revised technical specifications Section 10.38 Remove Thermoplastic Pavement Marking after Section 10.37 Remove Thermoplastic Traffic Stripe. (see attached revised specifications).

Item No. 17:

Revise technical specifications Appendix A: Pavement Design Report (see attached revised report).

Item No. 18:

Q: We have reviewed the FDR-C specification requirements in Section 10.18, specifically the required handwork around the utilities within 24-inches of the bottom of the FDR-C section. Per our estimation, there is upwards of 8,400 LF of utilities that may fall into these categories. This handwork will add a significant cost to the project and substantially impact the production of the FDR-C operations dramatically increases the impact to the public. Would the City be willing to modify the specification to slurry backfill all utilities within 24" of the FDR-C section and also add separate bid items for this work (excavate and expose utilities by the lineal foot and slurry backfill by the cubic

yard)? This will allow the contractors to accurately estimate and bid the required items of work, and will create a level, competitive bid environment for all responsible bidders.

A: Based on this question, the shallow utility strategy has been revised. Bid items have been added for Excavate and Expose Utility (LF) and Cement Slurry (2-sack) (LF). Please refer to the modifications in the plans and the specifications.

End of Addendum No. 1

1

Point Table				
Point #	Northing	Easting	Elevation	Raw Description
1000	2004921.43	6464890.31	105.95	SET 5\8" REBAR
1053	2007330.17	646573.78		TURLOCK CP H12-FOUND IP
1083	1999418.87	6457777.42		TURLOCK CP L9-FOUND IP
2515	2003374.70	6464981.48	105.34	SVCP MAG SE COR STOPBAR
2527	2005471.57	6465772.55	106.66	SVCP MAG NW COR TOP T
2535	2006187.93	6468424.67	111.19	SVCP SSMH
2600	2003437.88	6466391.43	106.08	SVCP MAG SE COR OF "P"
2601	2003751.98	6466423.74	106.68	SVCP MAG SW COR YELLOW CL
2602	2003728.89	6467042.70	107.48	SVCP MAG SE COR STOP BAR
2603	2003662.16	6467101.00	106.86	SVCP MAG SW COR "T"
2604	2003644.31	6468365.75	108.82	SVCP MAG SE COR "T"
2605	2003661.15	6469421.89	110.05	SVCP SDMH
2606	2004882.65	6466506.18	107.05	SVCP MAG SE COR "P"
2607	2005851.07	6466574.87	108.33	SVCP MAG NW COR YELLOW CL
2608	2006698.83	6466560.44	109.13	SVCP MAG NE COR YELLOW CL
2609	2006714.93	6465776.34	108.14	SVCP MAG NW COR "T"
2610	2006690.35	6467673.72	109.07	SVCP MAG NW COR X
2611	2006657.92	6468400.57	110.32	SVCP MAG SE INSIDE COR XWALK
2612	2006920.15	6467370.76	109.56	SVCP MAG NE COR "H"
2613	2006947.35	6468069.05	110.25	SVCP MAG NW COR YELLOW CL
2614	2007023.66	6465777.53	107.52	SVCP MAG NW COR "T"
2615	2006983.23	6467053.55	108.76	SVCP MAG SW COR STOP BAR
2616	2004876.93	6467723.62	108.90	SVCP MAG SE COR STOPBAR
2617	2005842.44	6467719.30	108.47	SVCP 60D TBC SE COR ALLEY/DW
2618	2006266.98	6468158.33	110.47	SVCP 60D SW DW AP 1260 LINN
2619	2005793.24	6468121.00	109.21	SVCP 60D TBC SE COR ADRESS 2290 MIRA FLORES
2620	2006208.22	6467853.57	109.74	SVCP MAG NW COR YLW STRIPE
2621	2006231.30	6467413.07	108.76	SVCP MAG NW COR YLW STRIPE
2622	2005835.61	6467348.08	107.74	SVCP 60D NW COR DW 2050
2623	2007369.82	6467074.43	108.07	SVCP MAG NE COR STOP BAR
2624	2008319.09	6467106.55	107.84	SVCP 60D NE COR OF GUTTER @ AC
2625	2009924.44	6467094.21	110.82	SVCP MAG NW COR "P"
2626	2009482.37	6467727.88	111.35	SVCP MAG NE COR RED CURB POC @ FRONT OF WALK
2627	2008823.69	6467587.21	110.21	SVCP MAG SW COR RED CURB POC @ FRONT OF WALK
2628	2007751.80	6467393.45	108.35	SVCP 60D SW COR OF GUTTER @ AC
2629	2008067.54	6467388.09	108.79	SVCP SSMH @ C/L
2630	2008028.07	6466740.23	108.70	SVCP 80D SW COR RED CURB POC AT FRONT OF WALK

PROJECT VERTICAL BENCHMARKS		
BENCHMARK ID	ELEVATION	DESCRIPTION
13-1-3	110.059	FOUND BRASS PLUG NW CORNER ON EAST MARSHALL AT DAUENBERGER ROAD
22-4-2	98.282	FOUND BRASS PLUG SW CORNER ON ORANGE AT HIGH STREET
24-3-1	105.563	FOUND BRASS PLUG SE CORNER ON SOUTH BERKELEY AT EAST AVENUE

LEGEND:
 CONTROL POINT LOCATION
 ##### CONTROL POINT NUMBER

NOTES:

- CONTRACTOR SHALL COMPLY WITH BUSINESS AND PROFESSIONS CODE SECTION 8771 (b) REGARDING REFERENCING, PRESERVING AND RECONSTRUCTING MONUMENTS, WHETHER OR NOT MONUMENTS ARE SHOWN IN THESE PLANS.
- IF MONUMENT IS DAMAGED BY CONTRACTOR'S OPERATIONS, CONTRACTOR SHALL REPLACE AT CONTRACTOR'S COST.
- CONTRACTOR SHALL PROVIDE THE AGENCY A MINIMUM OF TWO (2) WEEKS NOTICE PRIOR TO COMMENCING ANY WORK THAT COULD DAMAGE OR DESTROY ANY SURVEY MONUMENTS.

HORIZONTAL DATUM


HORIZONTAL DATUM IS BASED ON THE CITY OF TURLOCK G.P.S. CONTROL NETWORK SURVEY FILED IN BOOK 20 OF SURVEYS AT PAGE 56, STANISLAUS COUNTY RECORDS. SAID SURVEY IS BASED ON THE 1983 NORTH AMERICAN DATUM AND ADJUSTMENT AS SHOWN ON THE FACE OF SAID SURVEY. POINTS H12 AND L9 AS SHOWN ON THE SURVEY WERE USED AS THE BASE CONTROL FOR THIS PROJECT.

COORDINATE SYSTEM

THE CALIFORNIA COORDINATE SYSTEM OF 1983 (CCS83), ZONE III.

VERTICAL DATUM

ELEVATIONS BASED ON THE CITY OF TURLOCK BENCHMARK SYSTEM

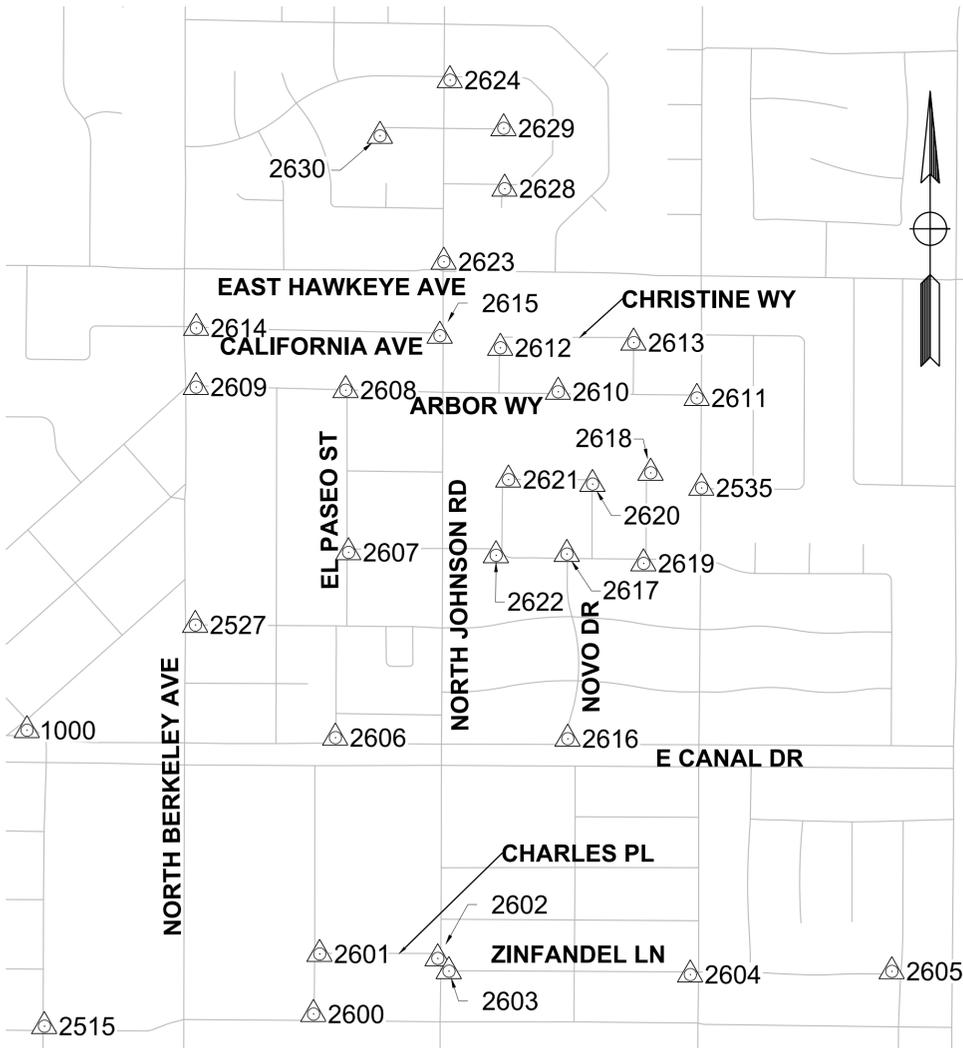

Alignment Table				
Alignment	Station	Northing	Easting	
NORTH JOHNSON RD "NJ"	Beg	10+00.00	2007310.94	6467074.72
	END	36+78.51	2009989.43	6467087.05
SCONYERS CT "SC"	Beg	10+00.00	2008859.97	6467081.85
	END	16+13.98	2003374.70	6464981.48
HAMMOND DR "HA"	Beg	10+00.00	2007776.19	6467076.86
	END	25+18.83	2006187.93	6468424.67
ASHLEY CT "AS"	Beg	10+00.00	2008071.43	6466698.26
	END	13+29.98	2008066.10	6467078.20
JACKSON CT "JS"	Beg	10+00.00	2008066.10	6467078.20
	END	13+49.93	2008061.11	6467428.09
STUART CT "ST"	Beg	10+00.00	2007586.97	6467374.18
	END	11+85.03	2007771.98	6467377.05

SURVEY POINTS MAP

100% PLANS

DESIGNED BY: POORE, B.
 DRAWN BY: HAYNES, C.
 CHECKED BY: HORNER, C.
 SCALE: NOT TO SCALE
 DATE: 5/21/2025
 JOB NO.: 24-00061

NOTE:
 ALL REFERENCES AND WRITTEN DIMENSIONS SHALL SUPERCEDE ALL SCALED DISTANCES AND SHALL BE VERIFIED IN THE FIELD. ANY DISCREPANCY SHALL BE BROUGHT TO THE ATTENTION OF THE ENGINEER PRIOR TO THE COMMENCEMENT OF WORK.




MARK THOMAS
 701 UNIVERSITY AVENUE, SUITE 200
 SACRAMENTO, CALIFORNIA 95825
 (916) 381-9100 FAX:(916)381-9180
 markthomas.com

CITY OF TURLOCK
 MUNICIPAL SERVICES DEPARTMENT
 156 S. BROADWAY
 SUITE 150
 (209) 668-5520





CITY OF TURLOCK
ROADS PROGRAM CIP
PROJECT 23-067 PACKAGE #2
PROJECT CONTROL


Sheet 4
 of
68 Sheets
PC - 1

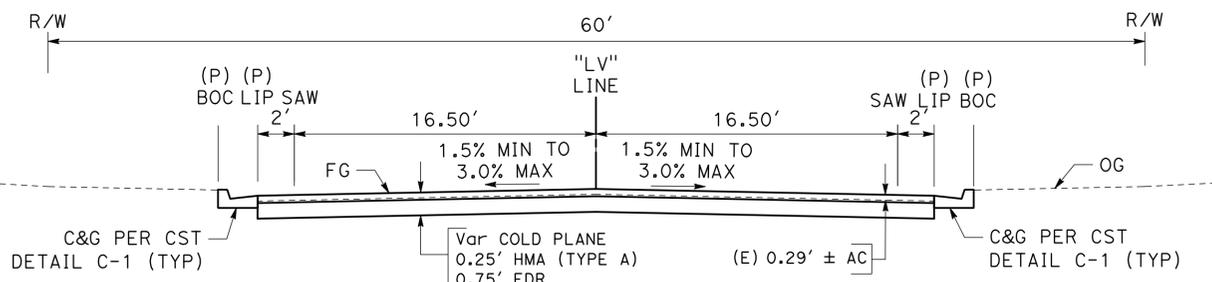



LINDA VISTA ST
"LV" 10+21.75 TO 14+76.83

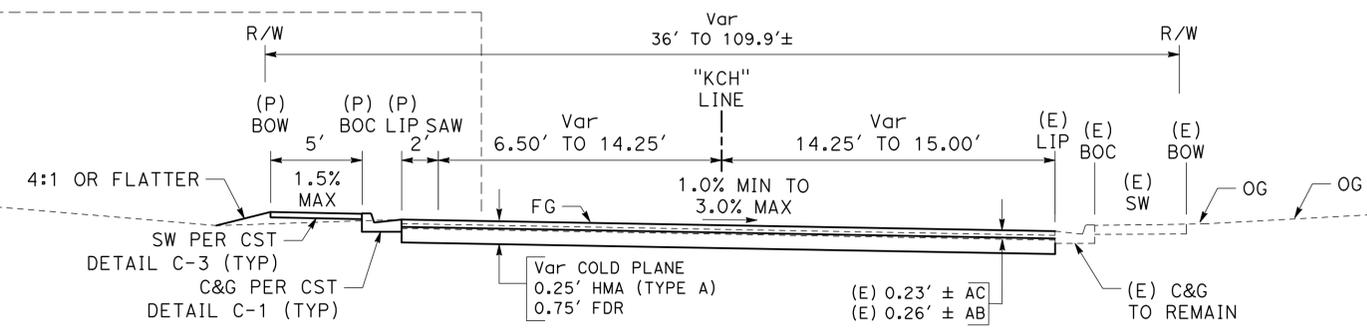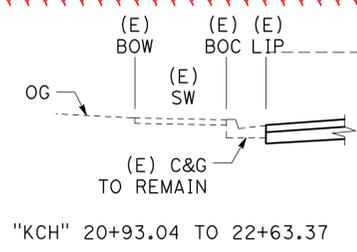


CHRISTINE WY/HEPPNER WY
"KCH" 20+25.93 TO 22+63.37

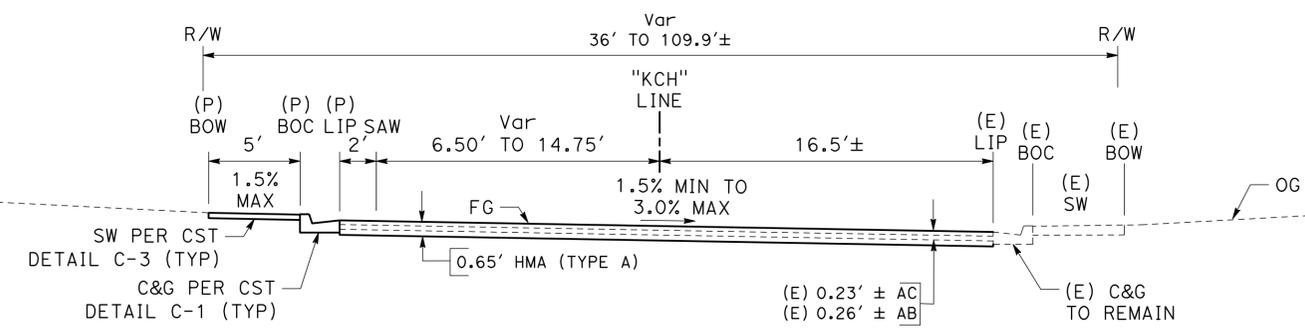

CHRISTINE WY/HEPPNER WY
"KCH" 19+39.06 TO 20+25.93

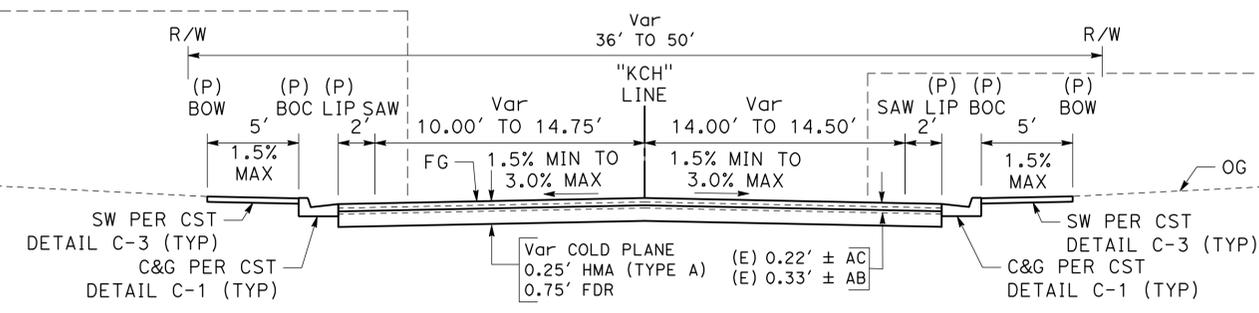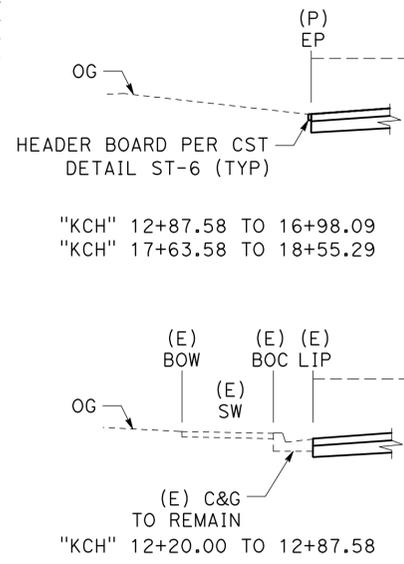


KAREN WY/CHRISTINE WAY
"KCH" 10+22.00 TO 19+39.06

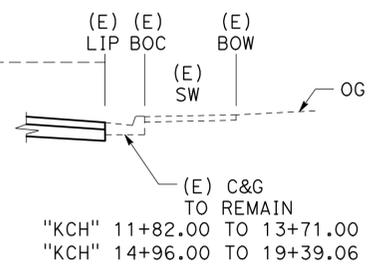

100% PLANS

DESIGNED BY: POORE, B.
DRAWN BY: FRANCO, N.
CHECKED BY: NORIEGA, E.
SCALE: NOT TO SCALE
DATE: 5/21/2025
JOB NO.: 24-00061

NOTE:
ALL REFERENCES AND WRITTEN DIMENSIONS SHALL SUPERCEDE ALL SCALED DISTANCES AND SHALL BE VERIFIED IN THE FIELD. ANY DISCREPANCY SHALL BE BROUGHT TO THE ATTENTION OF THE ENGINEER PRIOR TO THE COMMENCEMENT OF WORK.

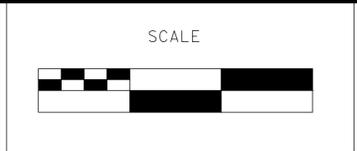

MARK THOMAS
701 UNIVERSITY AVENUE, SUITE 200
SACRAMENTO, CALIFORNIA 95825
(916) 381-9100 FAX:(916)381-9180
markthomas.com

CITY OF TURLOCK MUNICIPAL SERVICES DEPARTMENT
156 S. BROADWAY SUITE 150
(209) 668-5520

CITY OF TURLOCK
ROADS PROGRAM CIP
PROJECT 23-067 PACKAGE #3
TYPICAL SECTIONS


Sheet 7 of 126 Sheets
X - 3

NOTES (DM-1 TO DM-15):

- CLEARING AND GRUBBING ARE SHOWN AS APPROXIMATE
- SEE LAYOUT SHEETS FOR COLD PLANE DEPTH LIMITS
- CONTRACTOR TO NOTIFY PROPERTY OWNERS IN ADVANCE OF WORK TO SALVAGE EXISTING LANDSCAPING
- AS SHOWN ON THE X SHEETS, AND THE TYPICAL CURB, GUTTER, AND SIDEWALK REMOVAL DETAIL ON THIS SHEET, THE SAWCUT STRIP ADJACENT TO PROPOSED CURB AND GUTTER SHALL BE 2' WIDE MEASURED FROM THE PROPOSED GUTTER LIP (NOT THE EXISTING GUTTER LIP).


LEGEND (DM-1 TO DM-15):

- ROADWAY EXCAVATION (0.65' DEPTH FOR 2' SAWCUT AREAS, Var DEPTH FOR DRIVEWAY REMOVALS, 0.3' FOR SIDEWALK AREAS)
- REMOVE CONCRETE (CURB RAMPS, SIDEWALK, VALLEY GUTTER, DRIVEWAYS, CURB AND GUTTER)
- SAWCUT
- REMOVE FENCE
- COLD PLANE AC PAVEMENT (Var DEPTH, PROPOSED PAVEMENT TI=6, SEE TYPICAL SECTIONS)
- COLD PLANE AC PAVEMENT (Var DEPTH, PROPOSED PAVEMENT TI=8, SEE TYPICAL SECTIONS)
- ROADWAY EXCAVATION (Var DEPTH FOR FULL DEPTH HMA PAVEMENT SECTION TI=6)
- ROADWAY EXCAVATION (Var DEPTH FOR FULL DEPTH HMA PAVEMENT SECTION TI=8)
- REMOVE ASPHALT CONCRETE PAVEMENT

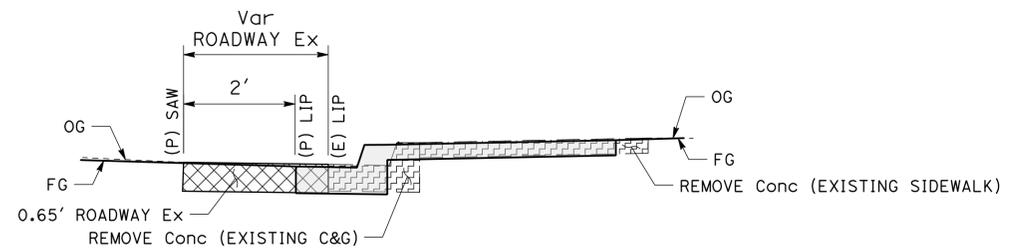

TYPICAL CURB, GUTTER AND SIDEWALK REMOVAL DETAIL


NO SCALE

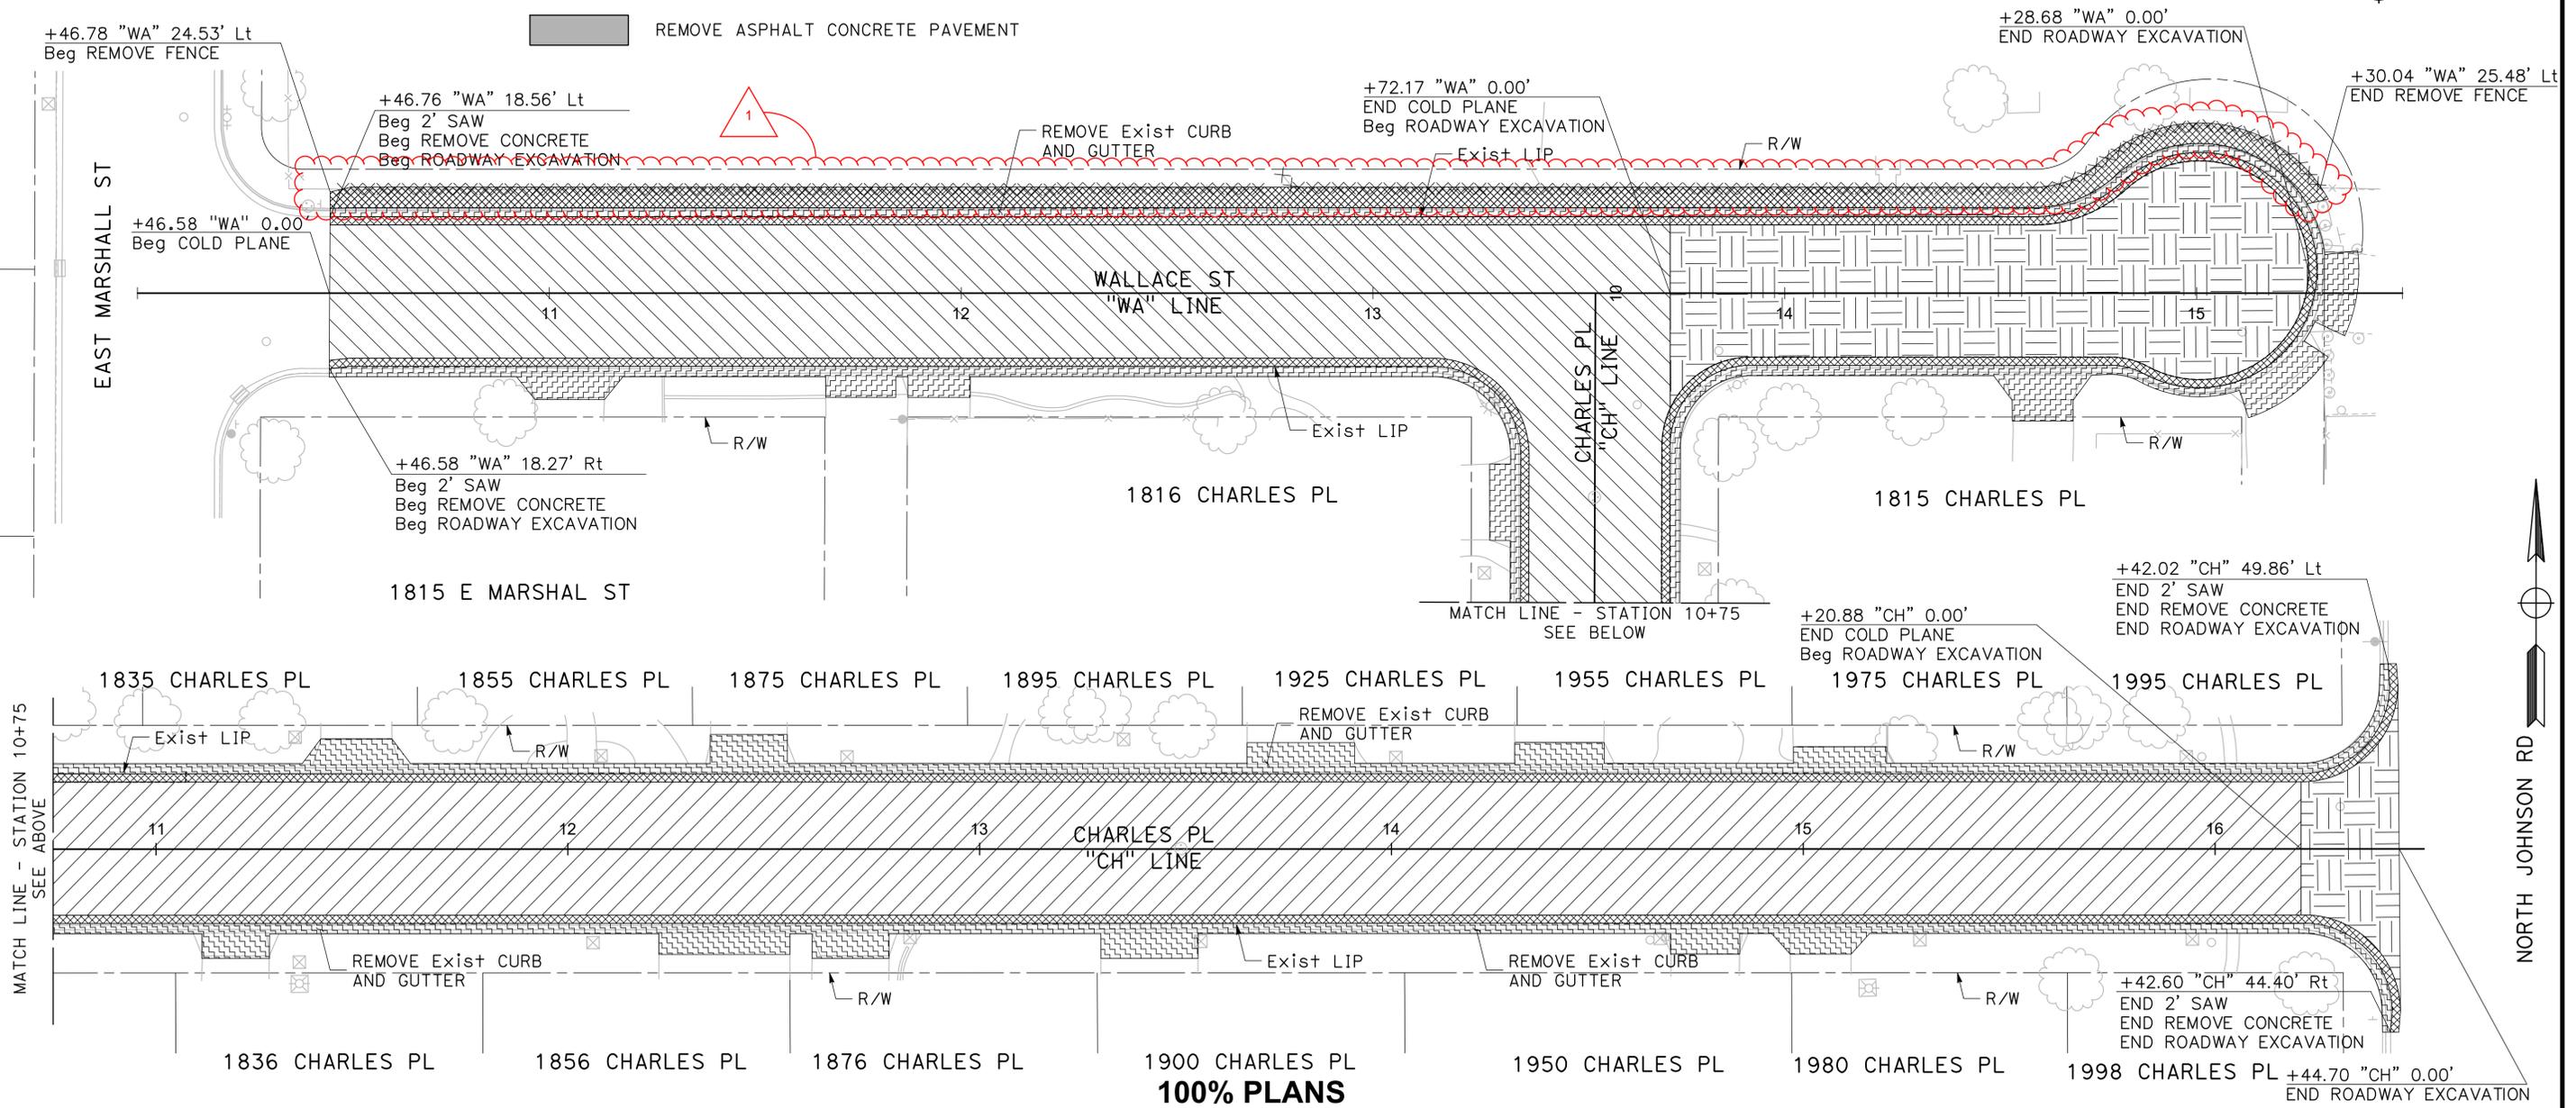

100% PLANS

DESIGNED BY: POORE, B.
 DRAWN BY: FRANCO, N.
 CHECKED BY: NORIEGA, E.
 SCALE: 1"=20'
 DATE: 5/21/2025
 JOB NO.: 24-00061

NOTE:
 ALL REFERENCES AND WRITTEN DIMENSIONS SHALL SUPERCEDE ALL SCALED DISTANCES AND SHALL BE VERIFIED IN THE FIELD. ANY DISCREPANCY SHALL BE BROUGHT TO THE ATTENTION OF THE ENGINEER PRIOR TO THE COMMENCEMENT OF WORK.

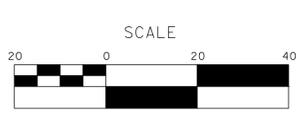


MARK THOMAS
 701 UNIVERSITY AVENUE, SUITE 200
 SACRAMENTO, CALIFORNIA 95825
 (916) 381-9100 FAX:(916)381-9180
 markthomas.com

CITY OF TURLOCK
 MUNICIPAL SERVICES
 DEPARTMENT
 156 S. BROADWAY
 SUITE 150
 (209) 668-5520



**CITY OF TURLOCK
 ROADS PROGRAM CIP
 PROJECT 23-067 PACKAGE #3
 DEMOLITION PLANS**

Sheet **10**
 of
126 Sheets
DM-1

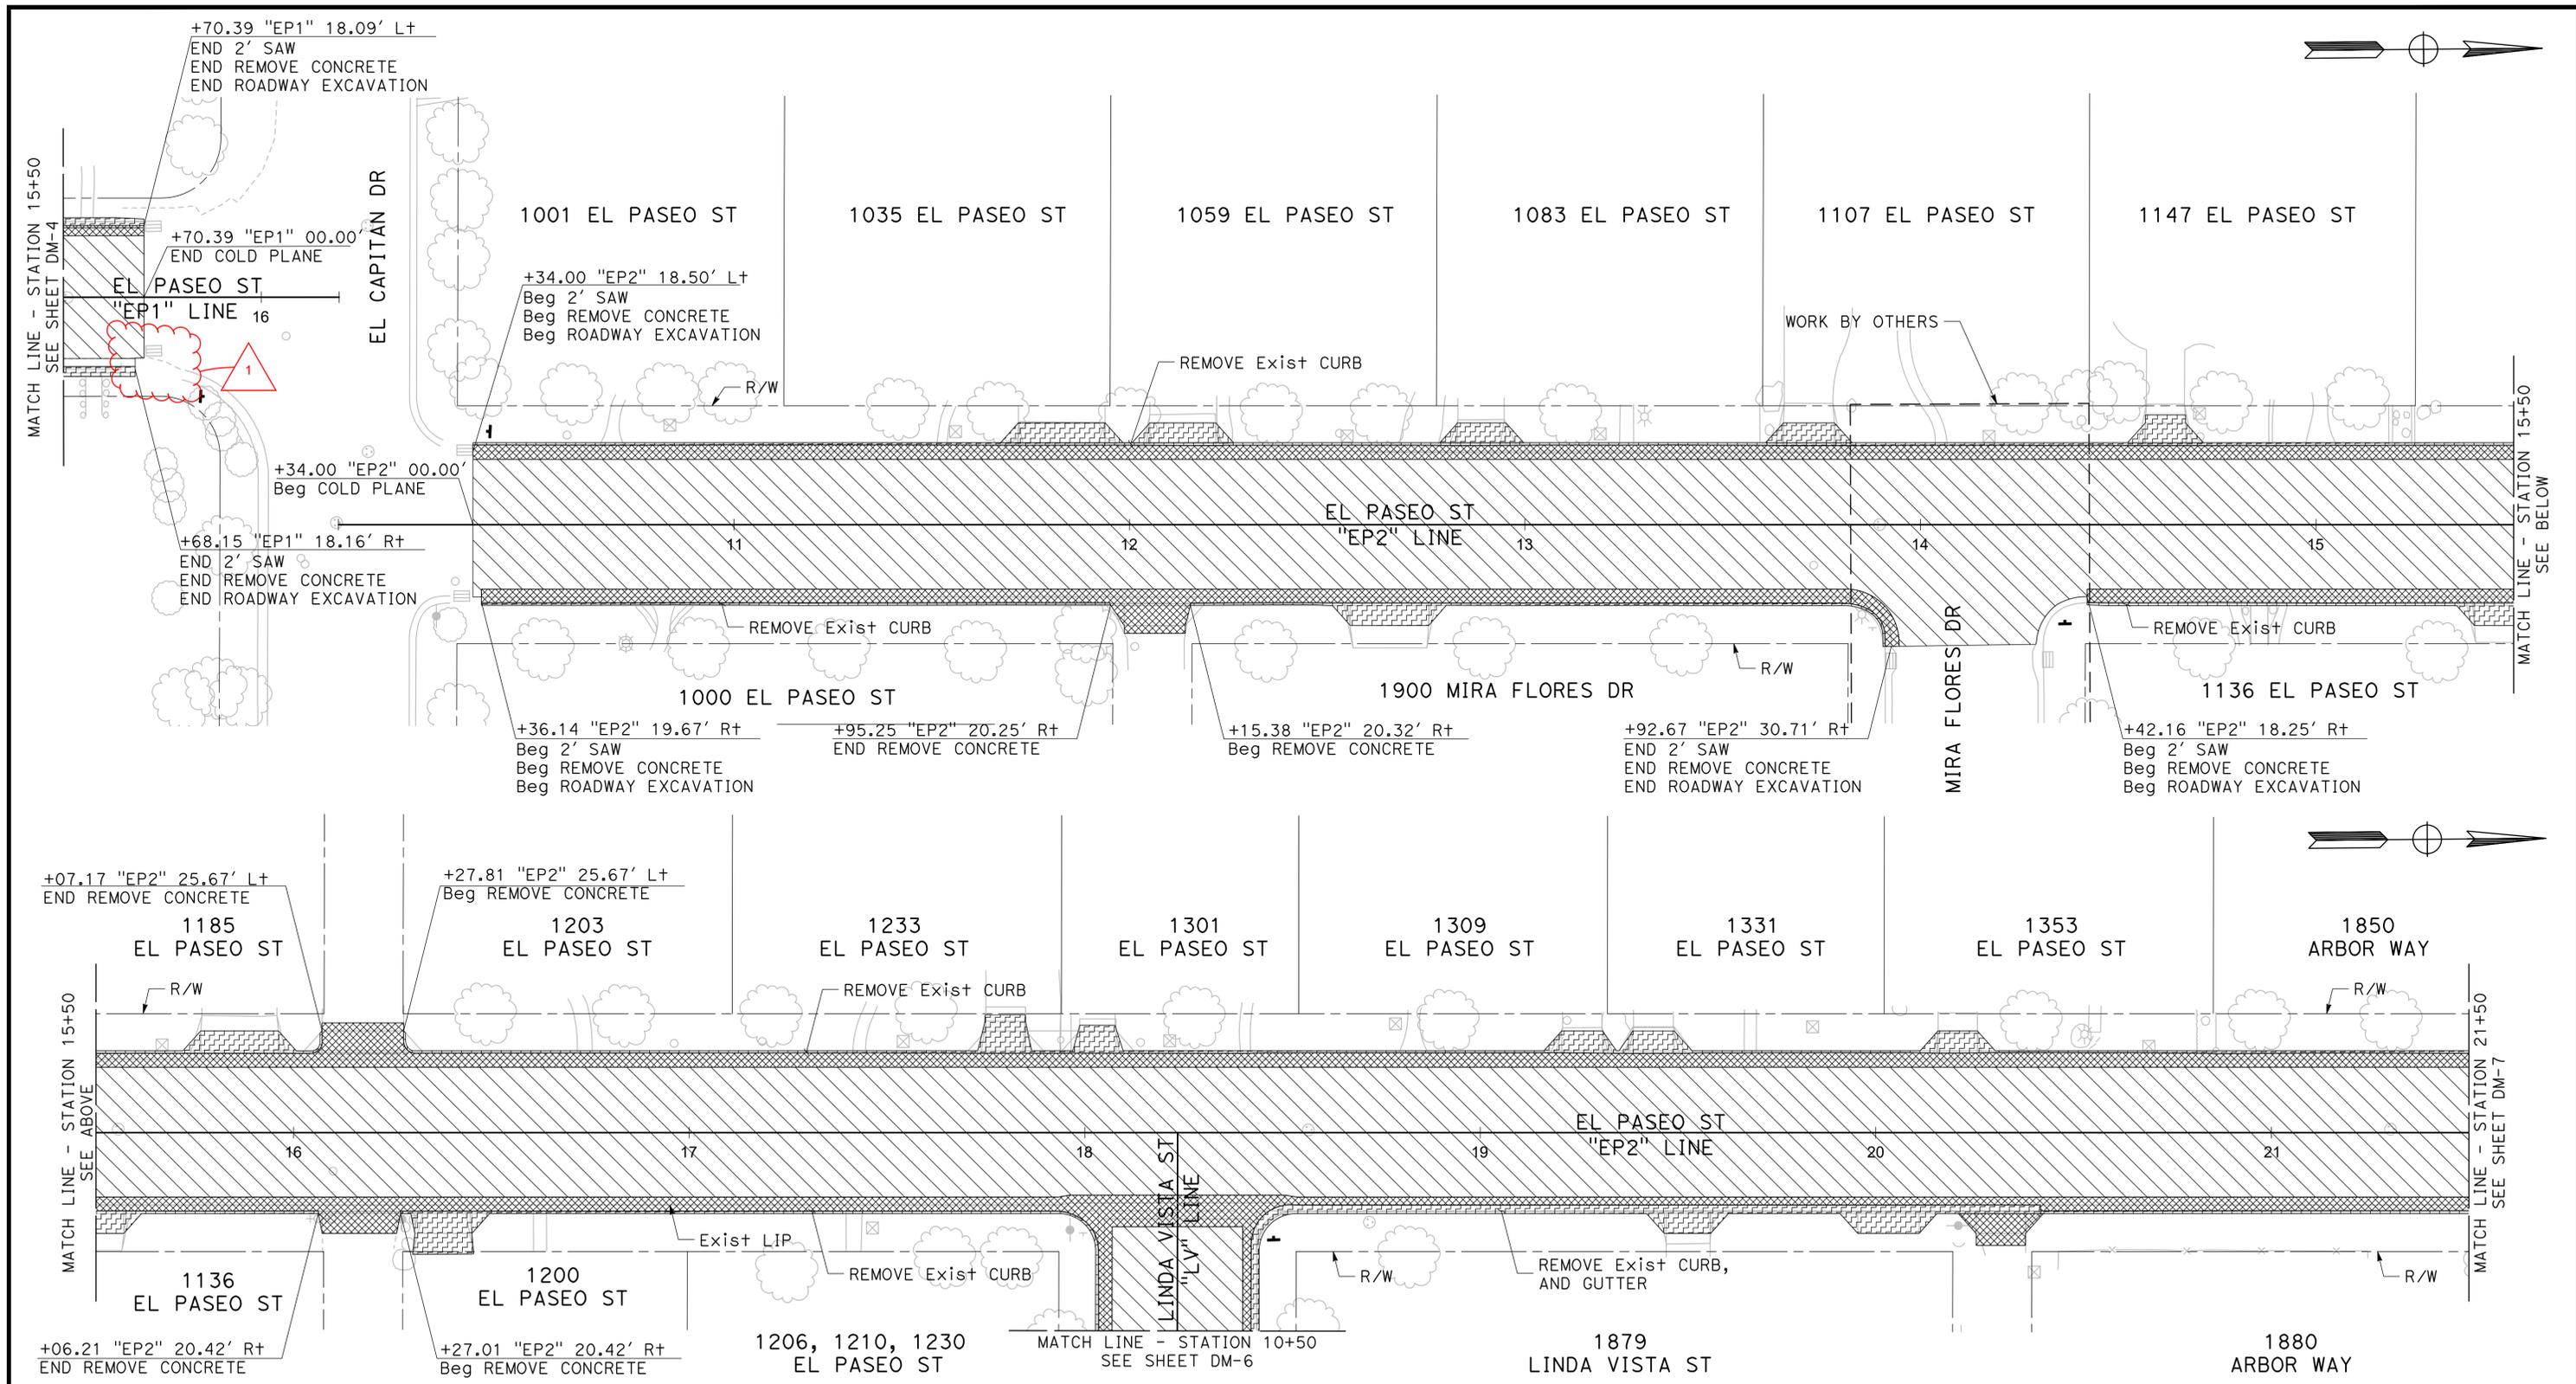

100% PLANS


DESIGNED BY: POORE, B.
 DRAWN BY: FRANCO, N.
 CHECKED BY: NORIEGA, E.
 SCALE: 1"=20'
 DATE: 5/21/2025
 JOB NO.: 24-00061

NOTE:
 ALL REFERENCES AND WRITTEN DIMENSIONS SHALL SUPERCEDE ALL SCALED DISTANCES AND SHALL BE VERIFIED IN THE FIELD. ANY DISCREPANCY SHALL BE BROUGHT TO THE ATTENTION OF THE ENGINEER PRIOR TO THE COMMENCEMENT OF WORK.




MARK THOMAS
 701 UNIVERSITY AVENUE, SUITE 200
 SACRAMENTO, CALIFORNIA 95825
 (916) 381-9100 FAX:(916)381-9180
 markthomas.com

CITY OF TURLOCK
 MUNICIPAL SERVICES
 DEPARTMENT
 156 S. BROADWAY
 SUITE 150
 (209) 668-5520

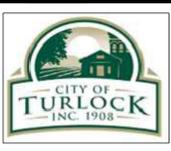

**CITY OF TURLOCK
 ROADS PROGRAM CIP
 PROJECT 23-067 PACKAGE #3
 DEMOLITION PLANS**


Sheet **14**
 of
126 Sheets
DM-5

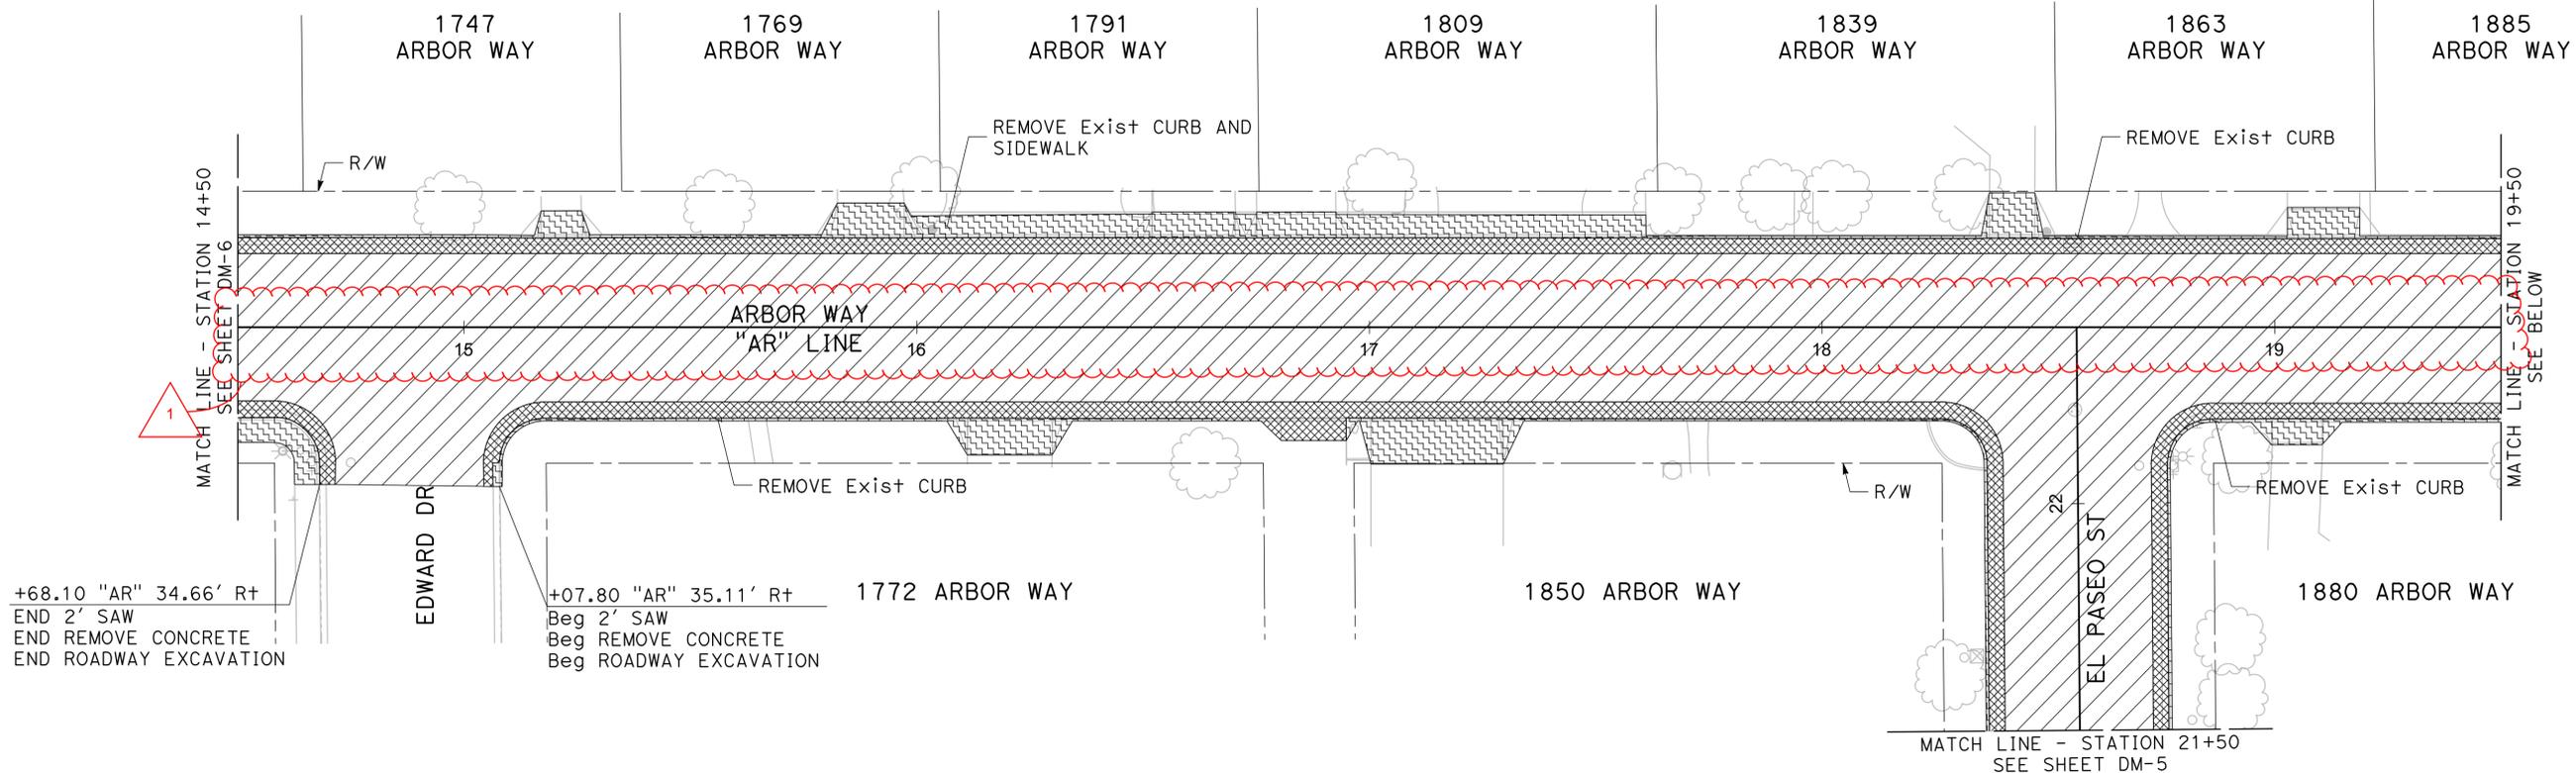

+68.10 "AR" 34.66' Rt
 END 2' SAW
 END REMOVE CONCRETE
 END ROADWAY EXCAVATION

+07.80 "AR" 35.11' Rt
 Beg 2' SAW
 Beg REMOVE CONCRETE
 Beg ROADWAY EXCAVATION

MATCH LINE - STATION 21+50
 SEE SHEET DM-5

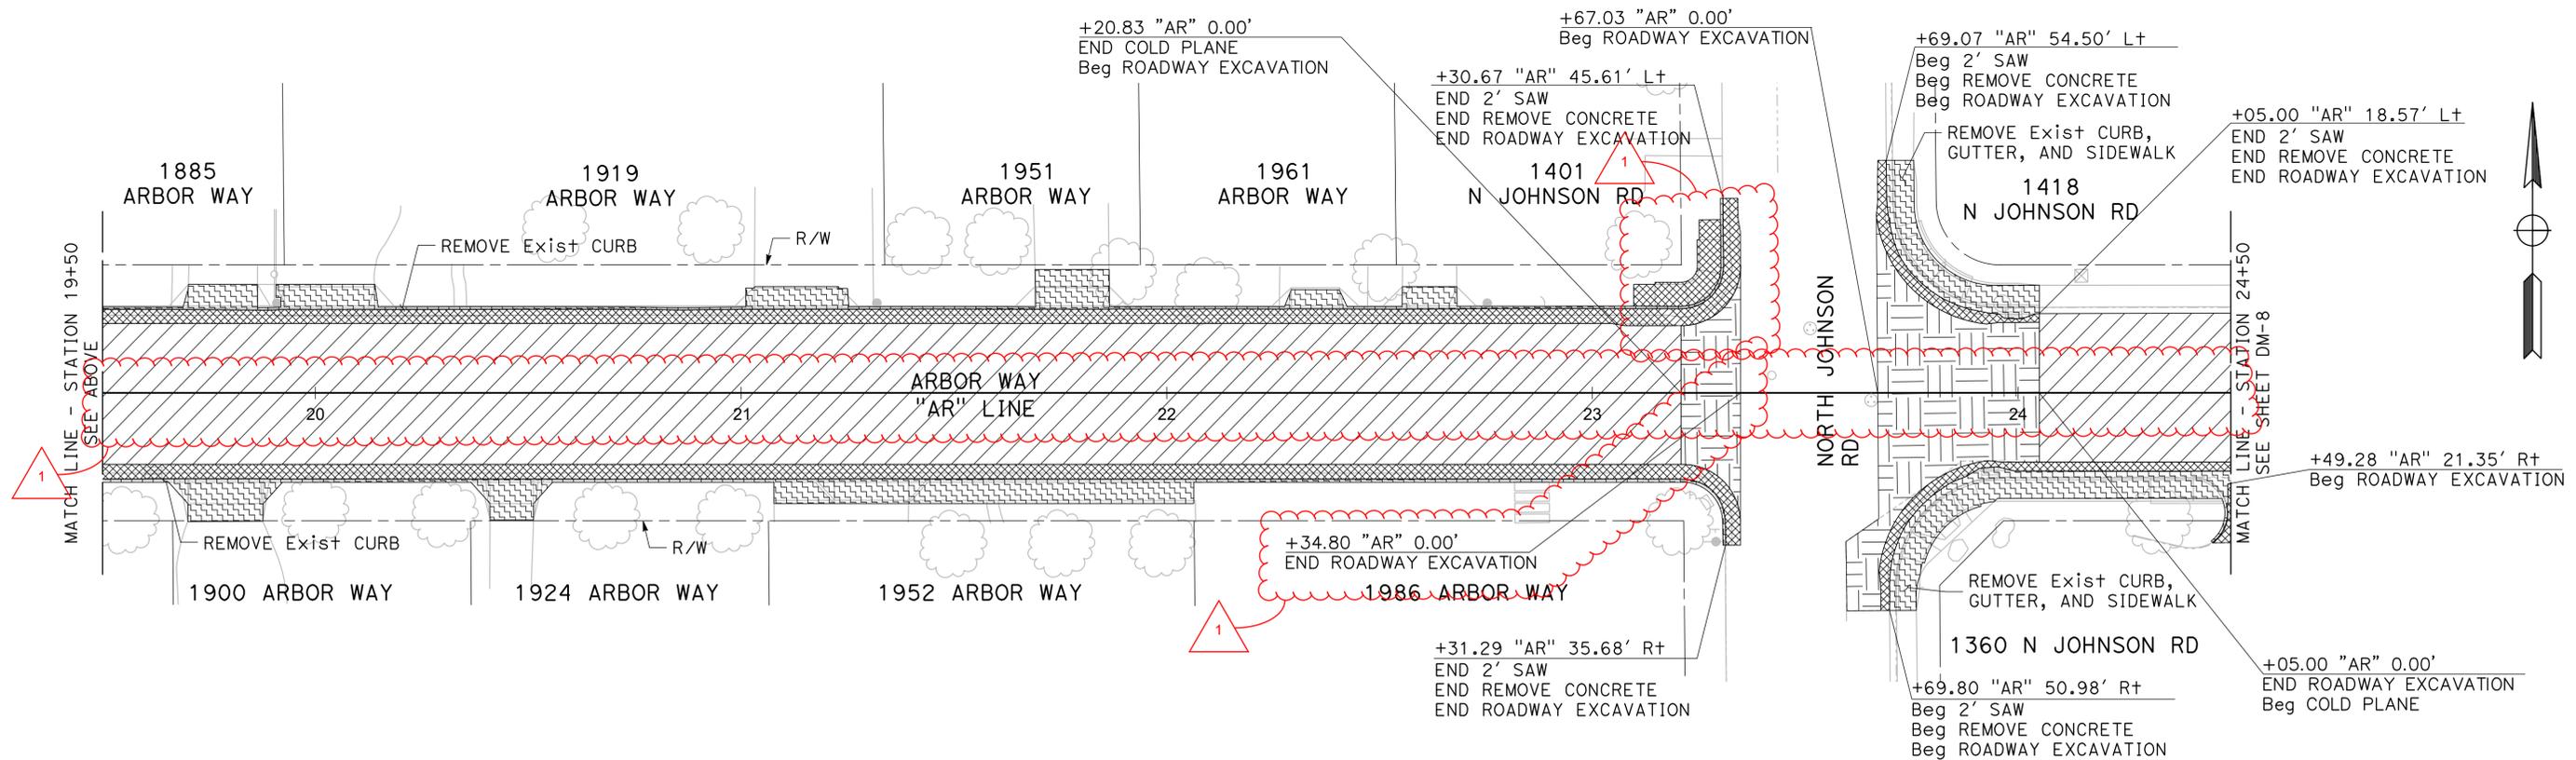

+20.83 "AR" 0.00'
 END COLD PLANE
 Beg ROADWAY EXCAVATION

+30.67 "AR" 45.61' Lt
 END 2' SAW
 END REMOVE CONCRETE
 END ROADWAY EXCAVATION

+69.07 "AR" 54.50' Lt
 Beg 2' SAW
 Beg REMOVE CONCRETE
 Beg ROADWAY EXCAVATION

+05.00 "AR" 18.57' Lt
 END 2' SAW
 END REMOVE CONCRETE
 END ROADWAY EXCAVATION

+34.80 "AR" 0.00'
 END ROADWAY EXCAVATION

+31.29 "AR" 35.68' Rt
 END 2' SAW
 END REMOVE CONCRETE
 END ROADWAY EXCAVATION

+69.80 "AR" 50.98' Rt
 Beg 2' SAW
 Beg REMOVE CONCRETE
 Beg ROADWAY EXCAVATION


+49.28 "AR" 21.35' Rt
 Beg ROADWAY EXCAVATION

+05.00 "AR" 0.00'
 END ROADWAY EXCAVATION
 Beg COLD PLANE

100% PLANS

DESIGNED BY: POORE, B.
 DRAWN BY: FRANCO, N.
 CHECKED BY: NORIEGA, E.
 SCALE: 1"=20'
 DATE: 5/21/2025
 JOB NO.: 24-00061

NOTE:
 ALL REFERENCES AND WRITTEN DIMENSIONS SHALL SUPERCEDE ALL SCALED DISTANCES AND SHALL BE VERIFIED IN THE FIELD. ANY DISCREPANCY SHALL BE BROUGHT TO THE ATTENTION OF THE ENGINEER PRIOR TO THE COMMENCEMENT OF WORK.

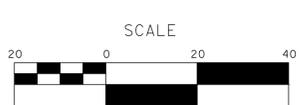


MARK THOMAS
 701 UNIVERSITY AVENUE, SUITE 200
 SACRAMENTO, CALIFORNIA 95825
 (916) 381-9100 FAX:(916)381-9180
 markthomas.com

CITY OF TURLOCK
 MUNICIPAL SERVICES
 DEPARTMENT
 156 S. BROADWAY
 SUITE 150
 (209) 668-5520




**CITY OF TURLOCK
 ROADS PROGRAM CIP
 PROJECT 23-067 PACKAGE #3
 DEMOLITION PLANS**

Sheet **16**
 of
126 Sheets
DM-7

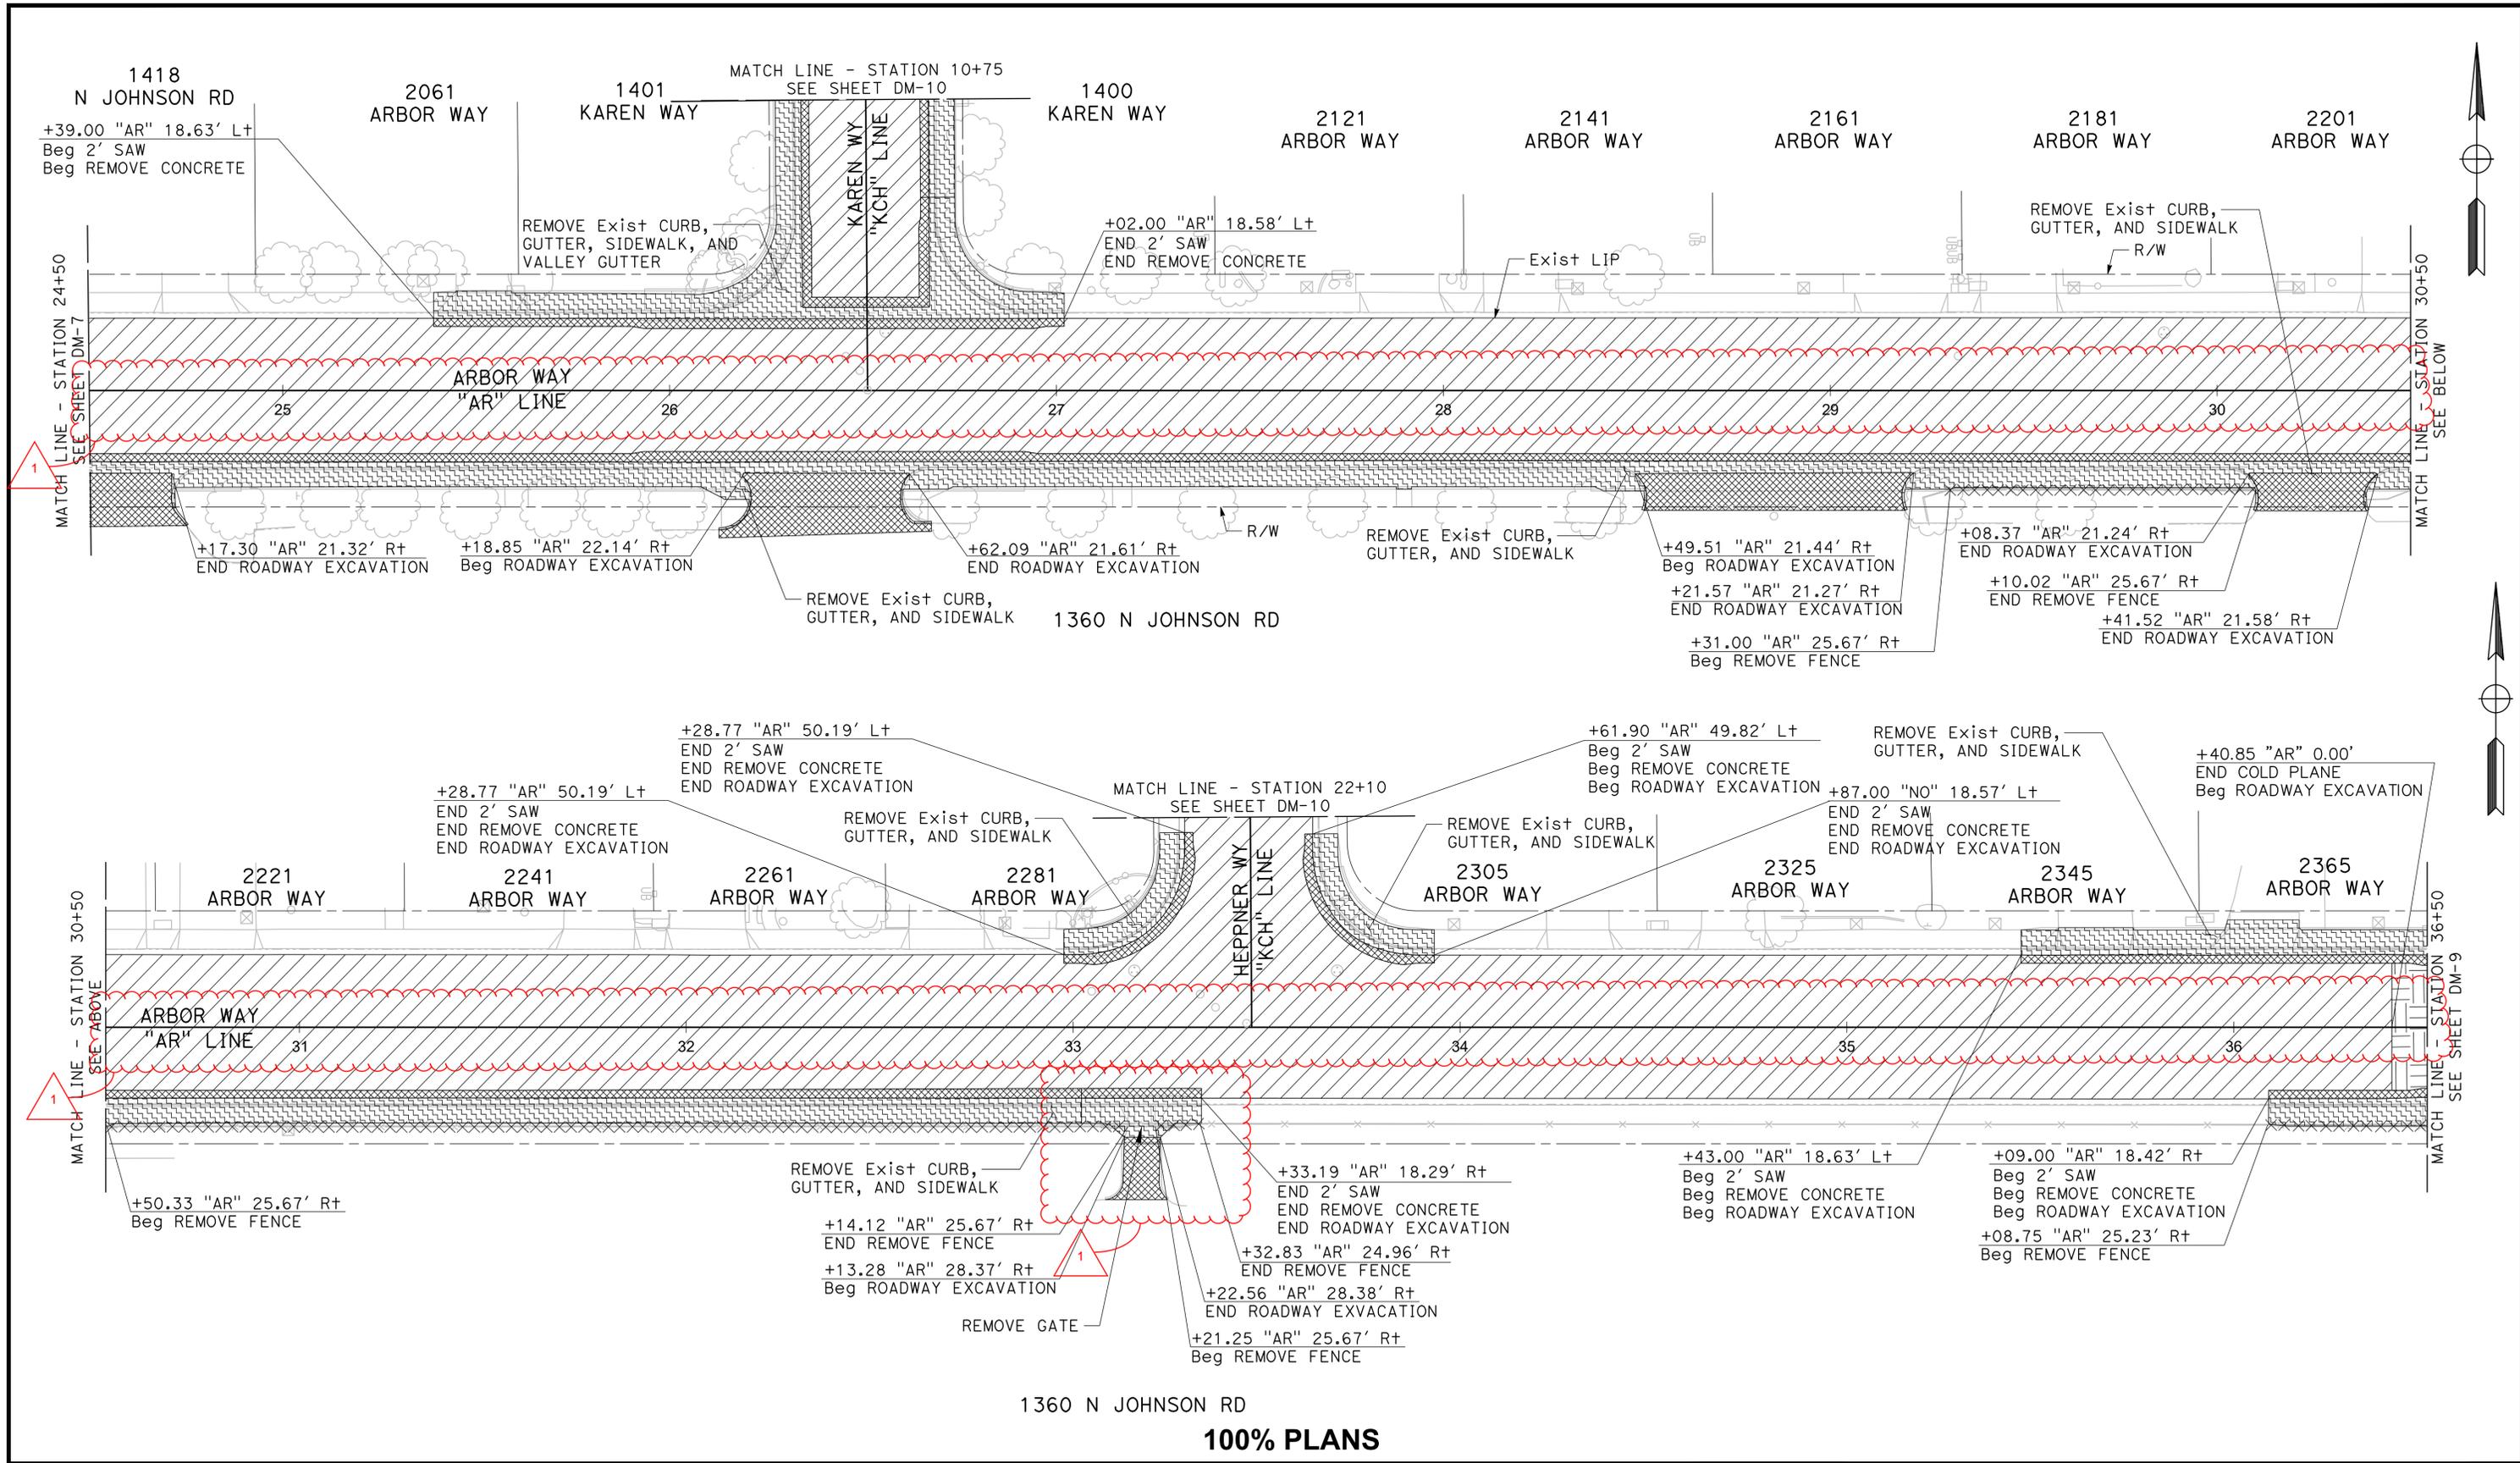

DESIGNED BY: POORE, B.
 DRAWN BY: FRANCO, N.
 CHECKED BY: NORIEGA, E.
 SCALE: 1"=20'
 DATE: 5/21/2025
 JOB NO.: 24-00061

NOTE:
 ALL REFERENCES AND WRITTEN DIMENSIONS SHALL SUPERCEDE ALL SCALED DISTANCES AND SHALL BE VERIFIED IN THE FIELD. ANY DISCREPANCY SHALL BE BROUGHT TO THE ATTENTION OF THE ENGINEER PRIOR TO THE COMMENCEMENT OF WORK.

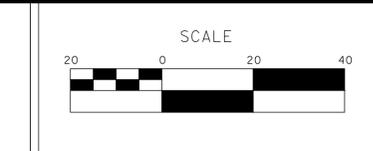


MARK THOMAS
 701 UNIVERSITY AVENUE, SUITE 200
 SACRAMENTO, CALIFORNIA 95825
 (916) 381-9100 FAX:(916)381-9180
 markthomas.com

CITY OF TURLOCK
 MUNICIPAL SERVICES DEPARTMENT
 156 S. BROADWAY SUITE 150
 (209) 668-5520


**CITY OF TURLOCK
 ROADS PROGRAM CIP
 PROJECT 23-067 PACKAGE #3
 DEMOLITION PLANS**

Sheet **17**
 of **126** Sheets
DM-8

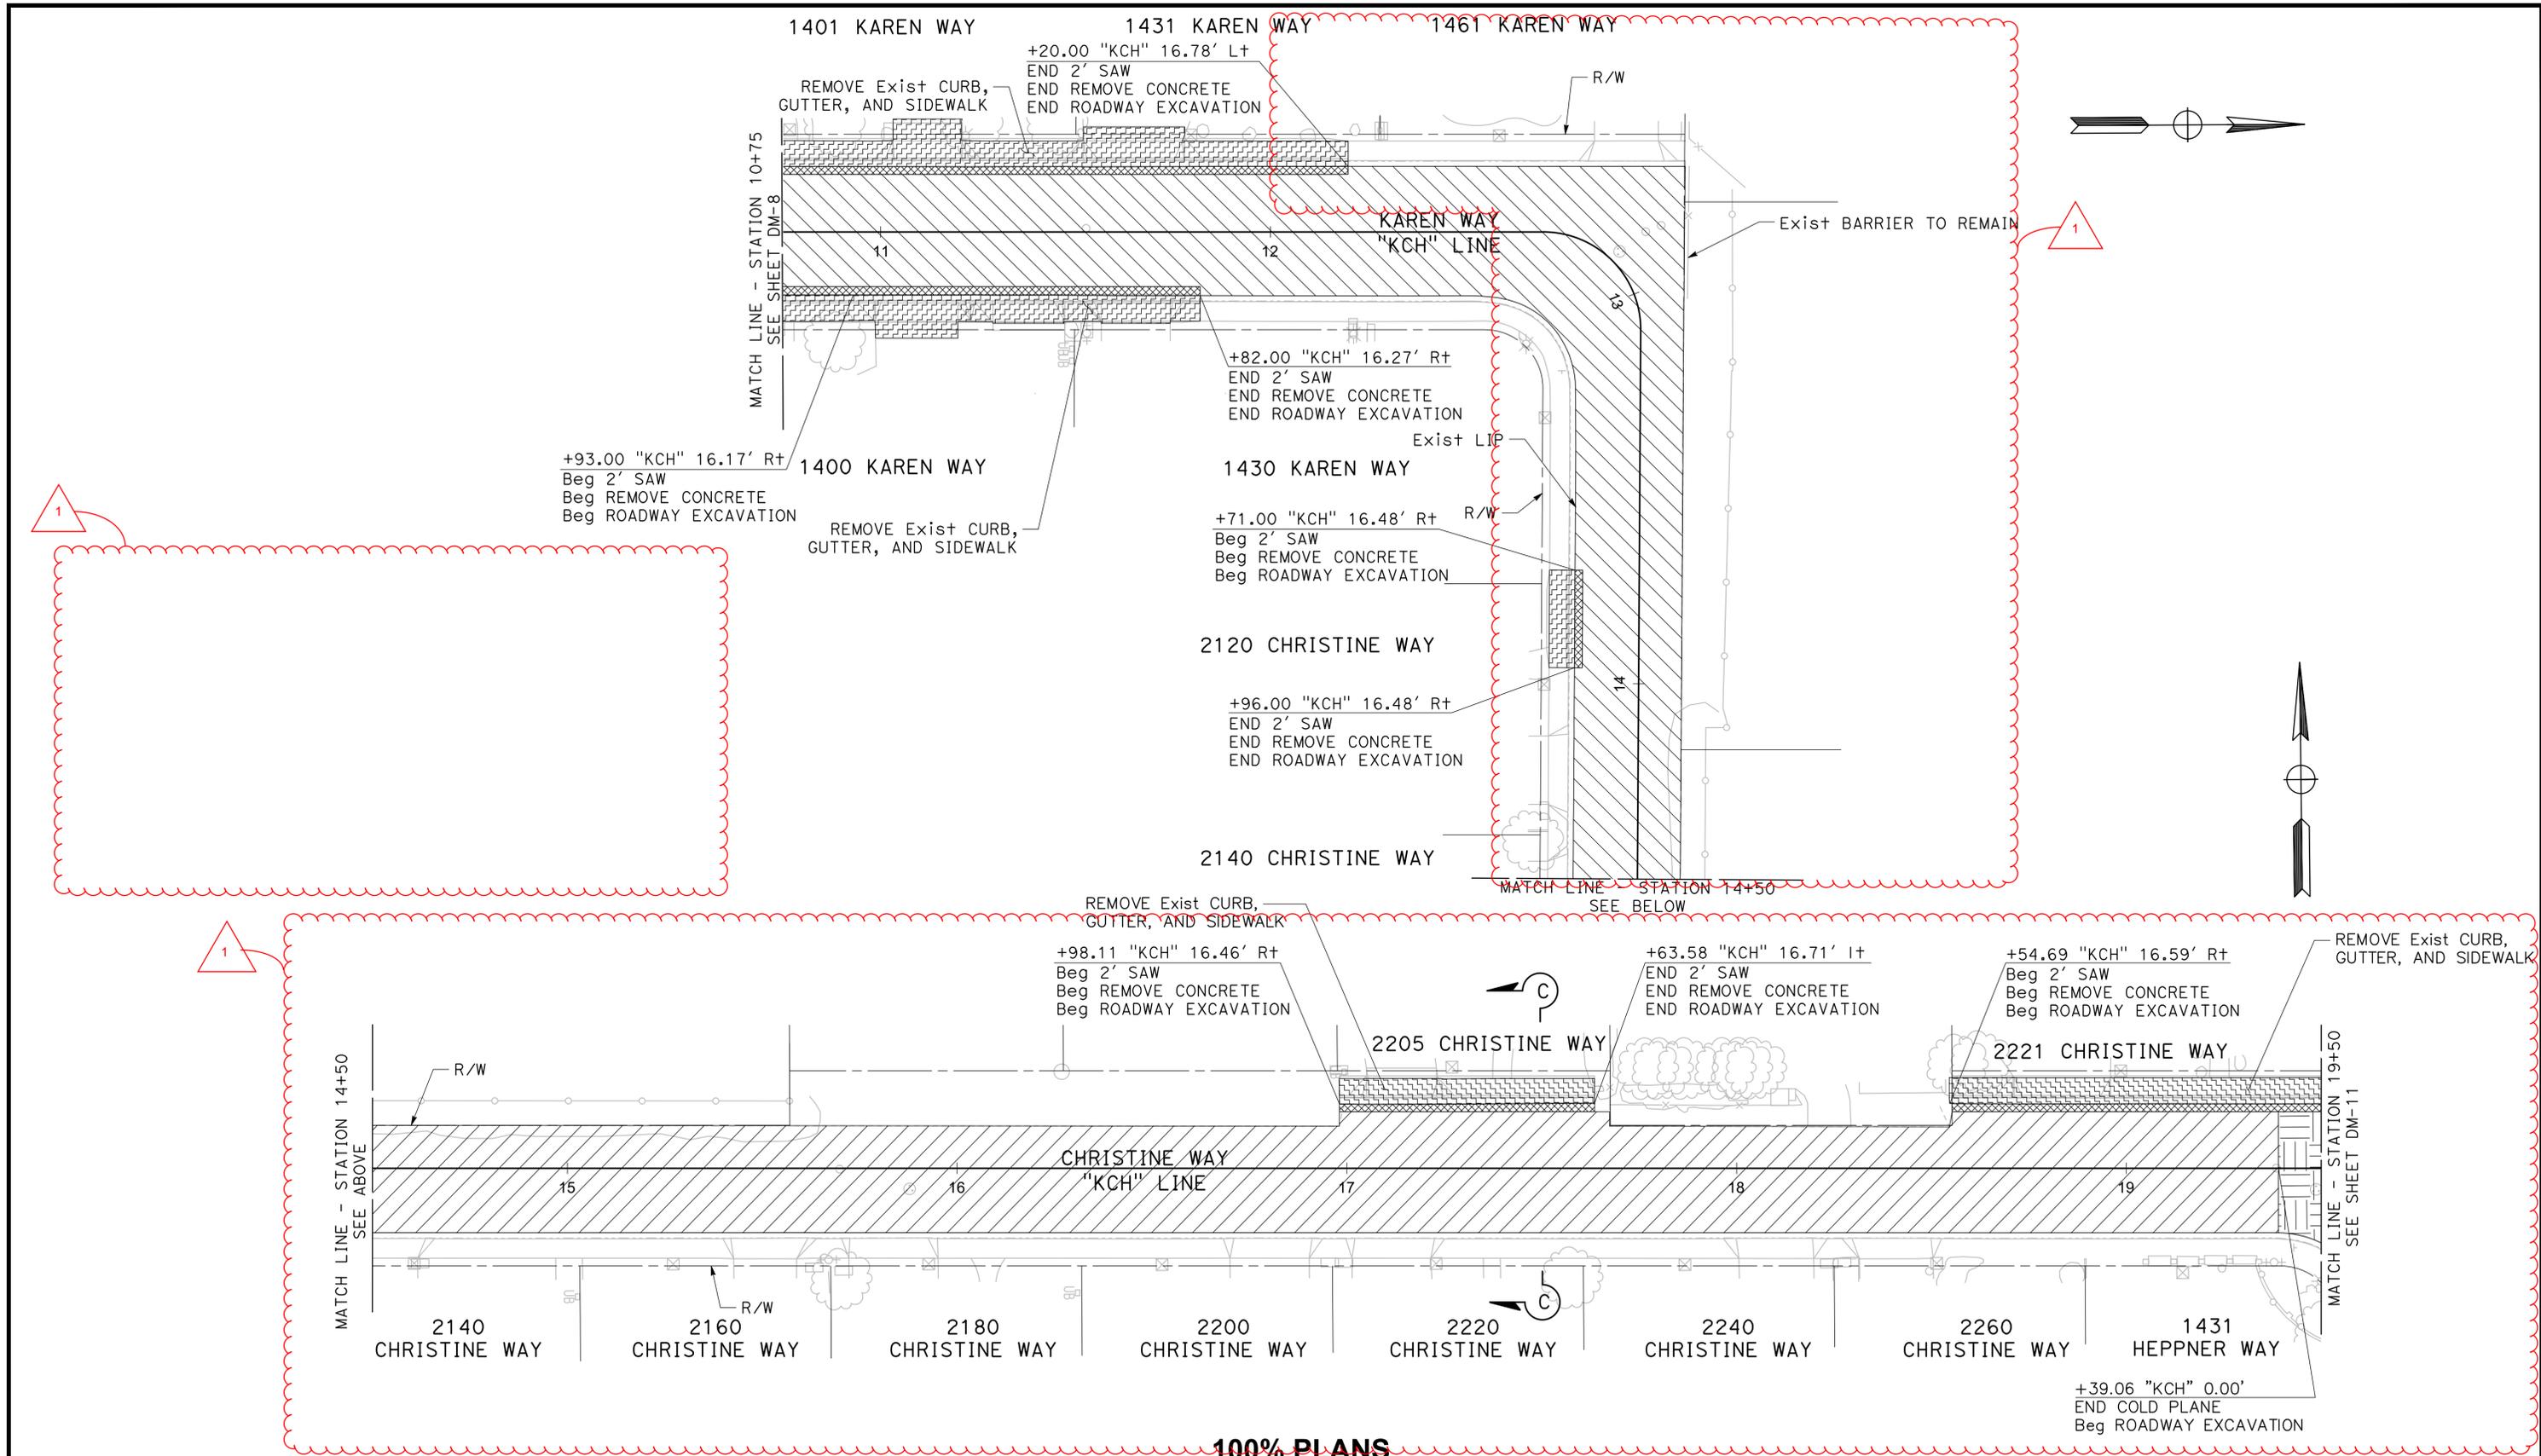

DESIGNED BY: POORE, B.
 DRAWN BY: FRANCO, N.
 CHECKED BY: NORIEGA, E.
 SCALE: 1"=20'
 DATE: 5/21/2025
 JOB NO.: 24-00061

NOTE:
 ALL REFERENCES AND WRITTEN DIMENSIONS SHALL SUPERCEDE ALL SCALED DISTANCES AND SHALL BE VERIFIED IN THE FIELD. ANY DISCREPANCY SHALL BE BROUGHT TO THE ATTENTION OF THE ENGINEER PRIOR TO THE COMMENCEMENT OF WORK.

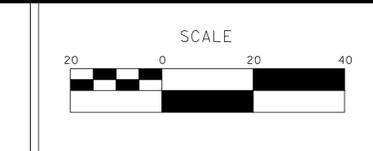




MARK THOMAS
 701 UNIVERSITY AVENUE, SUITE 200
 SACRAMENTO, CALIFORNIA 95825
 (916) 381-9100 FAX:(916)381-9180
 markthomas.com

CITY OF TURLOCK
 MUNICIPAL SERVICES
 DEPARTMENT
 156 S. BROADWAY
 SUITE 150
 (209) 668-5520



CITY OF TURLOCK
ROADS PROGRAM CIP
PROJECT 23-067 PACKAGE #3
DEMOLITION SHEETS


Sheet **19**
 of
126 Sheets
DM-10

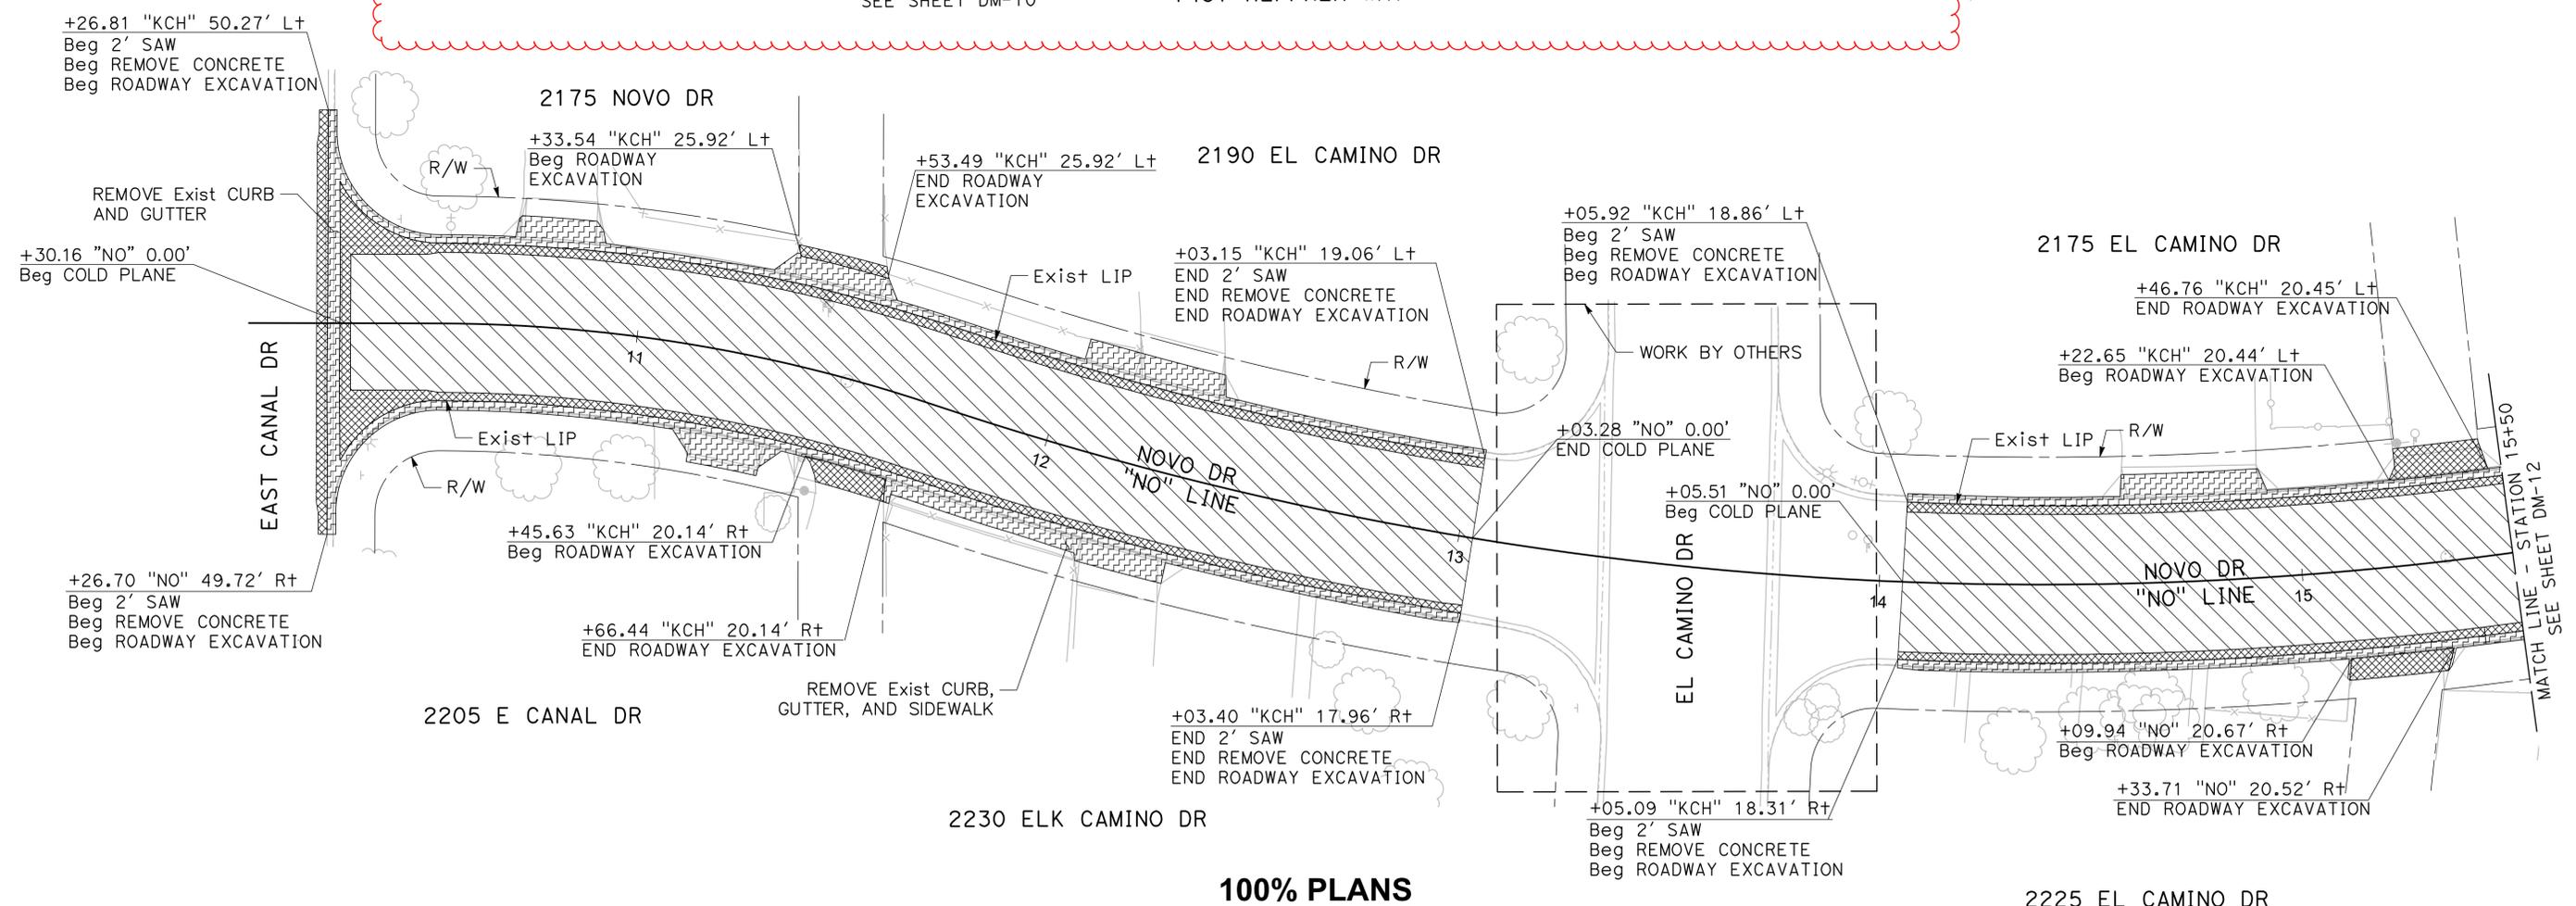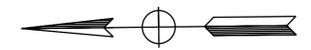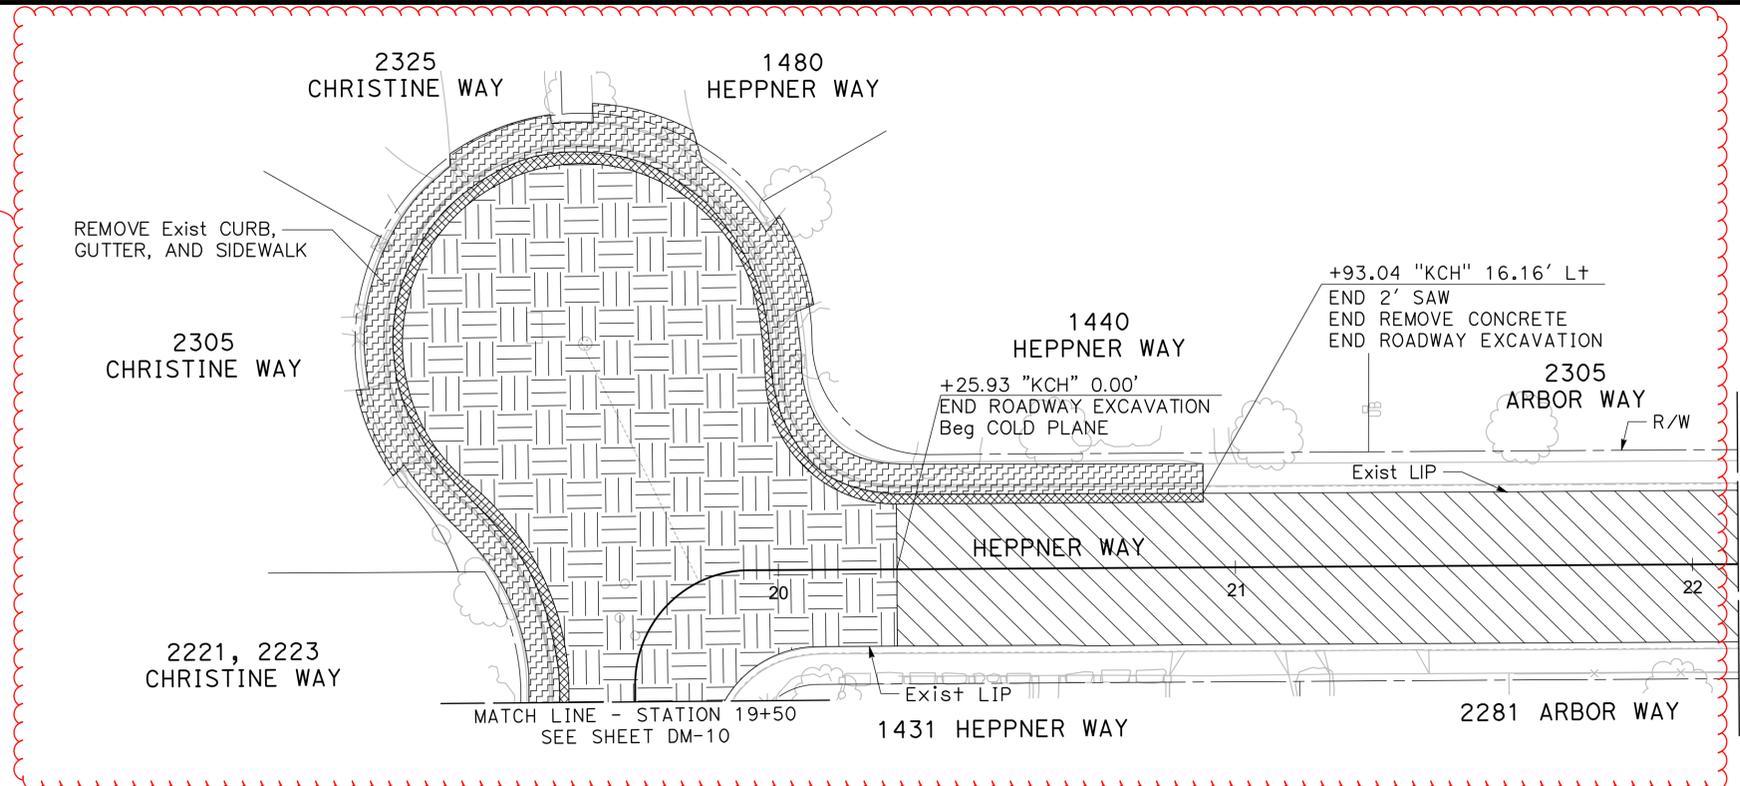

100% PLANS

DESIGNED BY: POORE, B.
DRAWN BY: FRANCO, N.
CHECKED BY: NORIEGA, E.
SCALE: 1"=20'
DATE: 5/21/2025
JOB NO.: 24-00061

NOTE:
ALL REFERENCES AND WRITTEN DIMENSIONS SHALL SUPERCEDE ALL SCALED DISTANCES AND SHALL BE VERIFIED IN THE FIELD. ANY DISCREPANCY SHALL BE BROUGHT TO THE ATTENTION OF THE ENGINEER PRIOR TO THE COMMENCEMENT OF WORK.

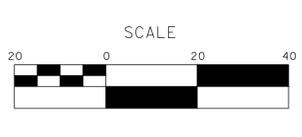

MARK THOMAS
701 UNIVERSITY AVENUE, SUITE 200
SACRAMENTO, CALIFORNIA 95825
(916) 381-9100 FAX:(916)381-9180
markthomas.com

CITY OF TURLOCK
MUNICIPAL SERVICES DEPARTMENT
156 S. BROADWAY
SUITE 150
(209) 668-5520







**CITY OF TURLOCK
ROADS PROGRAM CIP
PROJECT 23-067 PACKAGE #3
DEMOLITION SHEETS**

Sheet **20**
of
126 Sheets
DM-11

NOTES (L-1 TO L-15):

- SEE TYPICAL SECTION SHEETS FOR SECTION DEPTHS
- SEE DRAINAGE AND UTILITIES SHEETS FOR DRAINAGE NOTES AND MODIFICATIONS


LEGEND (L-1 TO L-15):

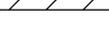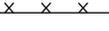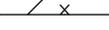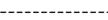-  DETECTABLE WARNING SURFACE
-  MINOR CONCRETE
-  HMA DRIVEWAY CONFORMS (4" HMA (TYPE A) OVER 6" AB (CLASS 2))
-  LIMITS OF PAVEMENT RECONSTRUCTION (FDR TI = 6, SEE TYPICAL SECTIONS)
-  LIMITS OF PAVEMENT RECONSTRUCTION (FDR TI = 8, SEE TYPICAL SECTIONS)
-  LIMITS OF PAVEMENT RECONSTRUCTION (FULL DEPTH HMA TI = 6, SEE TYPICAL SECTIONS, 0.65' HMA (TYPE A))
-  LIMITS OF PAVEMENT RECONSTRUCTION (FULL DEPTH HMA TI = 8, SEE TYPICAL SECTIONS, 0.85' HMA (TYPE A))
-  SAWCUT
-  PROPOSED FLOWLINE
-  CROWN

CONSTRUCTION NOTES (L-1 TO L-15):

- VALLEY GUTTER PER CITY OF TURLOCK STD DWG C-1
- DW # RESIDENTIAL DRIVEWAY APPROACH PER CITY OF TURLOCK STD DWY C-5 (Mod)
- CURB RAMP PER CITY OF TURLOCK STD DWG C-11
- CURB RAMP PER CITY OF TURLOCK STD DWG C-12
- CURB RAMP PER CITY OF TURLOCK STD DWG C-13
- DW # ALLEY APPROACH PER CITY OF TURLOCK STD DWG C-7 (Mod)
- COMMERCIAL DRIVEWAY APPROACH PER CITY OF TURLOCK STD DWG C-8
- MODIFIED DRIVE-OVER CURB AND GUTTER (SEE CD-13)
- REMOVE AND REPLACE MONUMENT
- 6" CURB AND GUTTER (CITY STANDARD C-1)
- DRIVE-OVER CURB AND GUTTER (SEE CD-13)
- COMMERCIAL DRIVEWAY APPROACH PER CITY OF TURLOCK STD DWG C-9


ALIGNMENT LINE TABLE		
LINE #	LENGTH	DIRECTION
L1	550.00'	N0°18'58"E
L2	660.96'	S89°30'06"E

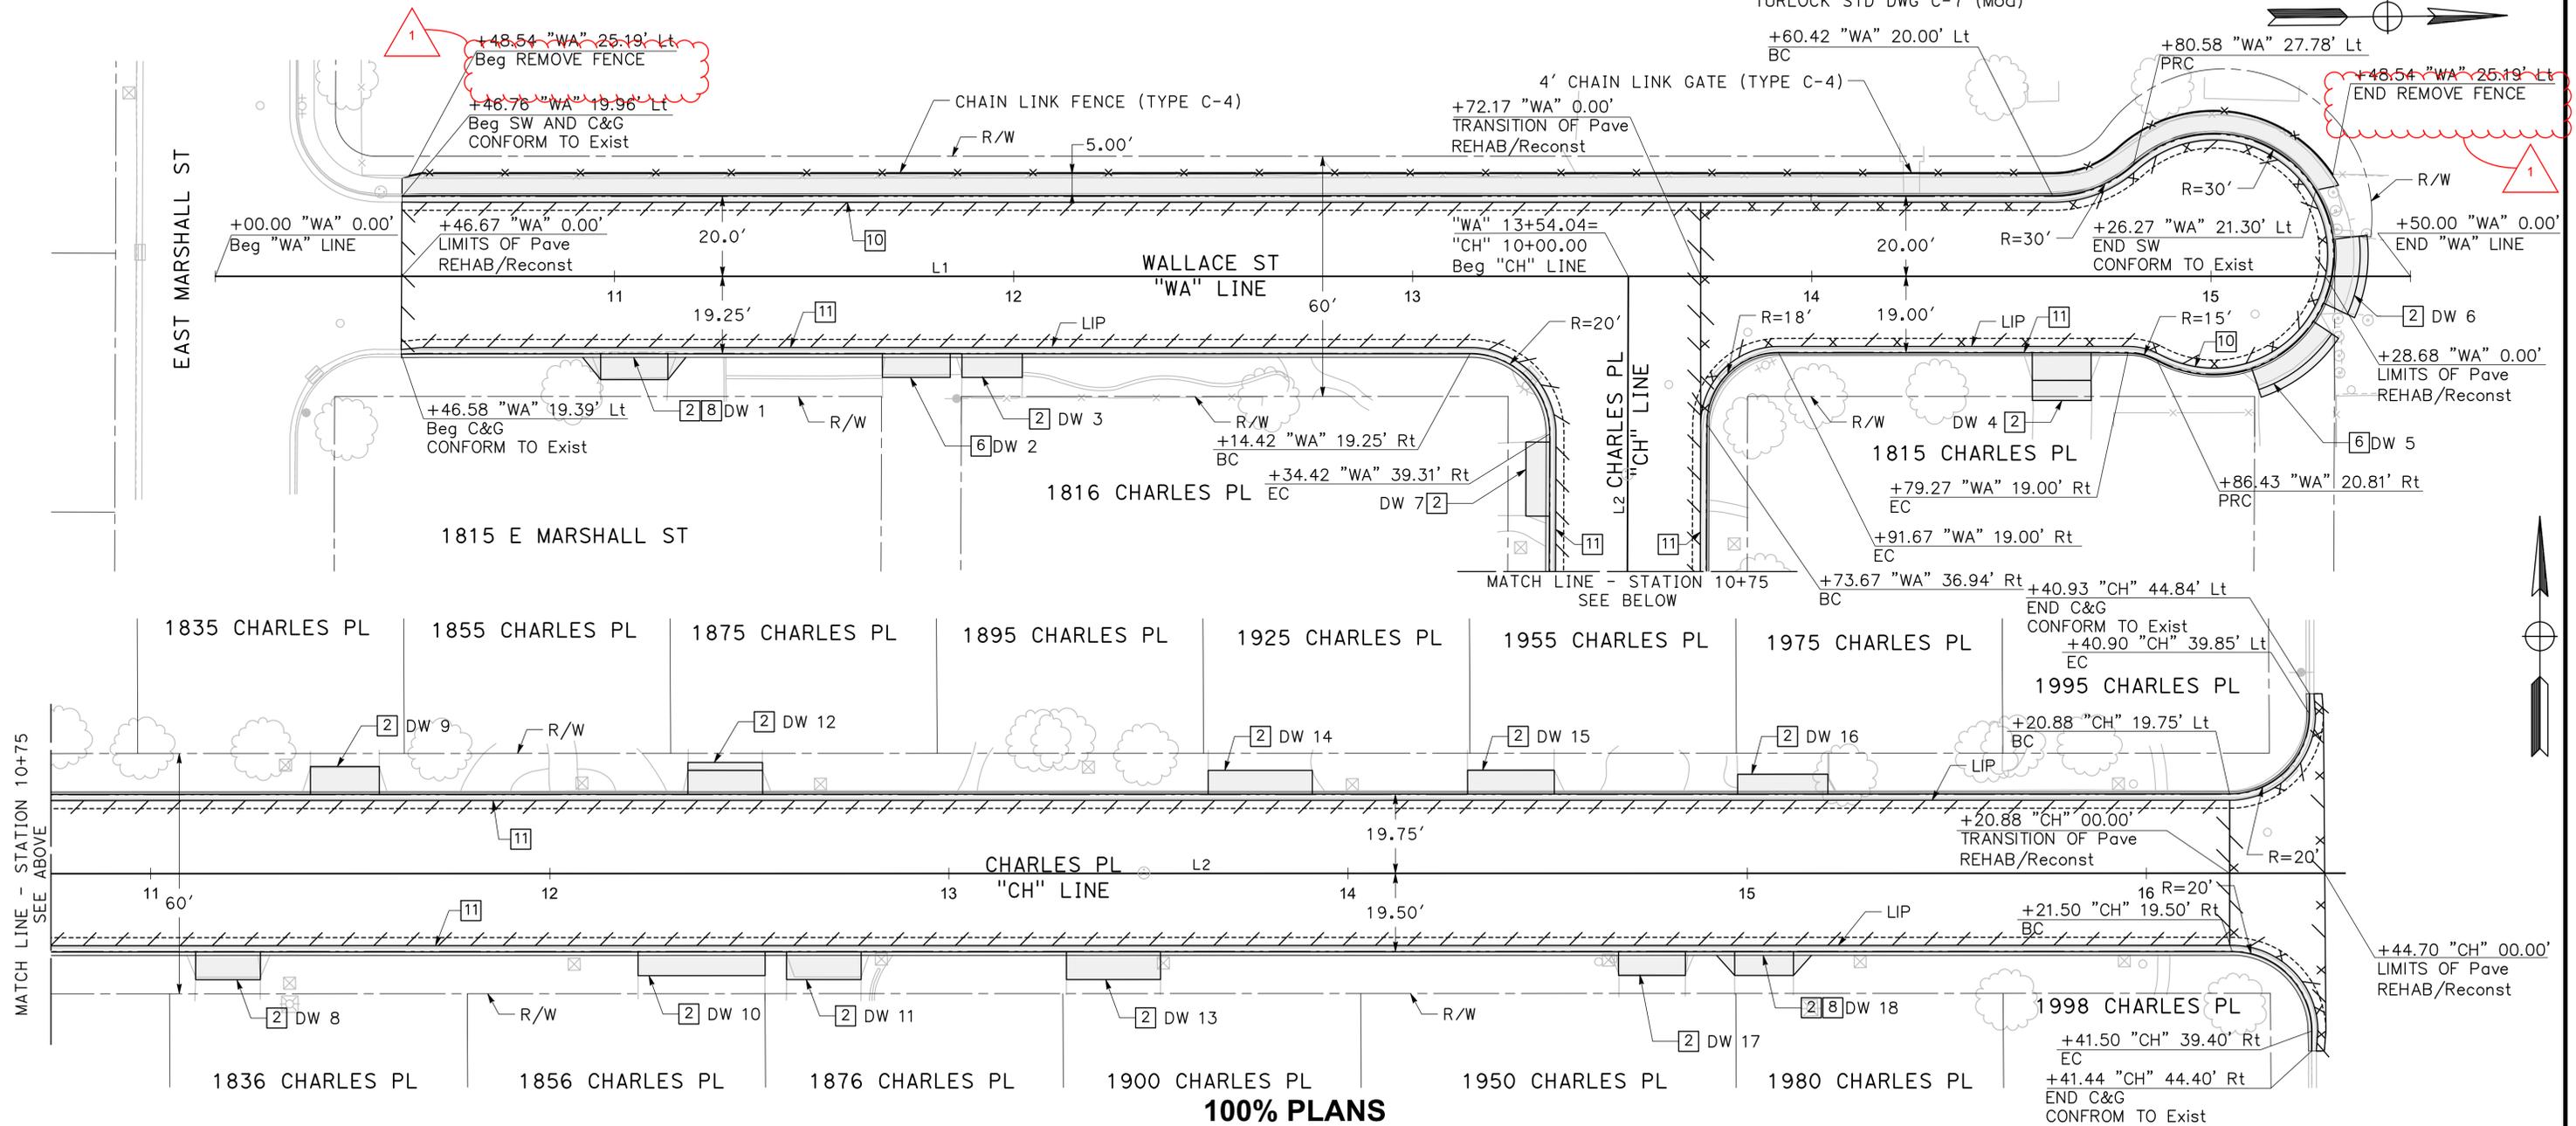

100% PLANS

DESIGNED BY: POORE, B.
 DRAWN BY: FRANCO, N.
 CHECKED BY: NORIEGA, E.
 SCALE: 1"=20'
 DATE: 5/21/2025
 JOB NO.: 24-00061

NOTE:
 ALL REFERENCES AND WRITTEN DIMENSIONS SHALL SUPERCEDE ALL SCALED DISTANCES AND SHALL BE VERIFIED IN THE FIELD. ANY DISCREPANCY SHALL BE BROUGHT TO THE ATTENTION OF THE ENGINEER PRIOR TO THE COMMENCEMENT OF WORK.

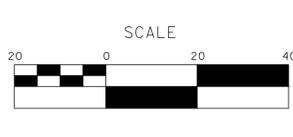

MARK THOMAS
 701 UNIVERSITY AVENUE, SUITE 200
 SACRAMENTO, CALIFORNIA 95825
 (916) 381-9100 FAX:(916)381-9180
 markthomas.com


CITY OF TURLOCK
 MUNICIPAL SERVICES
 DEPARTMENT
 156 S. BROADWAY
 SUITE 150
 (209) 668-5520



CITY OF TURLOCK
ROADS PROGRAM CIP
PROJECT 23-067 PACKAGE #3
LAYOUTS

Sheet **25**
 of
126 Sheets
L-1


ALIGNMENT LINE TABLE		
LINE #	LENGTH	DIRECTION
L7	619.71'	N0°12'33"E
L8	1238.89'	N0°13'07"E
L9	495.00'	S89°41'38"E

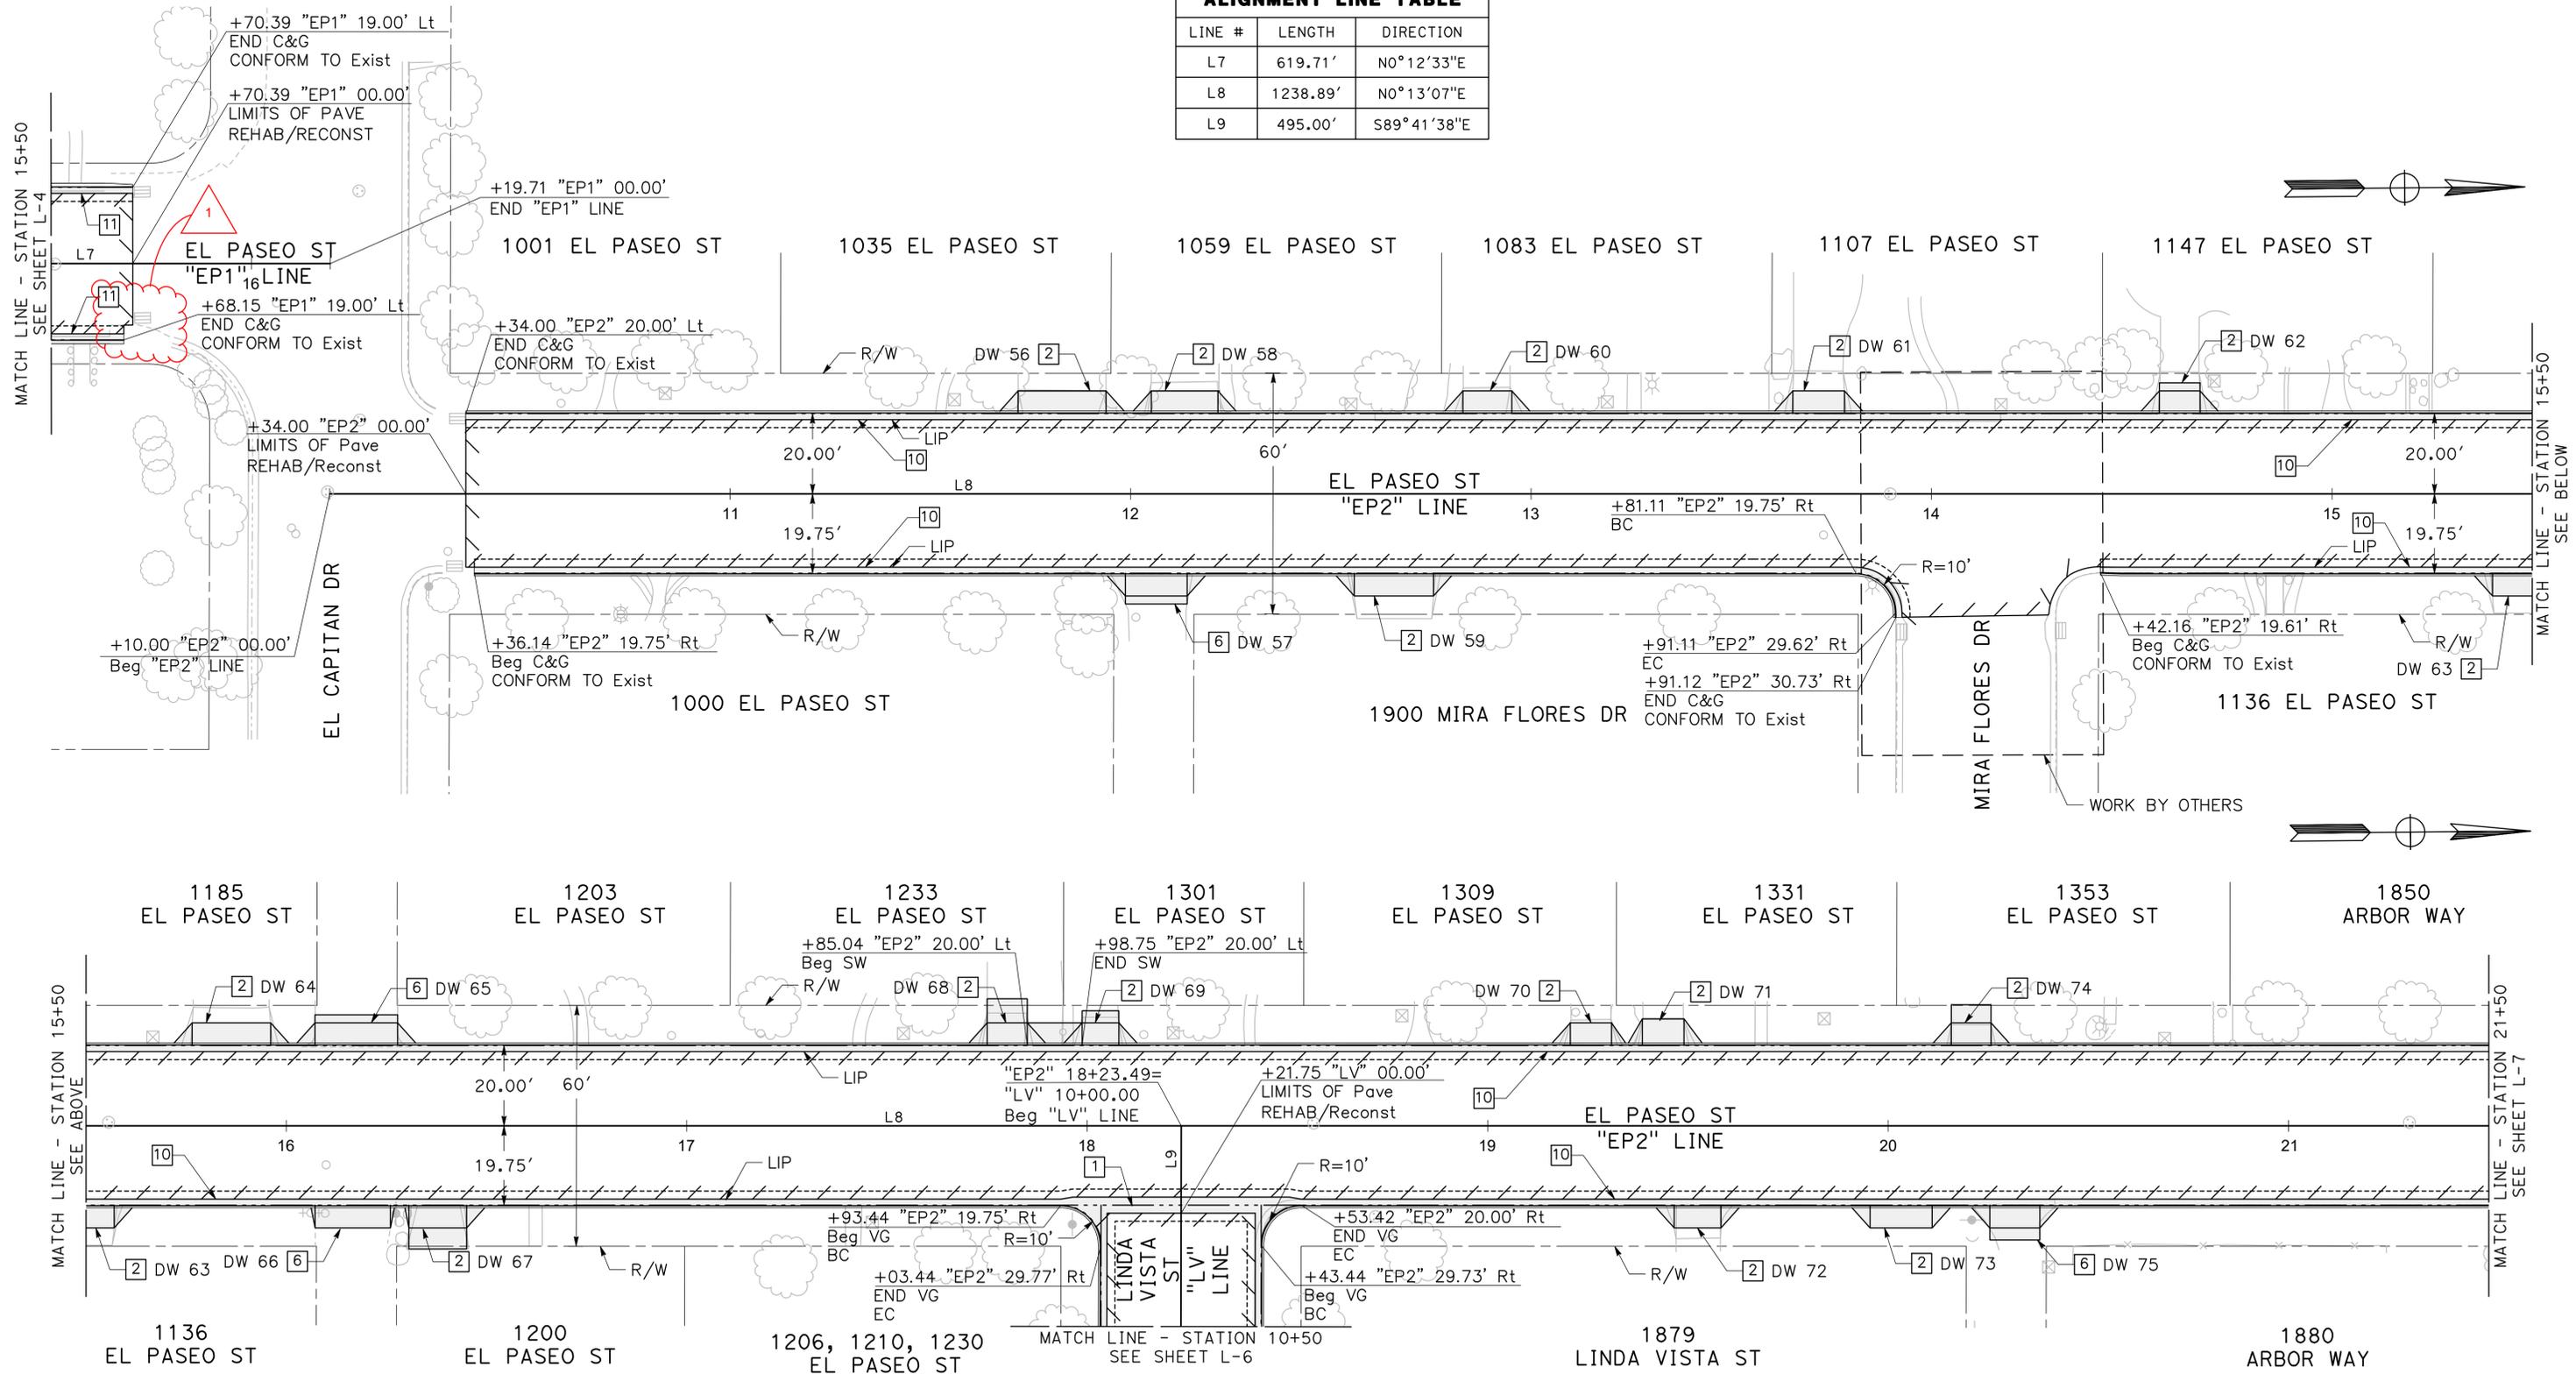

100% PLANS

DESIGNED BY: POORE, B.
 DRAWN BY: FRANCO, N.
 CHECKED BY: NORIEGA, E.
 SCALE: 1"=20'
 DATE: 5/21/2025
 JOB NO.: 24-00061

NOTE:
 ALL REFERENCES AND WRITTEN DIMENSIONS SHALL SUPERCEDE ALL SCALED DISTANCES AND SHALL BE VERIFIED IN THE FIELD. ANY DISCREPANCY SHALL BE BROUGHT TO THE ATTENTION OF THE ENGINEER PRIOR TO THE COMMENCEMENT OF WORK.

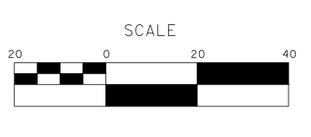

MARK THOMAS
 701 UNIVERSITY AVENUE, SUITE 200
 SACRAMENTO, CALIFORNIA 95825
 (916) 381-9100 FAX:(916)381-9180
 markthomas.com


CITY OF TURLOCK
 MUNICIPAL SERVICES DEPARTMENT
 156 S. BROADWAY
 SUITE 150
 (209) 668-5520



CITY OF TURLOCK
ROADS PROGRAM CIP
PROJECT 23-067 PACKAGE #3
LAYOUTS

Sheet **29**
 of **126** Sheets
L-5


ALIGNMENT LINE TABLE		
LINE #	LENGTH	DIRECTION
L8	1238.89'	N0°13'07"E
L10	1351.20'	S89°18'50"E
L11	1349.22'	S89°19'58"E

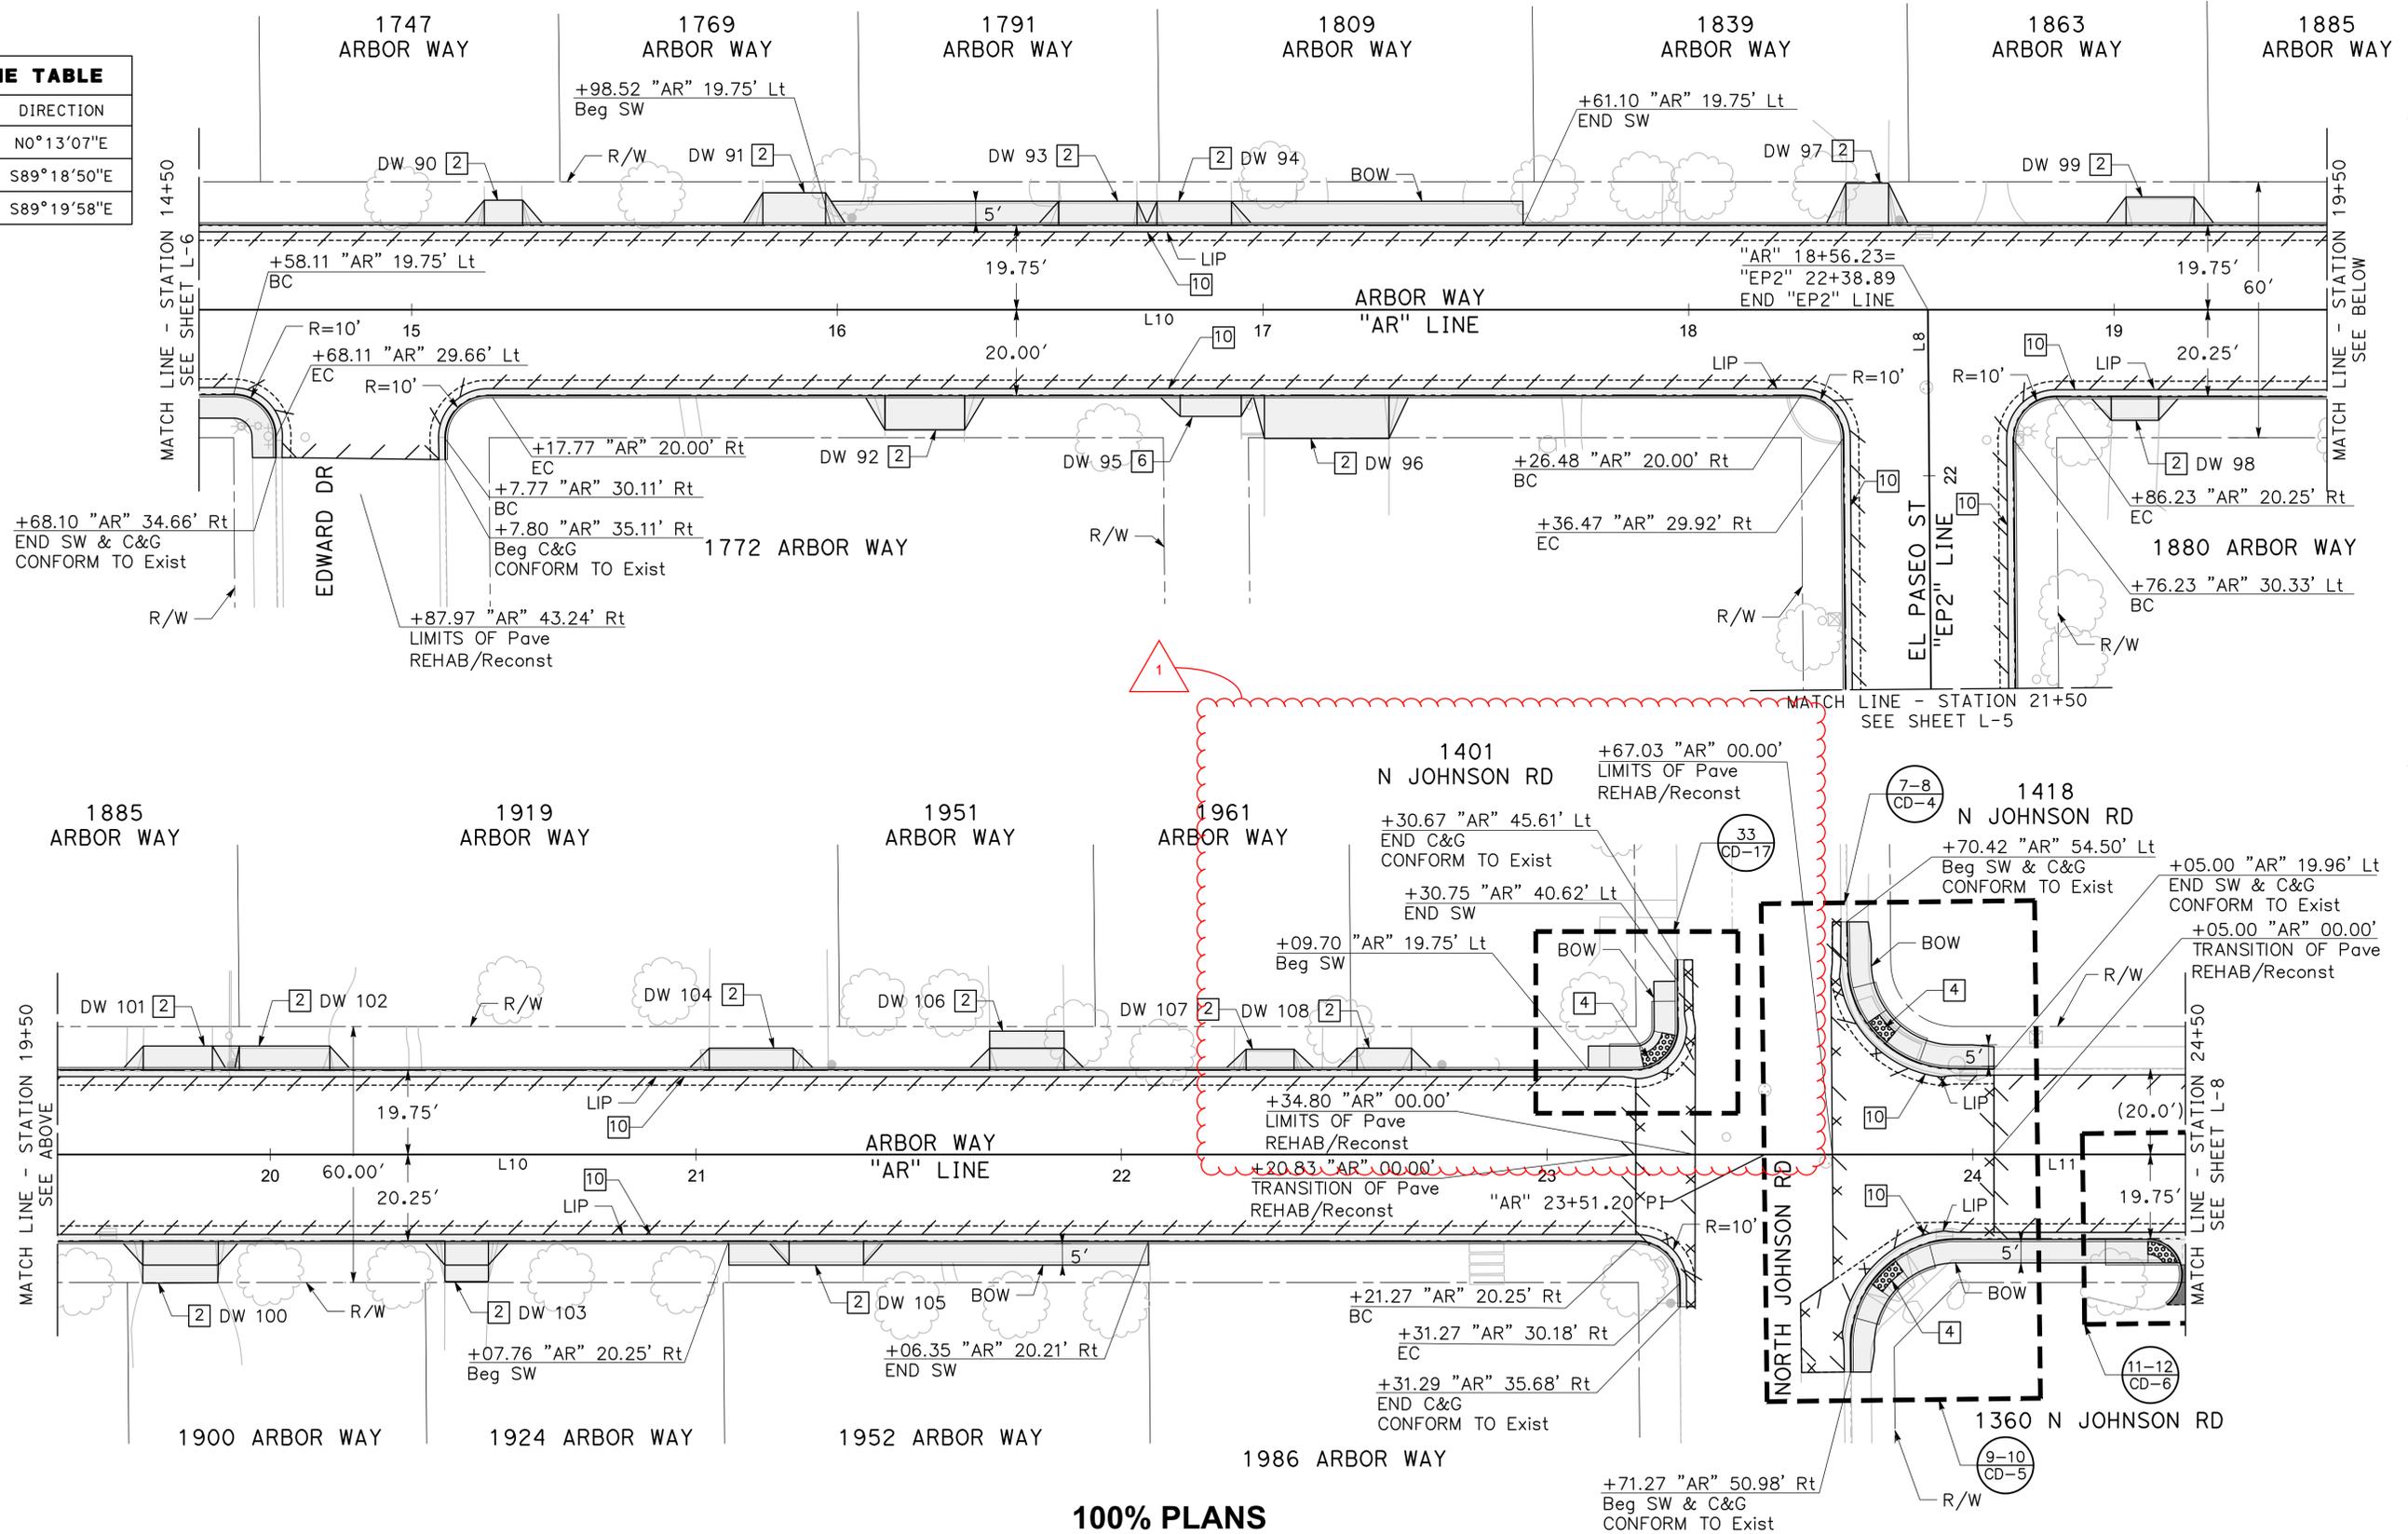

100% PLANS

DESIGNED BY: POORE, B.
 DRAWN BY: FRANCO, N.
 CHECKED BY: NORIEGA, E.
 SCALE: 1"=20'
 DATE: 5/21/2025
 JOB NO.: 24-00061

NOTE:
 ALL REFERENCES AND WRITTEN DIMENSIONS SHALL SUPERCEDE ALL SCALED DISTANCES AND SHALL BE VERIFIED IN THE FIELD. ANY DISCREPANCY SHALL BE BROUGHT TO THE ATTENTION OF THE ENGINEER PRIOR TO THE COMMENCEMENT OF WORK.

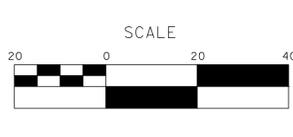


MARK THOMAS
 701 UNIVERSITY AVENUE, SUITE 200
 SACRAMENTO, CALIFORNIA 95825
 (916) 381-9100 FAX:(916)381-9180
 markthomas.com

CITY OF TURLOCK
 MUNICIPAL SERVICES
 DEPARTMENT
 156 S. BROADWAY
 SUITE 150
 (209) 668-5520



**CITY OF TURLOCK
 ROADS PROGRAM CIP
 PROJECT 23-067 PACKAGE #3
 LAYOUTS**


ALIGNMENT LINE TABLE		
LINE #	LENGTH	DIRECTION
L11	1349.22'	S89°19'58"E

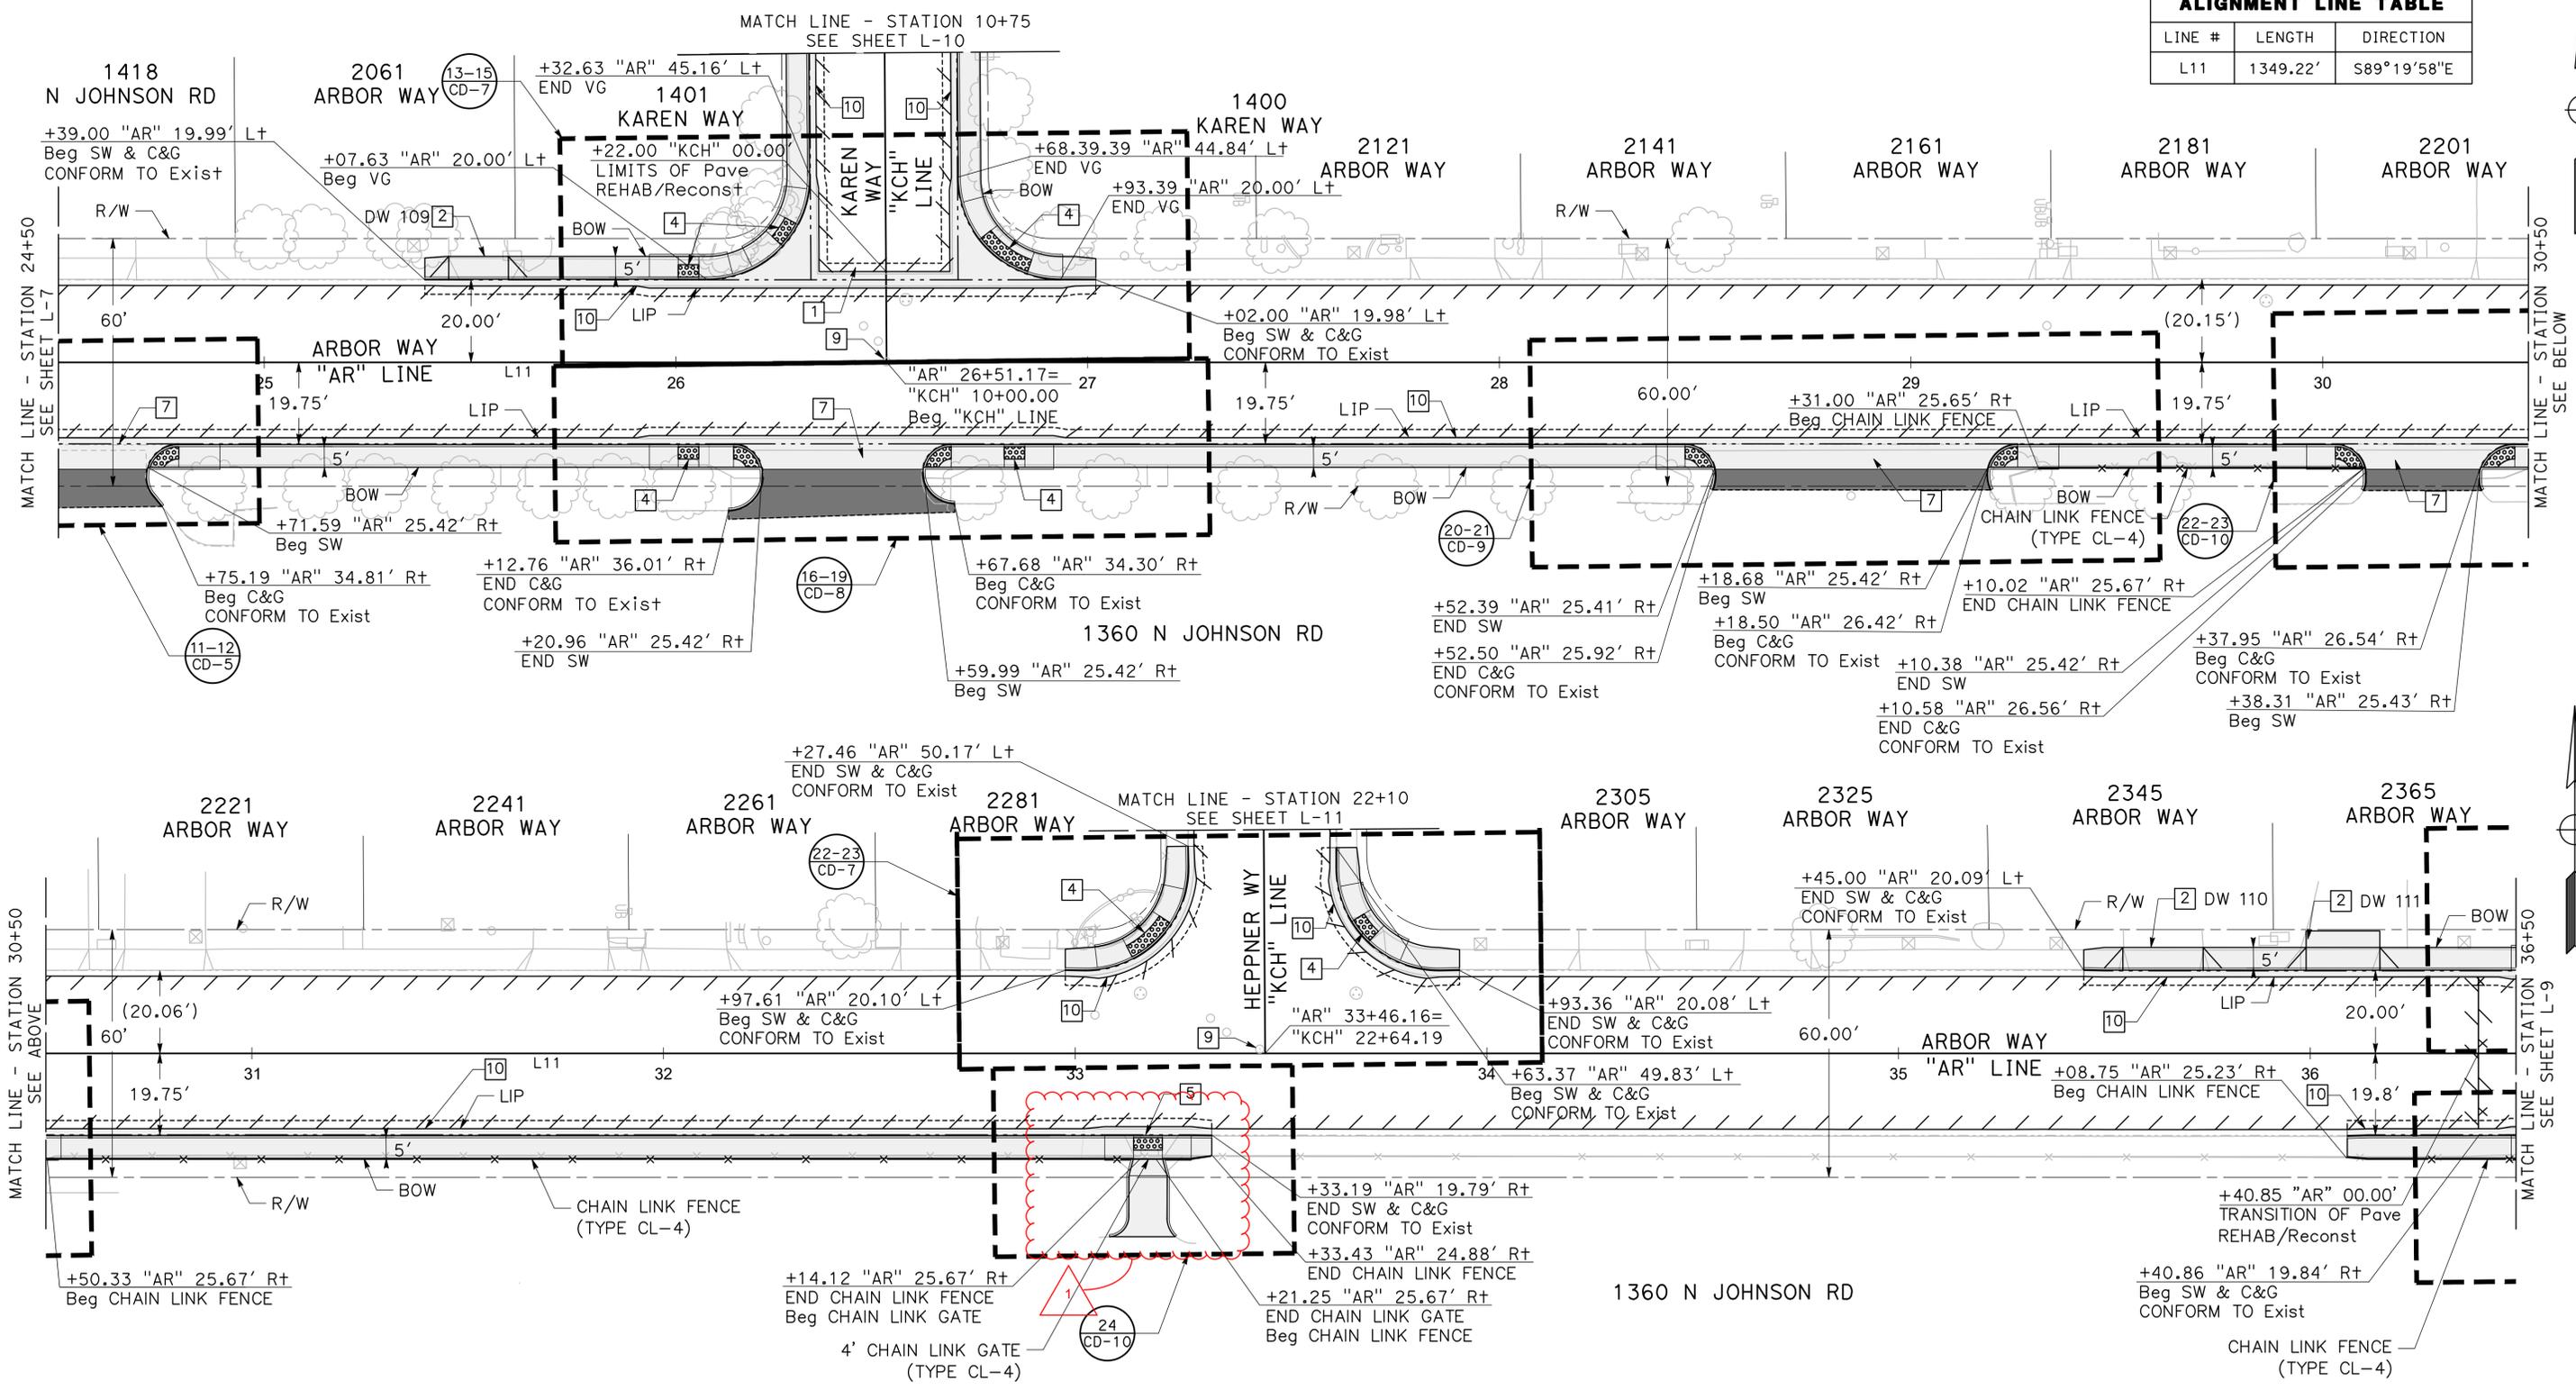

100% PLANS

DESIGNED BY: POORE, B.
 DRAWN BY: FRANCO, N.
 CHECKED BY: NORIEGA, E.
 SCALE: 1"=20'
 DATE: 5/21/2025
 JOB NO.: 24-00061

NOTE:
 ALL REFERENCES AND WRITTEN DIMENSIONS SHALL SUPERCEDE ALL SCALED DISTANCES AND SHALL BE VERIFIED IN THE FIELD. ANY DISCREPANCY SHALL BE BROUGHT TO THE ATTENTION OF THE ENGINEER PRIOR TO THE COMMENCEMENT OF WORK.

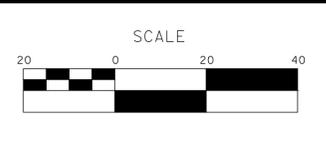

MARK THOMAS
 701 UNIVERSITY AVENUE, SUITE 200
 SACRAMENTO, CALIFORNIA 95825
 (916) 381-9100 FAX:(916)381-9180
 markthomas.com

CITY OF TURLOCK
 MUNICIPAL SERVICES
 DEPARTMENT
 156 S. BROADWAY
 SUITE 150
 (209) 668-5520




**CITY OF TURLOCK
 ROADS PROGRAM CIP
 PROJECT 23-067 PACKAGE #3
 LAYOUTS**

Sheet **32**
 of **126** Sheets
L - 8

ALIGNMENT LINE TABLE		
LINE #	LENGTH	DIRECTION
L14	270.06'	N0°17'52"E
L15	644.93'	S89°21'29"E


ALIGNMENT CURVE TABLE				
CURVE	RADIUS	DELTA	TANGENT	LENGTH
C5	25.00'	90°20'39"	25.15'	39.42'

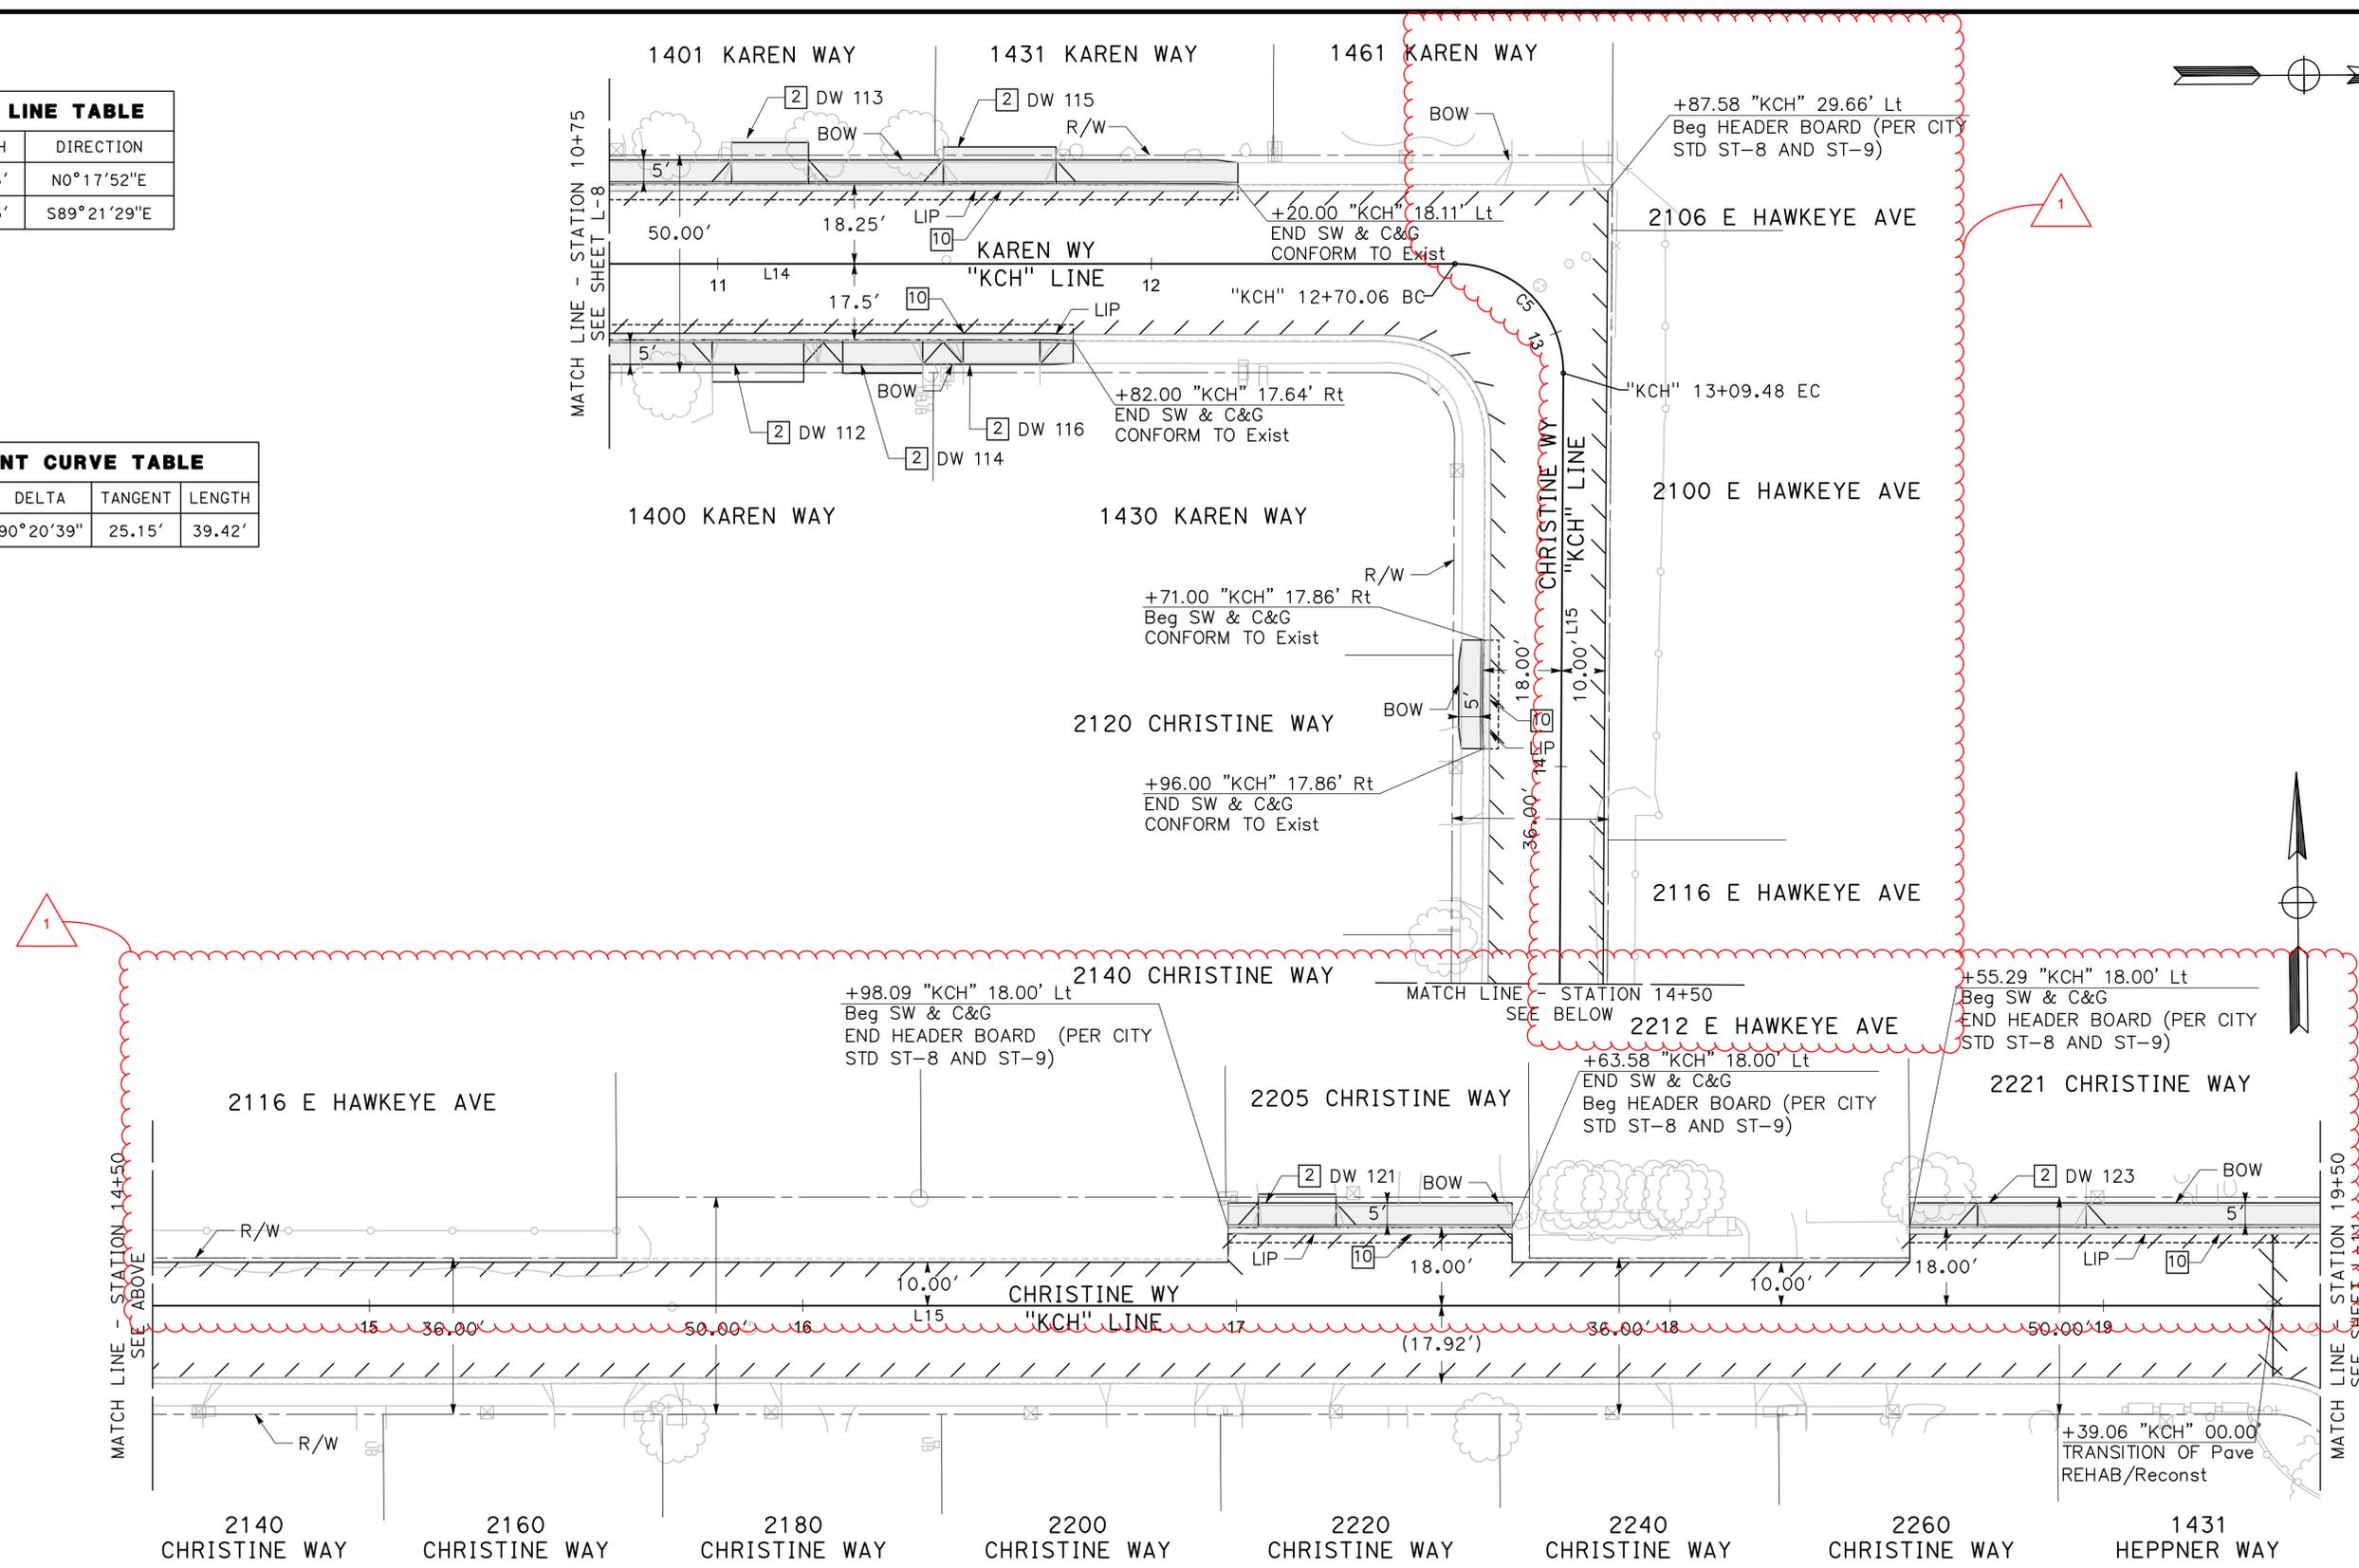

100% PLANS

DESIGNED BY: POORE, B.
 DRAWN BY: FRANCO, N.
 CHECKED BY: NORIEGA, E.
 SCALE: 1"=20'
 DATE: 5/21/2025
 JOB NO.: 24-00061

NOTE:
 ALL REFERENCES AND WRITTEN DIMENSIONS SHALL SUPERCEDE ALL SCALED DISTANCES AND SHALL BE VERIFIED IN THE FIELD. ANY DISCREPANCY SHALL BE BROUGHT TO THE ATTENTION OF THE ENGINEER PRIOR TO THE COMMENCEMENT OF WORK.

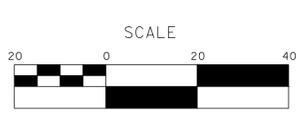

MARK THOMAS
 701 UNIVERSITY AVENUE, SUITE 200
 SACRAMENTO, CALIFORNIA 95825
 (916) 381-9100 FAX:(916)381-9180
 markthomas.com

CITY OF TURLOCK
 MUNICIPAL SERVICES DEPARTMENT
 156 S. BROADWAY
 SUITE 150
 (209) 668-5520





CITY OF TURLOCK
ROADS PROGRAM CIP
PROJECT 23-067 PACKAGE #3
LAYOUTS

Sheet **34**
 of
126 Sheets
L-10

ALIGNMENT LINE TABLE		
LINE #	LENGTH	DIRECTION
L16	270.67'	SO°17'16"W
L17	53.00'	NO°13'43"E


ALIGNMENT CURVE TABLE				
CURVE	RADIUS	DELTA	TANGENT	LENGTH
C7	370.00'	18°19'43"	59.69'	118.36'
C8	830.00'	37°14'21"	279.64'	539.46'

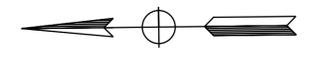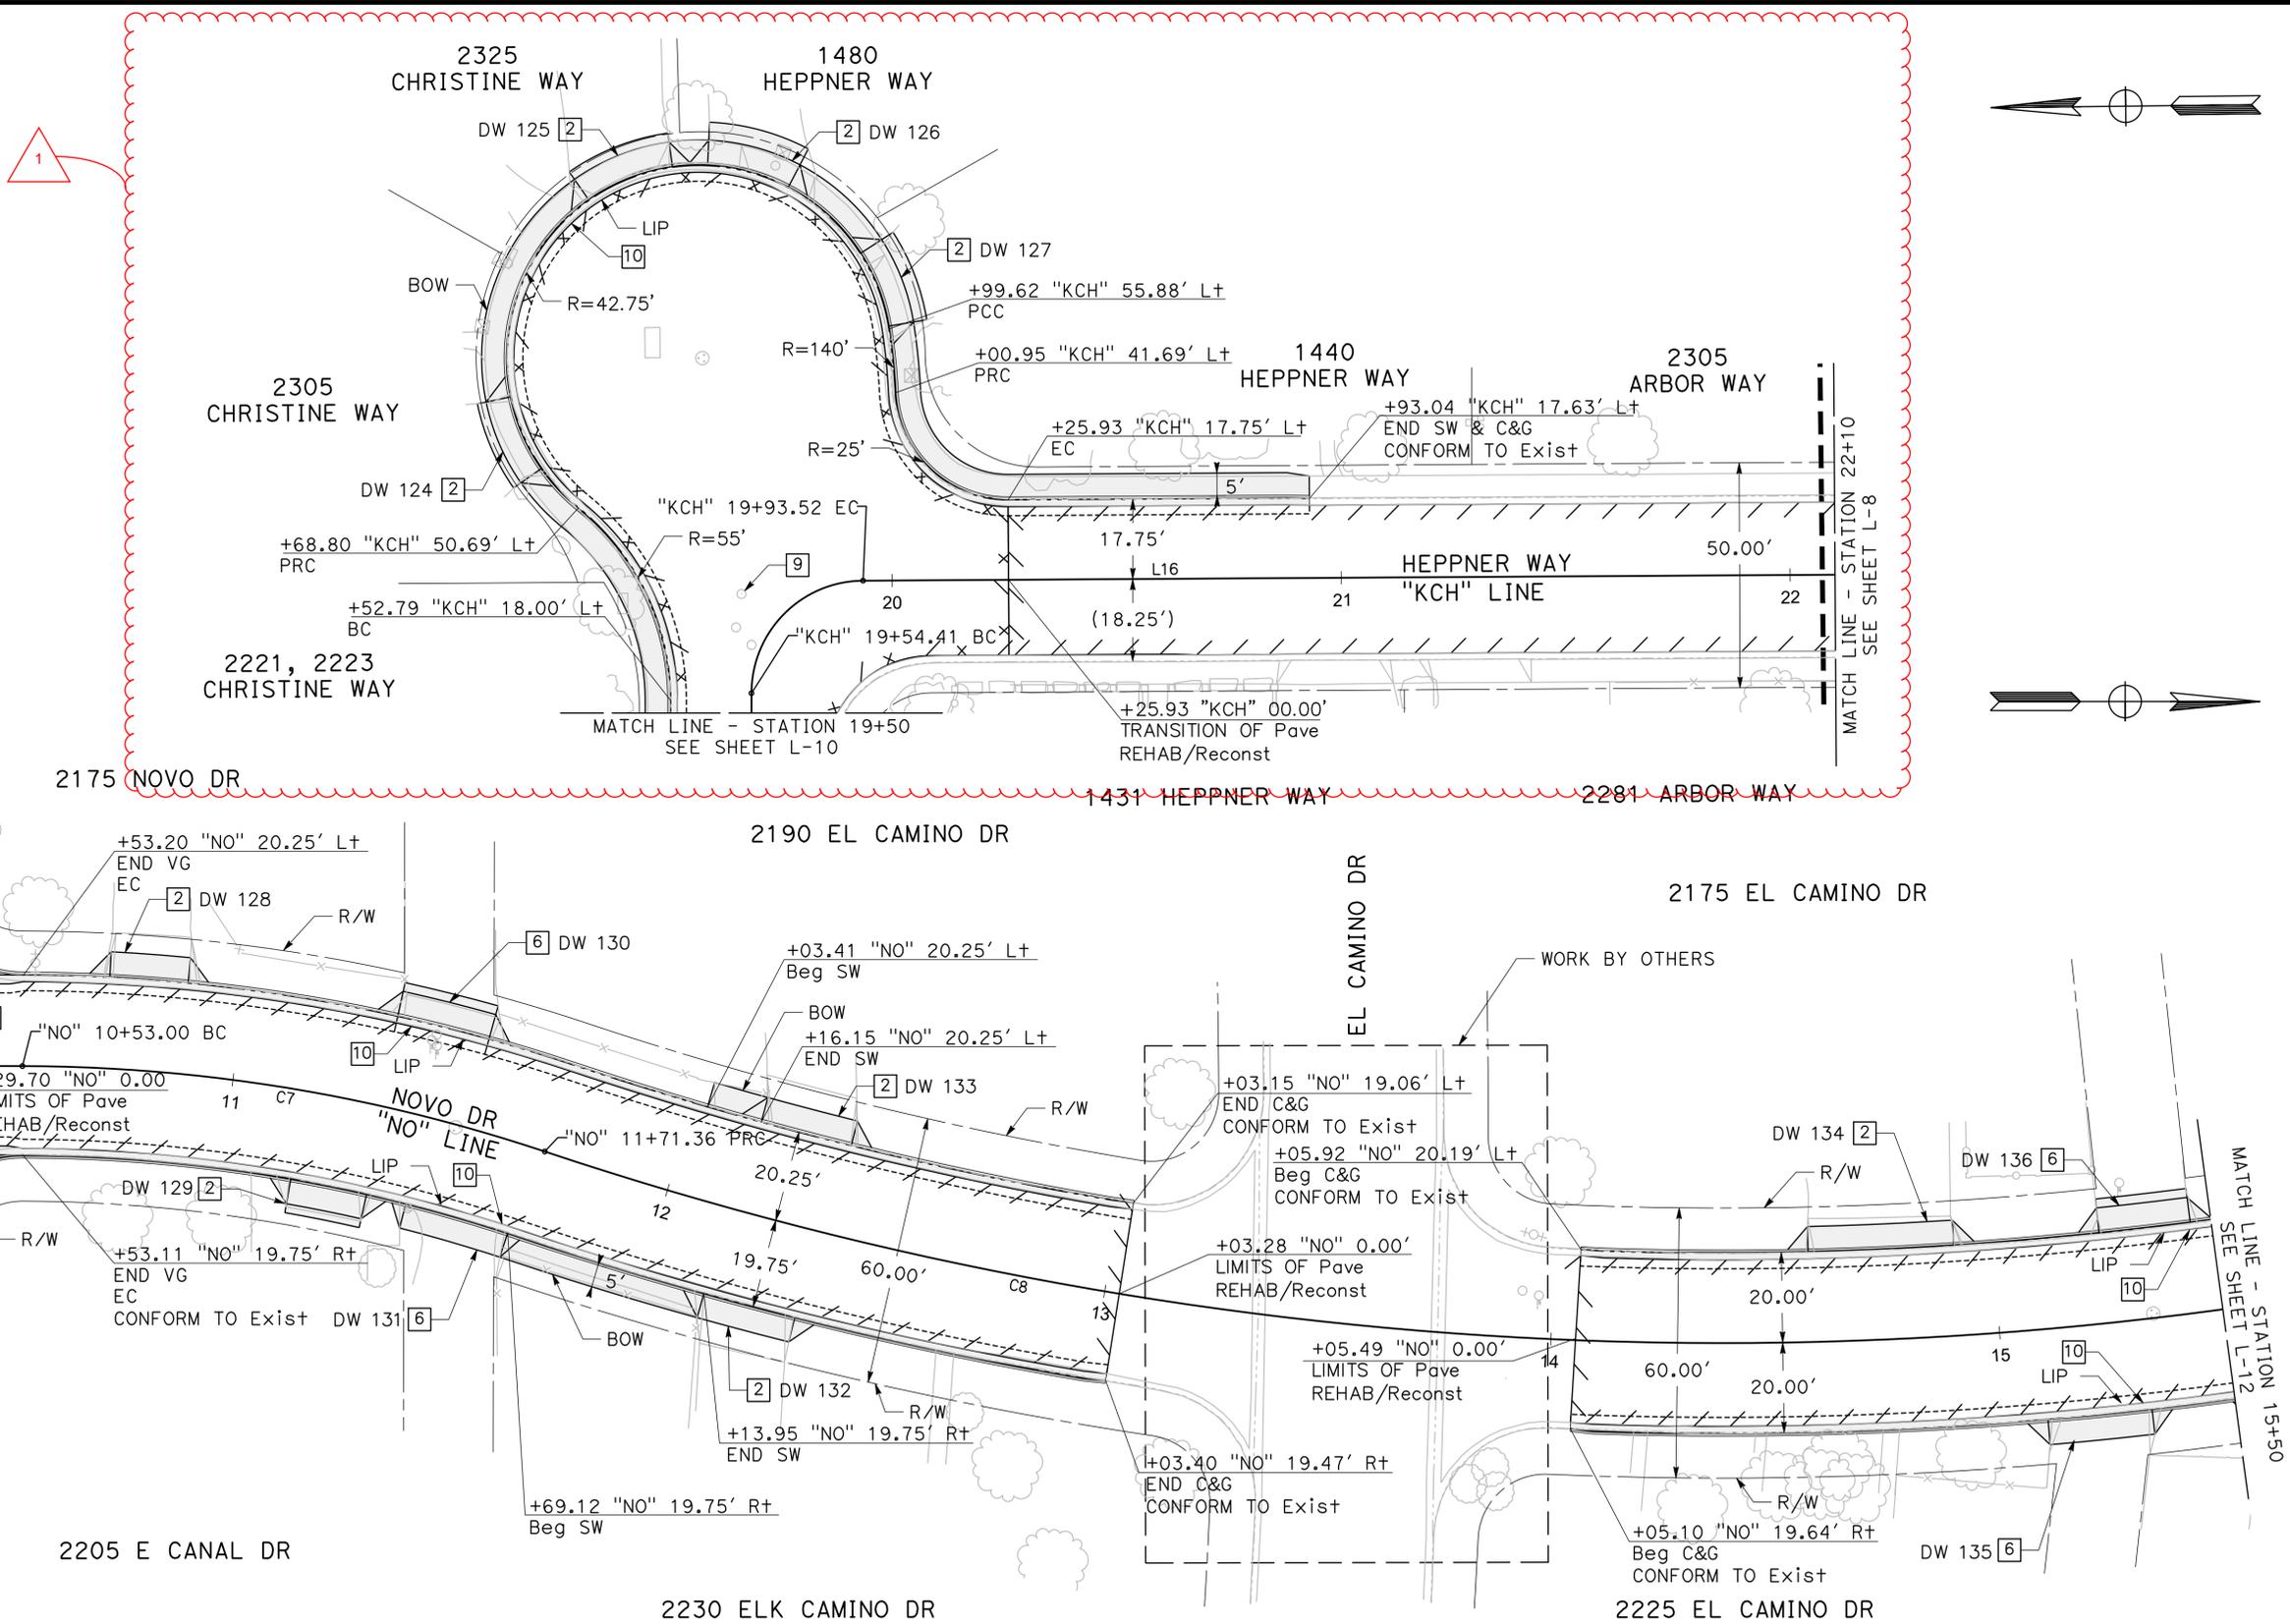

100% PLANS

DESIGNED BY: POORE, B.
 DRAWN BY: FRANCO, N.
 CHECKED BY: NORIEGA, E.
 SCALE: 1"=20'
 DATE: 5/21/2025
 JOB NO.: 24-00061

NOTE:
 ALL REFERENCES AND WRITTEN DIMENSIONS SHALL SUPERCEDE ALL SCALED DISTANCES AND SHALL BE VERIFIED IN THE FIELD. ANY DISCREPANCY SHALL BE BROUGHT TO THE ATTENTION OF THE ENGINEER PRIOR TO THE COMMENCEMENT OF WORK.

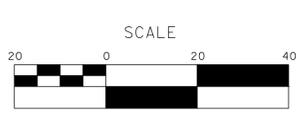

MARK THOMAS
 701 UNIVERSITY AVENUE, SUITE 200
 SACRAMENTO, CALIFORNIA 95825
 (916) 381-9100 FAX:(916)381-9180
 markthomas.com


CITY OF TURLOCK
 MUNICIPAL SERVICES
 DEPARTMENT
 156 S. BROADWAY
 SUITE 150
 (209) 668-5520




CITY OF TURLOCK
ROADS PROGRAM CIP
PROJECT 23-067 PACKAGE #3
LAYOUTS

Sheet **35**
 of
126 Sheets
L-11

CHAIN LINK FENCE
(TYPE CL-4) (SEE
L SHEETS)

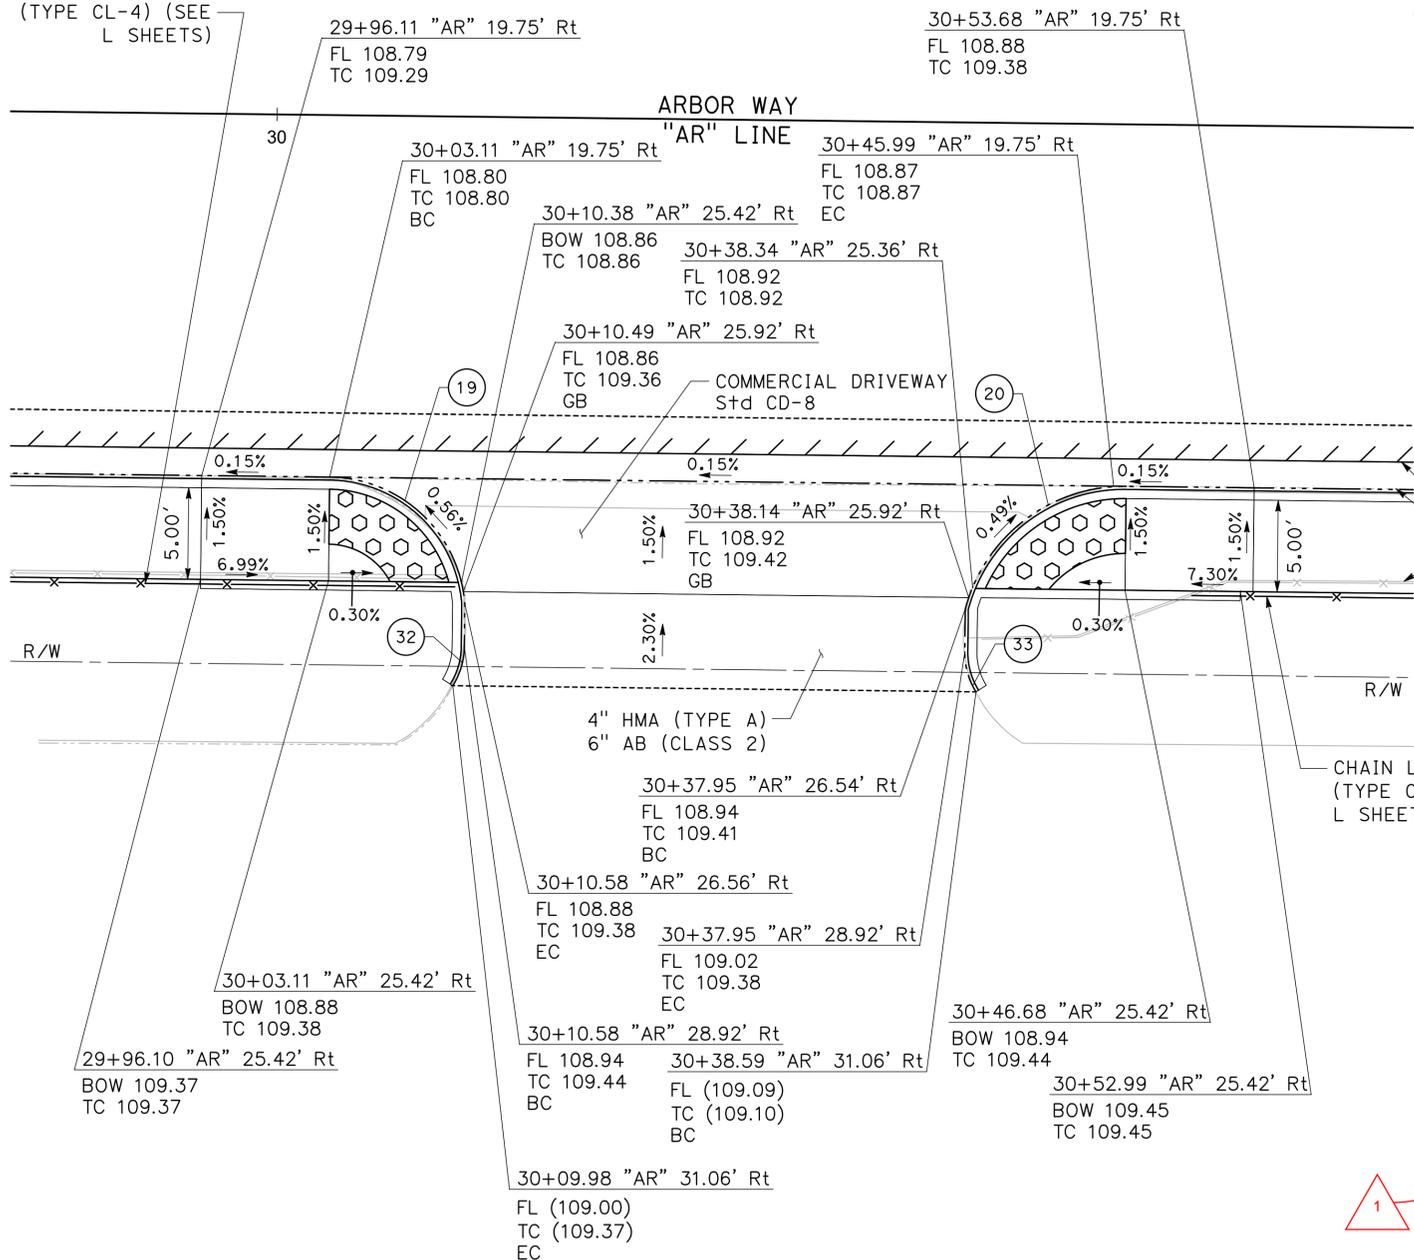

22 ARBOR WAY BETWEEN KAREN WAY & HEPNER WAY **23**
CD-9 SW AND SE CURB RAMPS **CD-9**
SCALE: 1" = 5'

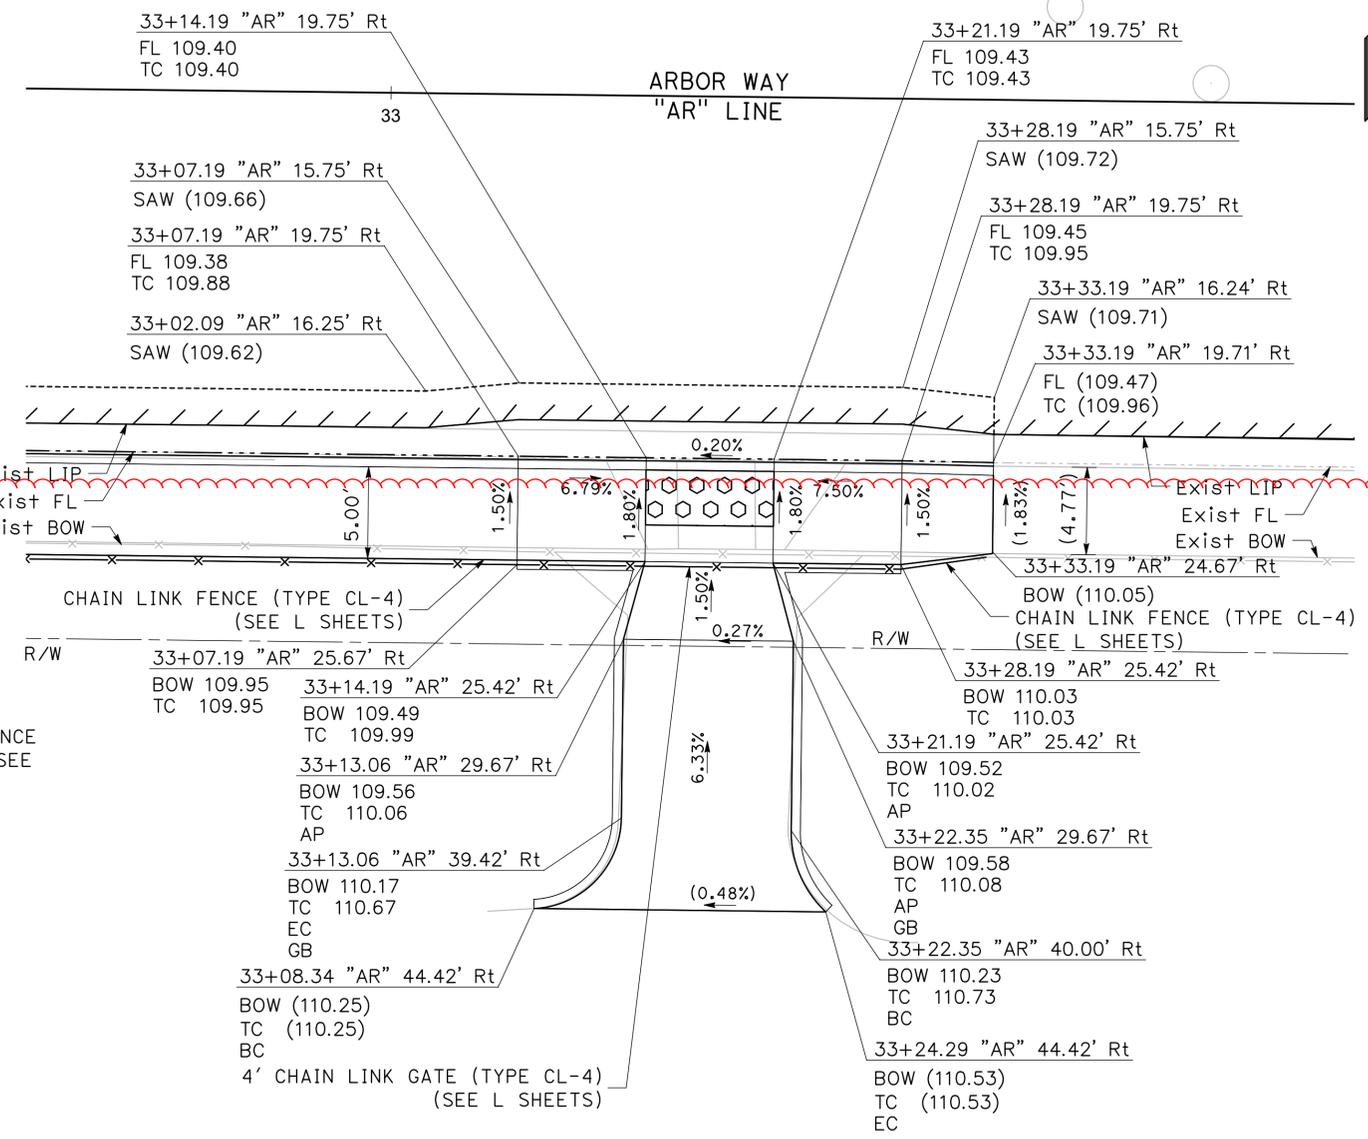

24 HEPNER WAY & ARBOR WAY **25**
CD-9 SW CURB RAMP **CD-9**
SCALE: 1" = 5'

CURVE TABLE				
No. X	R	Δ	T	L
19	7.50'	84°41'46"	6.84'	11.09'
20	9.00'	75°48'23"	7.01'	11.91'
32	4.00'	32°16'05"	1.16'	2.25'
33	4.00'	32°24'59"	1.16'	2.26'

100% PLANS

DESIGNED BY: POORE, B.
DRAWN BY: FRANCO, N.
CHECKED BY: NORIEGA, E.
SCALE: 1"=5'
DATE: 5/21/2025
JOB NO.: 24-00061

NOTE:
ALL REFERENCES AND WRITTEN DIMENSIONS SHALL SUPERCEDE ALL SCALED DISTANCES AND SHALL BE VERIFIED IN THE FIELD. ANY DISCREPANCY SHALL BE BROUGHT TO THE ATTENTION OF THE ENGINEER PRIOR TO THE COMMENCEMENT OF WORK.



MARK THOMAS
701 UNIVERSITY AVENUE, SUITE 200
SACRAMENTO, CALIFORNIA 95825
(916) 381-9100 FAX:(916)381-9180
markthomas.com


CITY OF TURLOCK
MUNICIPAL SERVICES
DEPARTMENT
156 S. BROADWAY
SUITE 150
(209) 668-5520

CITY OF TURLOCK
ROADS PROGRAM CIP
PROJECT 23-067 PACKAGE #3
CONSTRUCTION DETAILS


Sheet **48**
of
126 Sheets
CD - 9

NOTES:


1. FOR C&G TRANSITIONS NEAR DRIVEWAYS, USE TRANSITION LENGTH OF 3'.
2. FOR C&G TRANSITIONS AT INTERSECTIONS AROUND CURB RETURNS, USE TRANSITION LENGTH OF 10'
3. REFER TO THE LAYOUT SHEETS FOR MODIFIED DRIVE-OVER CURB LOCATIONS.
4. DRIVE-OVER CURB SHALL BE TRANSITIONED TO 6" CURB AND GUTTER (C-1) AT DRAINAGE INLETS. A TRANSITION LENGTH OF 3' SHALL BE USED IN THIS CONDITION.
5. WHEN DETAIL A IS USED, THE THICKNESS OF THE FULL DEPTH HMA (TYPE A) SHALL BE:
0.85' WHEN USED ALONG NORTH QUINCY ROAD (TI = 8).
0.65' WHEN USED ALONG ALL OTHER STREETS WITHIN THE PROJECT AREA (TI = 6).

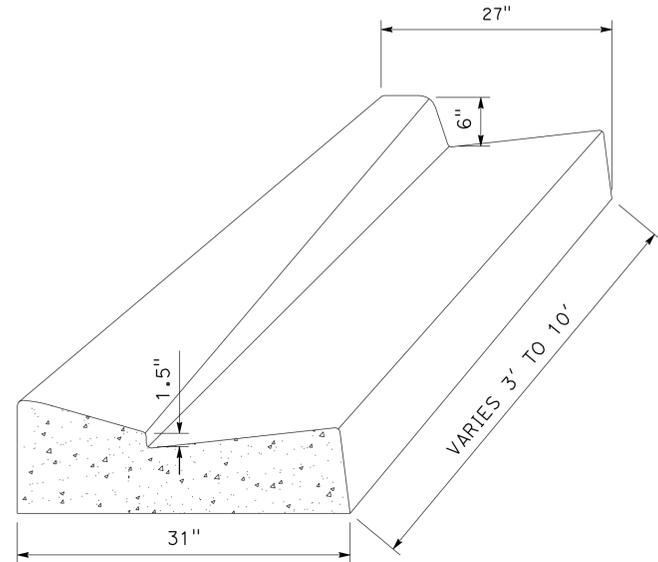

DRIVE-OVER CURB AND GUTTER TO 6" CURB AND GUTTER (C-1) TRANSITION
SCALE: NTS

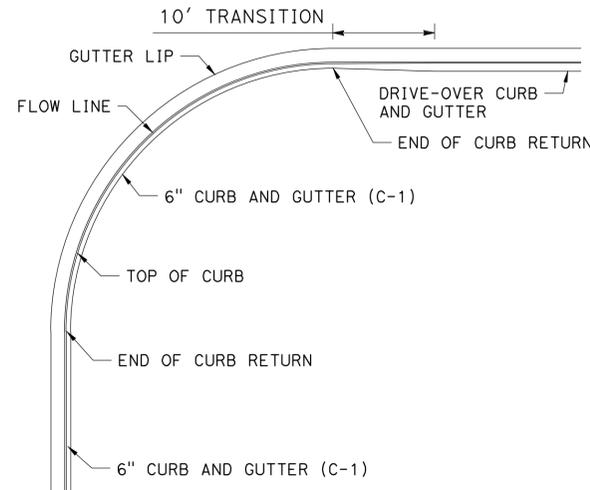


CURB AND GUTTER TRANSITION AT CURB RETURNS
SCALE: NTS

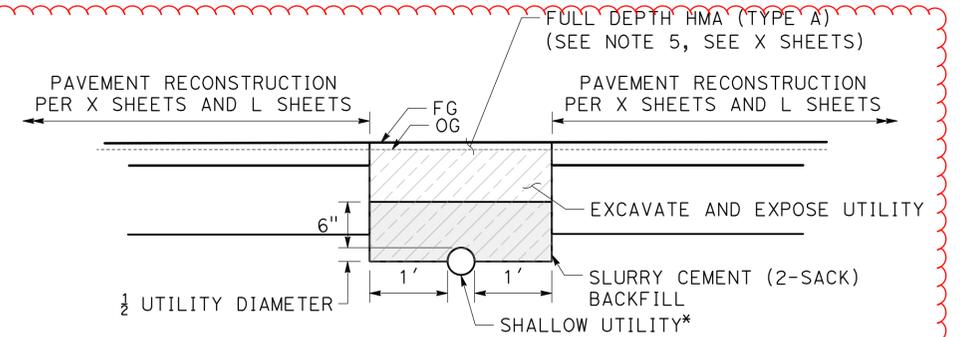


DETAIL A: SHALLOW UTILITY TRENCH SECTION (TOP OF UTILITY IS WITHIN 6" OF PAVEMENT SECTION)
SCALE: NTS

*SEE UUD SHEETS FOR UTILITY DEPTH INFORMATION

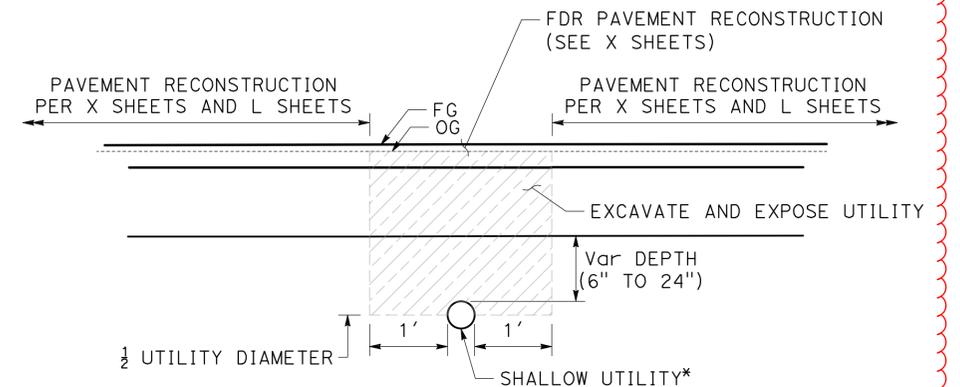


DETAIL B: SHALLOW UTILITY TRENCH SECTION (TOP OF UTILITY IS 6" TO 24" BELOW THE PAVEMENT SECTION)
SCALE: NTS


*SEE UUD SHEETS FOR UTILITY DEPTH INFORMATION

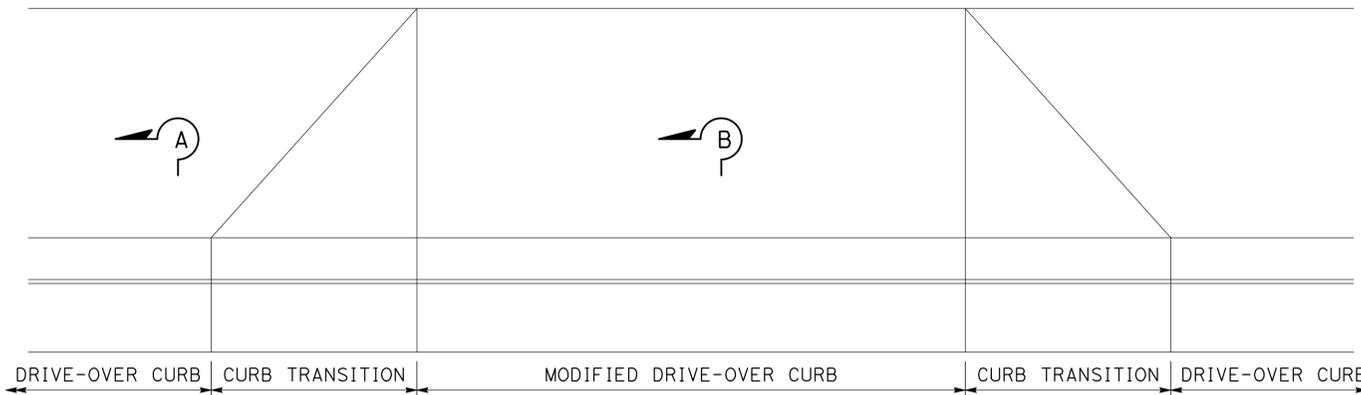

MODIFIED DRIVE-OVER CURB AND GUTTER TRANSITION AT DRIVEWAYS
SCALE: NTS

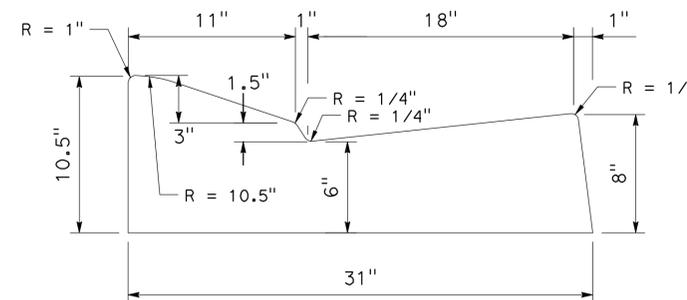

DRIVE-OVER CURB AND GUTTER DETAIL SECTION A-A
SCALE: NTS

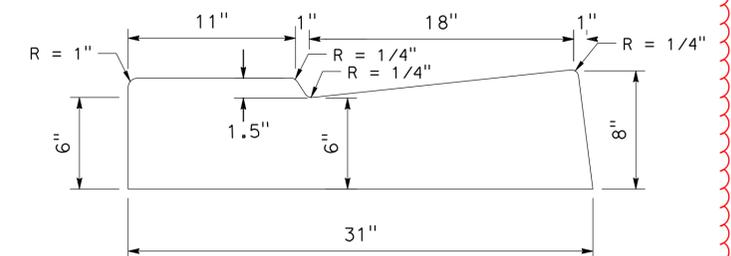

MODIFIED DRIVE-OVER CURB AND GUTTER DETAIL SECTION B-B
SCALE: NTS

100% PLANS

DESIGNED BY: POORE, B.
DRAWN BY: FRANCO, N.
CHECKED BY: NORIEGA, E.
SCALE: NOT TO SCALE
DATE: 5/22/2025
JOB NO.: 24-00061

NOTE:
ALL REFERENCES AND WRITTEN DIMENSIONS SHALL SUPERCEDE ALL SCALED DISTANCES AND SHALL BE VERIFIED IN THE FIELD. ANY DISCREPANCY SHALL BE BROUGHT TO THE ATTENTION OF THE ENGINEER PRIOR TO THE COMMENCEMENT OF WORK.



MARK THOMAS
701 UNIVERSITY AVENUE, SUITE 200
SACRAMENTO, CALIFORNIA 95825
(916) 381-9100 FAX:(916)381-9180
markthomas.com

CITY OF TURLOCK
MUNICIPAL SERVICES
DEPARTMENT
156 S. BROADWAY
SUITE 150
(209) 668-5520




CITY OF TURLOCK
ROADS PROGRAM CIP
PROJECT 23-067 PACKAGE #3
CONSTRUCTION DETAILS

Sheet 52
of 126 Sheets

CD-13

DRIVEWAY INFORMATION

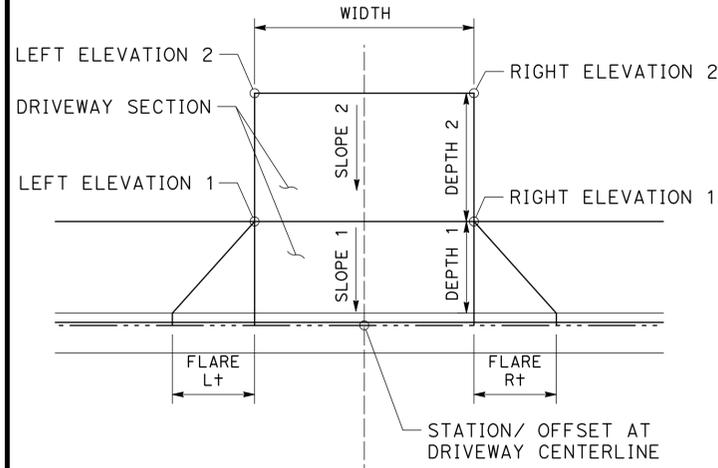

DRIVEWAY DETAIL
SCALE: NTS

DRIVEWAY NUMBER	LOCATION	WIDTH	DEPTH 1	SLOPE 1	LEFT ELEVATION 1	RIGHT ELEVATION 1	FLARE LEFT	FLARE RIGHT	DEPTH 2	SLOPE 2	LEFT ELEVATION 2	RIGHT ELEVATION 2	DRIVEWAY SECTION
65	16+17.49 "EP2" 20.00' Lt	20.64'	5.00'	9.00%	108.57'	108.59'	4.50'	4.50'	2.00'	8.11%	108.73'	108.62'	7.5" Conc
66	16+16.61 "EP2" 19.75' Rt	18.80'	5.00'	5.04%	108.59'	108.53'	1.00'	1.00'	N/A	N/A	N/A	N/A	7.5" Conc
67	16+37.83 "EP2" 19.75' Rt	14.42'	5.00'	6.00%	108.66'	108.64'	4.50'	1.00'	5.25'	5.71%	108.96'	108.82'	5.5" Conc
68	17+79.92 "EP2" 20.00' Lt	10.25'	5.00'	9.50%	108.76'	108.77'	4.50'	4.50'	6.00'	8.72%	109.29'	109.26'	5.5" Conc
69	18+03.33 "EP2" 20.00' Lt	09.16'	5.00'	9.00%	108.76'	108.77'	4.50'	4.50'	3.00'	8.46%	109.02'	108.94'	5.5" Conc
70	19+25.79 "EP2" 20.00' Lt	10.29'	5.00'	8.53%	108.77'	108.87'	4.50'	3.50'	N/A	N/A	N/A	N/A	5.5" Conc
71	19+43.82 "EP2" 20.00' Lt	10.40'	6.00'	9.47%	108.96'	109.00'	3.50'	4.50'	N/A	N/A	N/A	N/A	5.5" Conc
72	19+52.42 "EP2" 19.75' Rt	11.69'	5.00'	4.42%	108.79'	108.85'	4.50'	4.50'	N/A	N/A	N/A	N/A	5.5" Conc
73	20+03.23 "EP2" 19.75' Rt	15.50'	5.00'	7.26%	109.05'	109.05'	4.50'	4.50'	N/A	N/A	N/A	N/A	5.5" Conc
74	20+20.73 "EP2" 20.00' Lt	09.91'	5.00'	9.50%	109.00'	109.01'	4.50'	4.50'	4.50'	11.74%	109.48'	109.53'	5.5" Conc
75	20+31.64 "EP2" 19.75' Rt	12.50'	5.00'	0.50%	108.75'	108.74'	4.50'	4.50'	3.00'	4.84%	108.73'	108.60'	5.5" Conc
76	11+12.14 "LV" 20.00' Rt	14.44'	5.00'	4.70%	108.73'	108.84'	4.50'	4.50'	N/A	N/A	N/A	N/A	5.5" Conc
77	11+16.10 "LV" 20.00' Lt	19.13'	5.00'	5.68%	108.89'	108.85'	4.50'	3.50'	N/A	N/A	N/A	N/A	5.5" Conc
78	11+44.78 "LV" 20.00' Lt	22.30'	5.00'	5.00%	108.88'	108.89'	3.50'	4.50'	3.00'	5.56%	109.03'	109.06'	5.5" Conc
79	11+98.28 "LV" 20.00' Rt	21.09'	5.00'	6.73%	108.98'	109.04'	4.50'	4.50'	N/A	N/A	N/A	N/A	5.5" Conc
80	12+73.75 "LV" 20.00' Rt	11.58'	5.00'	5.32%	109.09'	108.90'	4.50'	4.50'	N/A	N/A	N/A	N/A	5.5" Conc
81	12+78.90 "LV" 20.00' Lt	18.09'	5.00'	4.62%	108.94'	108.98'	4.50'	4.50'	N/A	N/A	N/A	N/A	5.5" Conc
82	13+03.40 "LV" 20.00' Lt	10.65'	5.00'	5.74%	108.92'	109.06'	4.50'	4.50'	N/A	N/A	N/A	N/A	5.5" Conc
83	13+46.88 "LV" 20.00' Rt	18.86'	5.00'	3.07%	109.03'	109.03'	4.50'	4.50'	N/A	N/A	N/A	N/A	5.5" Conc
84	10+76.99 "AR" 20.25' Lt	21.01'	5.00'	8.00%	108.19'	108.26'	4.50'	4.50'	2.00'	4.63%	108.27'	108.35'	5.5" Conc
85	12+02.20 "AR" 20.25' Lt	18.08'	5.00'	9.27%	108.64'	108.67'	4.50'	4.50'	N/A	N/A	N/A	N/A	5.5" Conc
86	12+51.69 "AR" 19.75' Lt	24.34'	5.00'	9.85%	108.85'	108.84'	4.50'	4.50'	N/A	N/A	N/A	N/A	5.5" Conc
87	13+75.22 "AR" 19.75' Lt	19.75'	5.50'	9.59%	109.02'	109.10'	4.50'	4.50'	N/A	N/A	N/A	N/A	5.5" Conc
88													
89	14+05.82 "AR" 19.75' Lt	8.25'	5.25'	8.50%	109.04'	109.05'	4.50'	4.50'	2.00'	5.92%	109.16'	109.12'	5.5" Conc
90	15+21.55 "AR" 19.75' Lt	9.00'	5.25'	6.31%	109.07'	109.10'	4.50'	4.50'	N/A	N/A	N/A	N/A	5.5" Conc
91	15+89.85 "AR" 19.75' Lt	14.76'	7.00'	4.28%	109.15'	109.10'	4.50'	4.50'	N/A	N/A	N/A	N/A	5.5" Conc
92	16+20.54 "AR" 20.00' Rt	18.72'	7.50'	6.63%	109.20'	109.10'	4.50'	2.25'	N/A	N/A	N/A	N/A	5.5" Conc
93	16+61.19 "AR" 19.75' Lt	18.38'	5.00'	6.10%	109.05'	109.05'	4.50'	4.50'	N/A	N/A	N/A	N/A	5.5" Conc
94	16+83.85 "AR" 19.75' Lt	16.50'	5.00'	6.87%	109.05'	109.04'	2.25'	4.50'	N/A	N/A	N/A	N/A	7.5" Conc
95	16+87.70 "AR" 20.00' Rt	14.33'	4.50'	5.91%	109.02'	108.95'	2.50'	2.50'	N/A	N/A	N/A	N/A	5.5" Conc
96	17+14.96 "AR" 20.00' Rt	29.26'	9.50'	4.39%	109.22'	109.13'	4.50'	4.50'	N/A	N/A	N/A	N/A	5.5" Conc
97	18+41.96 "AR" 19.75' Lt	10.02'	9.00'	5.83%	108.95'	108.90'	4.50'	4.50'	N/A	N/A	N/A	N/A	5.5" Conc
98	19+04.85 "AR" 20.25' Rt	11.16'	5.00'	8.67%	108.86'	108.79'	4.50'	4.50'	N/A	N/A	N/A	N/A	5.5" Conc
99	19+10.78 "AR" 19.75' Lt	15.99'	6.00'	5.58%	108.76'	108.80'	4.50'	4.50'	N/A	N/A	N/A	N/A	5.5" Conc
100	19+78.91 "AR" 20.25' Rt	17.75'	5.00'	9.00%	108.87'	108.82'	4.50'	3.00'	4.00'	4.46%	109.05'	109.00'	5.5" Conc
101	19+78.30 "AR" 19.75' Lt	16.21'	5.00'	4.83%	108.77'	108.81'	4.50'	4.50'	N/A	N/A	N/A	N/A	5.5" Conc
102	20+03.37 "AR" 19.75' Lt	21.25'	5.00'	9.25%	109.04'	109.06'	1.00'	4.50'	N/A	N/A	N/A	N/A	5.5" Conc
103	20+46.15 "AR" 20.25' Rt	10.20'	5.00'	8.00%	108.97'	108.95'	4.50'	4.50'	4.00'	5.08%	109.15'	109.14'	5.5" Conc
104	21+13.04 "AR" 19.75' Lt	19.75'	4.50'	8.91%	109.15'	109.10'	4.50'	4.50'	N/A	N/A	N/A	N/A	5.5" Conc
105	21+30.65 "AR" 20.25' Rt	17.50'	5.00'	6.82%	109.09'	109.09'	4.50'	4.50'	N/A	N/A	N/A	N/A	5.5" Conc
106	21+77.76 "AR" 19.75' Lt	17.50'	4.50'	4.70%	109.06'	109.08'	4.50'	4.50'	4.00'	8.09%	109.38'	109.11'	5.5" Conc
107	22+34.92 "AR" 19.75' Lt	11.28'	4.25'	4.60%	109.04'	108.86'	4.50'	4.50'	N/A	N/A	N/A	N/A	5.5" Conc
108	22+61.76 "AR" 19.75' Lt	12.80'	4.50'	5.73%	109.05'	109.04'	4.50'	4.50'	N/A	N/A	N/A	N/A	5.5" Conc
109	25+52.05 "AR" 20.00' Lt	14.50'	5.00'	9.88%	108.77'	108.88'	4.50'	4.50'	N/A	N/A	N/A	N/A	5.5" Conc
110	35+64.24 "AR" 20.00' Lt	19.50'	5.00'	9.69%	110.31'	110.30'	4.50'	4.50'	N/A	N/A	N/A	N/A	5.5" Conc
111	36+07.64 "AR" 20.00' Lt	18.54'	5.00'	9.70%	110.26'	110.23'	4.50'	4.50'	2.00'	5.45%	110.48'	110.42'	5.5" Conc
112	11+10.87 "KCH" 17.50' Rt	21.25'	5.00'	9.50%	109.53'	109.49'	4.50'	4.50'	2.00'	9.89%	109.73'	109.69'	5.5" Conc
113	11+12.08 "KCH" 18.25' Lt	17.75'	5.00'	9.00%	109.44'	109.48'	4.50'	4.50'	4.00'	5.96%	109.63'	109.72'	5.5" Conc
114	11+38.07 "KCH" 17.50' Rt	18.44'	5.00'	9.50%	109.56'	109.56'	4.50'	4.50'	4.00'	4.32%	109.67'	109.72'	5.5" Conc
115	11+65.04 "KCH" 18.25' Lt	26.00'	5.00'	8.00%	109.50'	109.56'	4.50'	4.50'	3.00'	5.24%	109.58'	109.71'	5.5" Conc
116	11+66.46 "KCH" 17.50' Rt	17.68'	5.00'	9.05%	109.63'	109.58'	4.50'	4.50'	N/A	N/A	N/A	N/A	5.5" Conc
117													
118													
119													
120													
121	17+13.98 "KCH" 18.00' Lt	17.96'	5.00'	8.00%	110.43'	110.45'	4.50'	4.50'	2.00'	6.09%	110.50'	110.62'	5.5" Conc
122													
123	18+83.41 "KCH" 18.00' Lt	25.04'	5.00'	7.51%	110.49'	110.62'	4.50'	4.50'	N/A	N/A	N/A	N/A	5.5" Conc
124	19+70.64 "KCH" 70.41' Lt	20.50'	5.00'	9.00%	111.05'	111.11'	4.50'	4.50'	2.00'	7.37%	111.20'	111.18'	5.5" Conc
125	20+82.99 "KCH" 100.68' Lt	20.18'	5.00'	1.00%	110.89'	110.90'	4.50'	4.50'	2.00'	-2.56%	110.90'	110.85'	5.5" Conc
126	20+88.33 "KCH" 93.35' Lt	18.74'	5.00'	1.00%	110.89'	110.87'	4.50'	4.50'	4.00'	-6.32%	110.61'	110.62'	5.5" Conc
127	20+97.27 "KCH" 64.92' Lt	19.74'	5.00'	1.00%	110.85'	110.83'	4.50'	4.50'	3.00'	-6.74%	110.70'	110.63'	5.5" Conc
128	10+79.71 "NO" 20.25' Lt	17.73'	5.00'	9.97%	109.11'	108.88'	4.50'	4.50'	N/A	N/A	N/A	N/A	5.5" Conc



100% PLANS

DESIGNED BY: POORE, B.
DRAWN BY: FRANCO, N.
CHECKED BY: NORIEGA, E.
SCALE: NOT TO SCALE
DATE: 5/21/2025
JOB NO.: 24-00061

NOTE:
ALL REFERENCES AND WRITTEN DIMENSIONS SHALL SUPERCEDE ALL SCALED DISTANCES AND SHALL BE VERIFIED IN THE FIELD. ANY DISCREPANCY SHALL BE BROUGHT TO THE ATTENTION OF THE ENGINEER PRIOR TO THE COMMENCEMENT OF WORK.




MARK THOMAS
701 UNIVERSITY AVENUE, SUITE 200
SACRAMENTO, CALIFORNIA 95825
(916) 381-9100 FAX: (916) 381-9180
markthomas.com

CITY OF TURLOCK
MUNICIPAL SERVICES
DEPARTMENT
156 S. BROADWAY
SUITE 150
(209) 668-5520




CITY OF TURLOCK
ROADS PROGRAM CIP
PROJECT 23-067 PACKAGE #3
CONSTRUCTION DETAILS

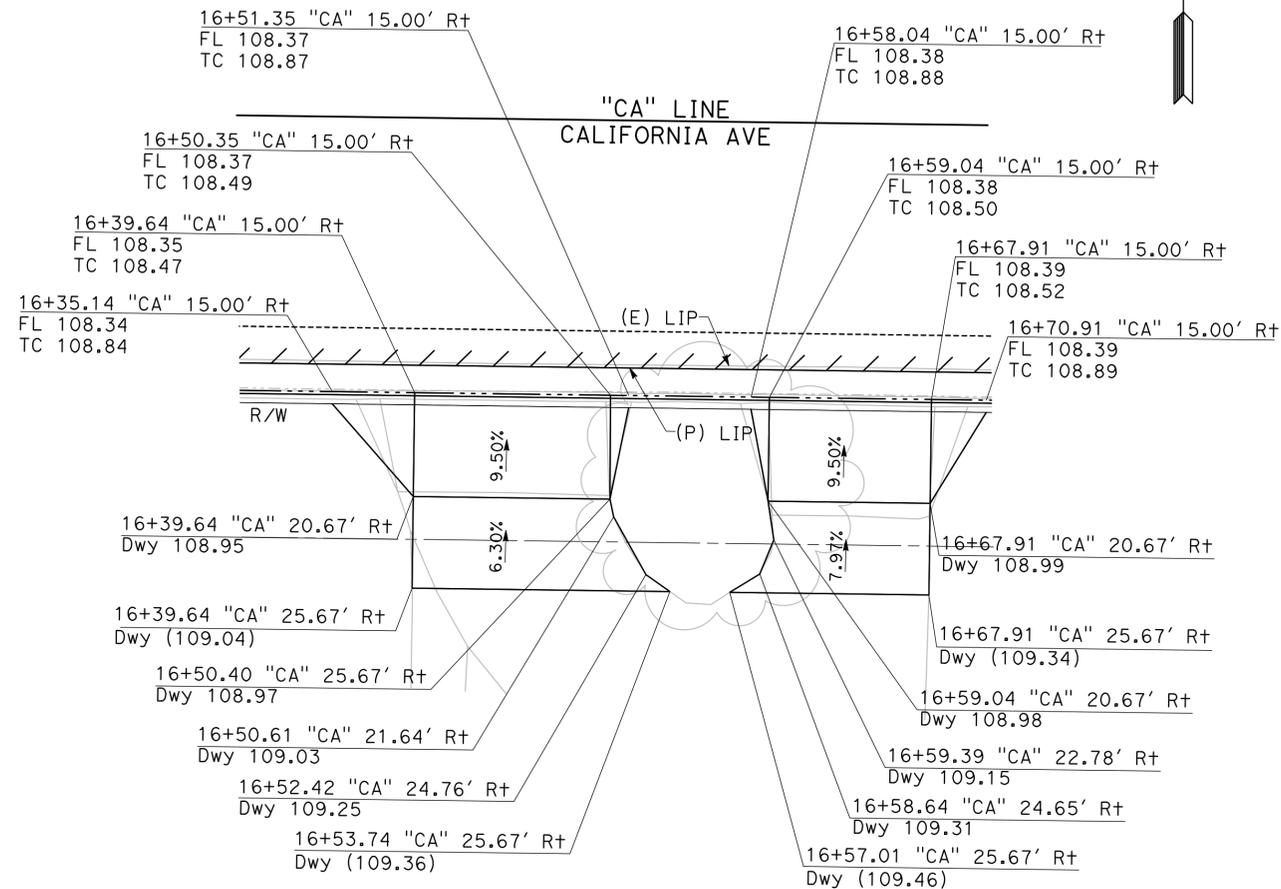

**DRIVEWAY #161 AND DRIVEWAY #162
GRADING DETAIL - CALIFORNIA AVE**

"CA" 16+35.14 - 16+93.31 Rt
SCALE: 1" = 5'

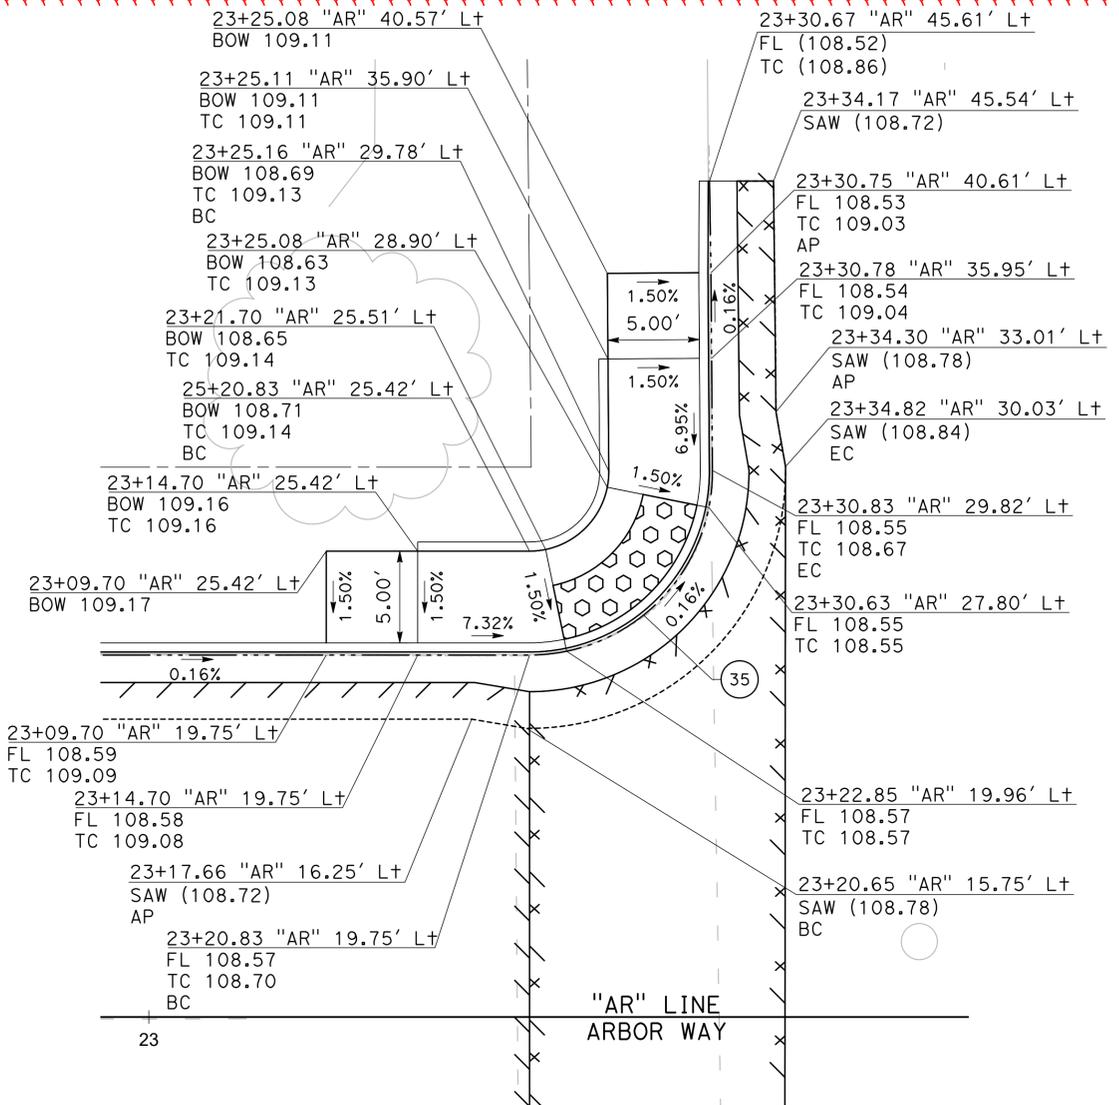

**33 N JOHNSON RD & ARBOR WAY
NW CURB RAMP**


SCALE: 1" = 5'

CURVE TABLE				
No.	X	R	A	L
35	10.00'	90°25'21"	10.07'	15.78'

100% PLANS

DESIGNED BY: POORE, B.
DRAWN BY: FRANCO, N.
CHECKED BY: NORIEGA, E.
SCALE: 1"=5'
DATE: 5/21/2025
JOB NO.: 24-00061

NOTE:
ALL REFERENCES AND WRITTEN DIMENSIONS SHALL SUPERCEDE ALL SCALED DISTANCES AND SHALL BE VERIFIED IN THE FIELD. ANY DISCREPANCY SHALL BE BROUGHT TO THE ATTENTION OF THE ENGINEER PRIOR TO THE COMMENCEMENT OF WORK.

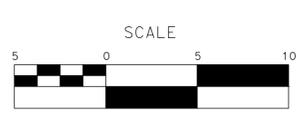

MARK THOMAS
701 UNIVERSITY AVENUE, SUITE 200
SACRAMENTO, CALIFORNIA 95825
(916) 381-9100 FAX:(916)381-9180
markthomas.com

CITY OF TURLOCK
MUNICIPAL SERVICES
DEPARTMENT
156 S. BROADWAY
SUITE 150
(209) 668-5520





**CITY OF TURLOCK
ROADS PROGRAM CIP
PROJECT 23-067 PACKAGE #3
CONSTRUCTION DETAILS**

Sheet **56**
of
126 Sheets
CD - 17


NOTE:

UNLESS SPECIFIED OTHERWISE, ALL STATIONS ON THIS SHEET ARE REFERENCED FROM THE "EP1" OR "EP2" LINE.

MATCH LINE - STATION 15+50
SEE SHEET G-4

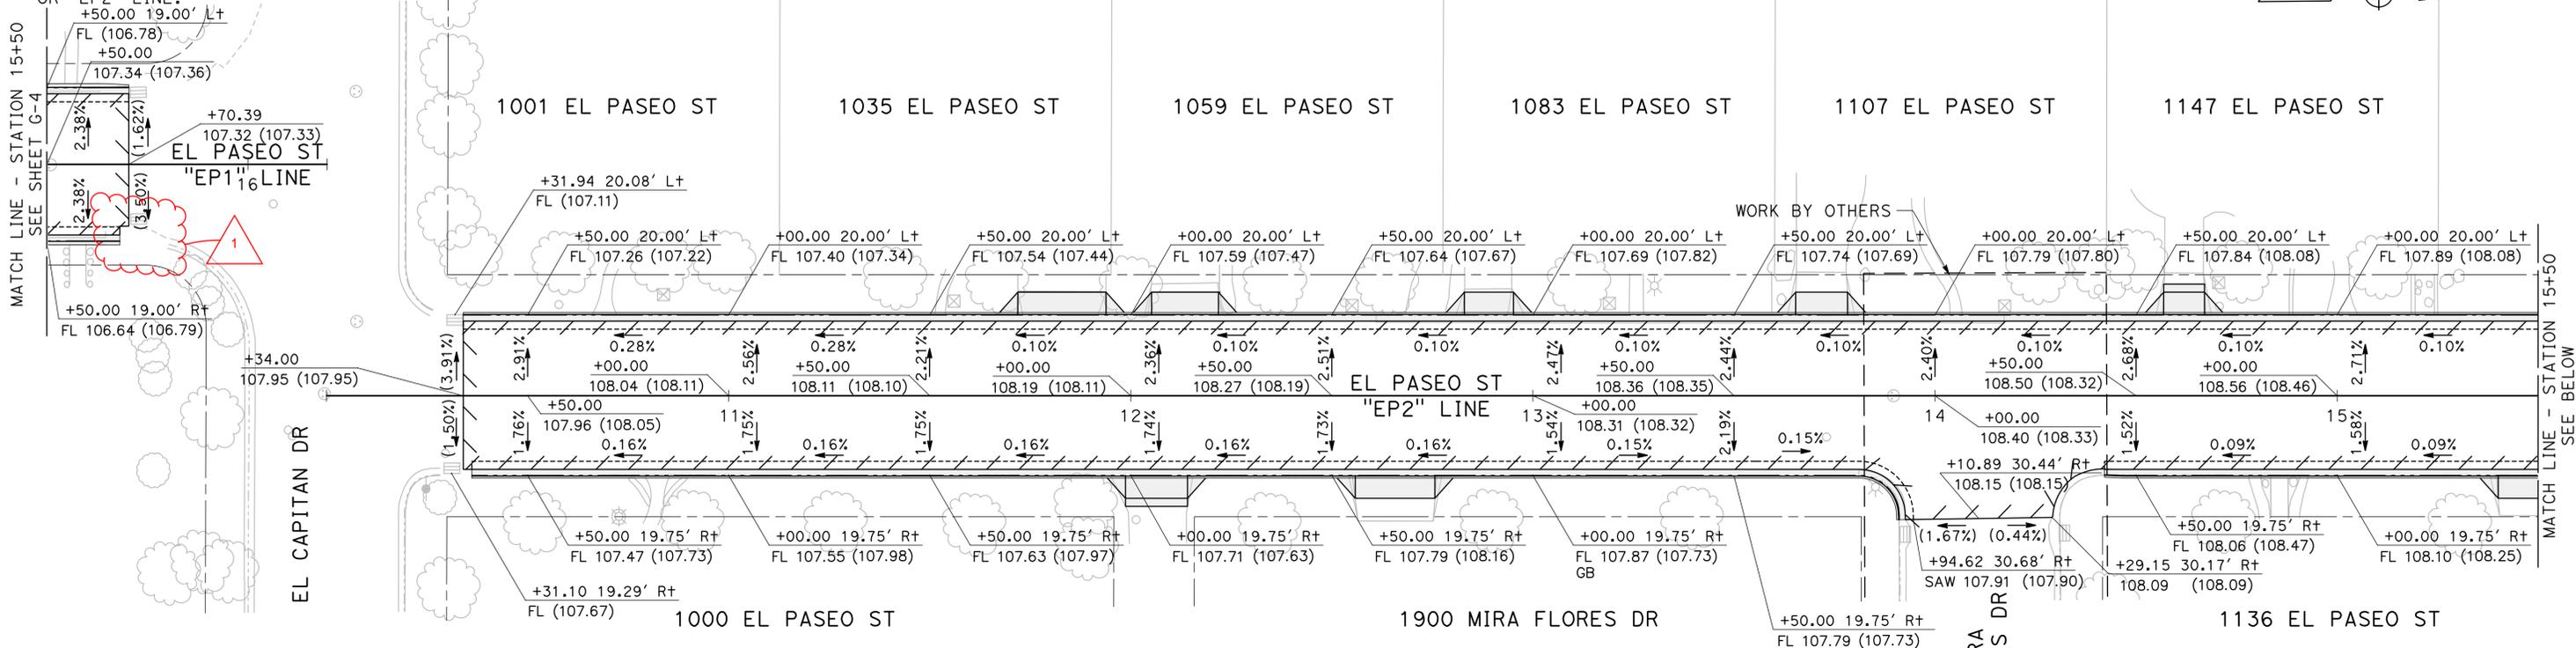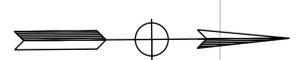


MATCH LINE - STATION 15+50
SEE BELOW

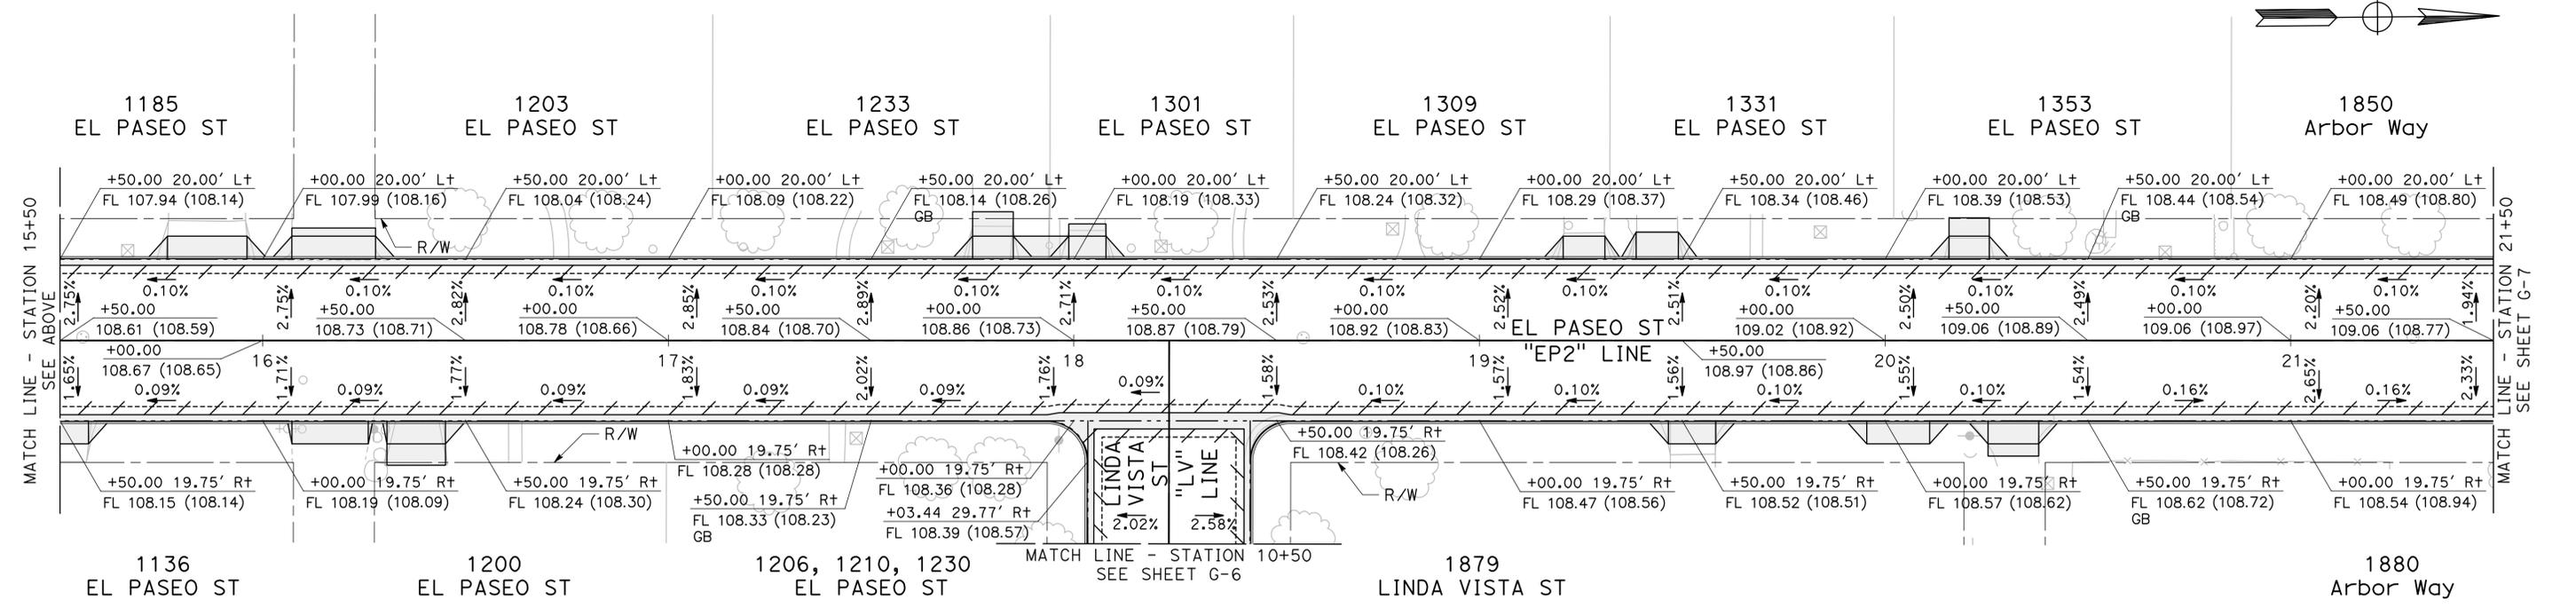

MATCH LINE - STATION 15+50
SEE ABOVE


MATCH LINE - STATION 21+50
SEE SHEET G-7

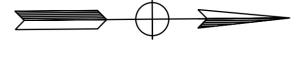

100% PLANS

DESIGNED BY: POORE, B.
DRAWN BY: FRANCO, N.
CHECKED BY: NORIEGA, E.
SCALE: 1"=20'
DATE: 5/21/2025
JOB NO.: 24-00061

NOTE:
ALL REFERENCES AND WRITTEN DIMENSIONS SHALL SUPERCEDE ALL SCALED DISTANCES AND SHALL BE VERIFIED IN THE FIELD. ANY DISCREPANCY SHALL BE BROUGHT TO THE ATTENTION OF THE ENGINEER PRIOR TO THE COMMENCEMENT OF WORK.

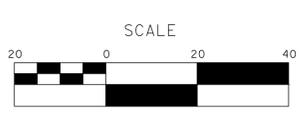

MARK THOMAS
701 UNIVERSITY AVENUE, SUITE 200
SACRAMENTO, CALIFORNIA 95825
(916) 381-9100 FAX:(916)381-9180
markthomas.com


CITY OF TURLOCK
MUNICIPAL SERVICES
DEPARTMENT
156 S. BROADWAY
SUITE 150
(209) 668-5520



**CITY OF TURLOCK
ROADS PROGRAM CIP
PROJECT 23-067 PACKAGE #3
GRADING PLANS**

Sheet **61**
of
126 Sheets
G - 5


NOTE:

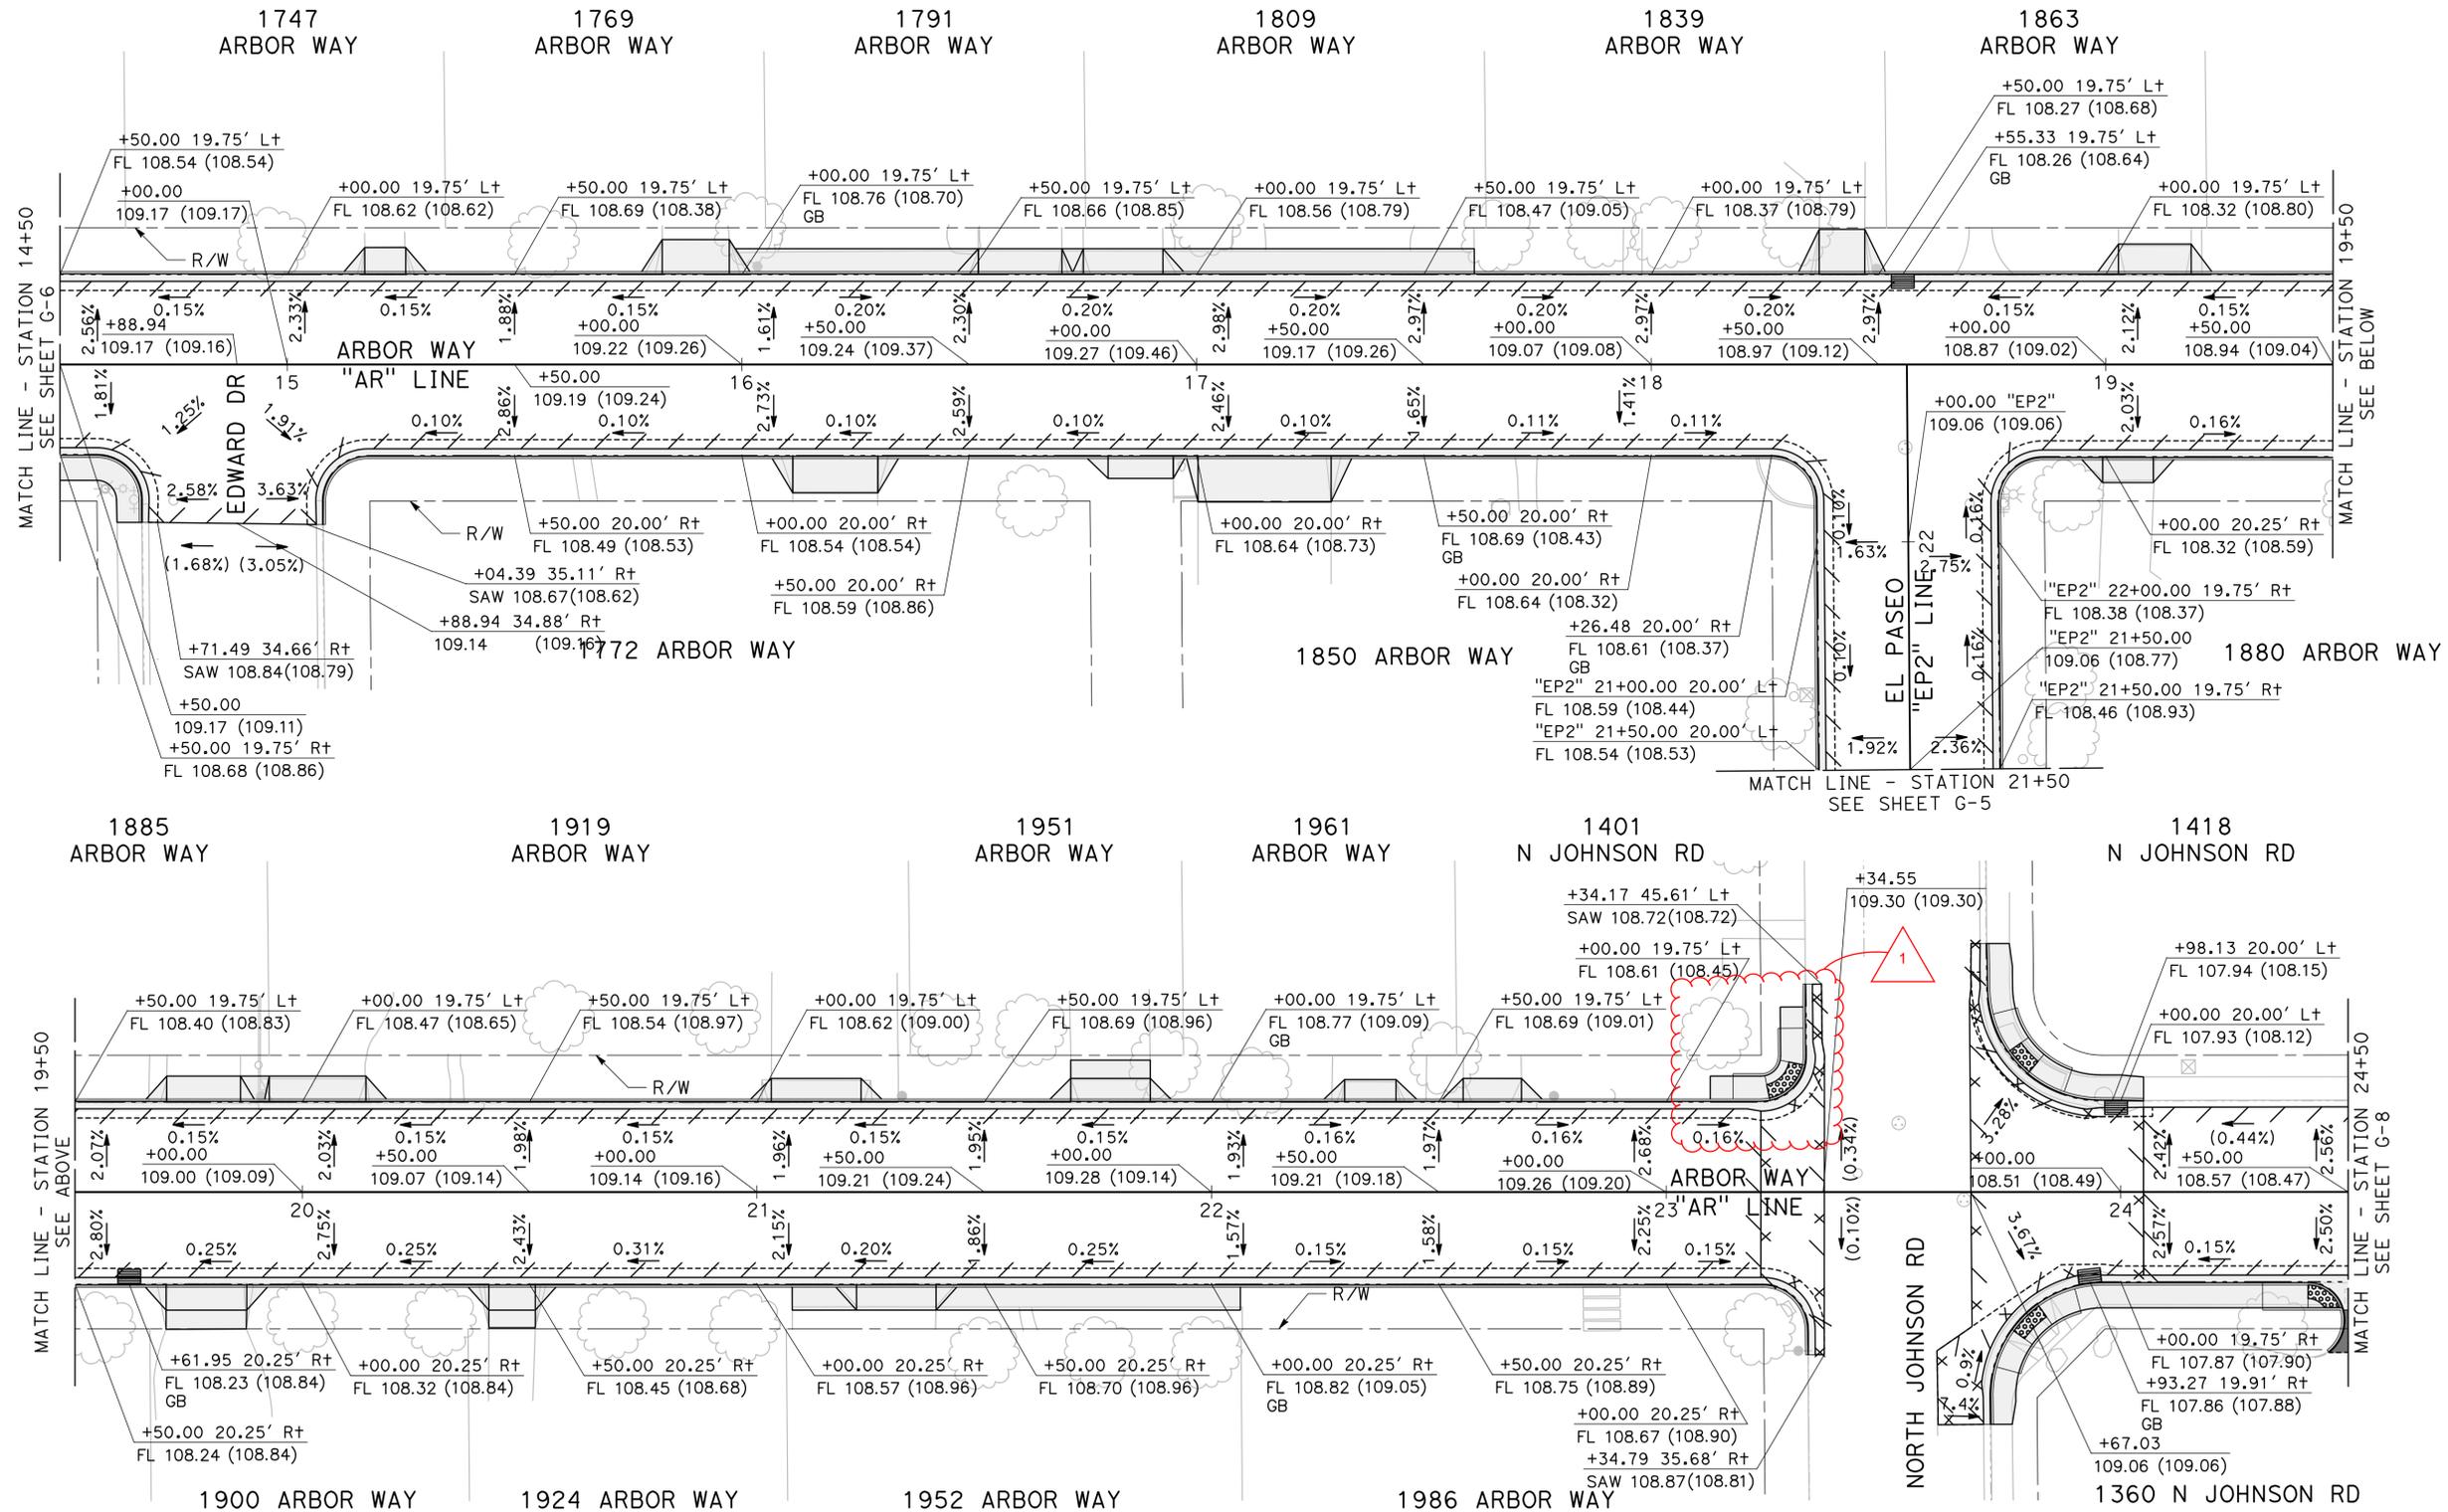

100% PLANS

DESIGNED BY: POORE, B.
 DRAWN BY: FRANCO, N.
 CHECKED BY: NORIEGA, E.
 SCALE: 1"=20'
 DATE: 5/21/2025
 JOB NO.: 24-00061

NOTE:
 ALL REFERENCES AND WRITTEN DIMENSIONS SHALL SUPERCEDE ALL SCALED DISTANCES AND SHALL BE VERIFIED IN THE FIELD. ANY DISCREPANCY SHALL BE BROUGHT TO THE ATTENTION OF THE ENGINEER PRIOR TO THE COMMENCEMENT OF WORK.

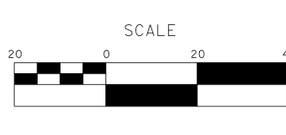

MARK THOMAS
 701 UNIVERSITY AVENUE, SUITE 200
 SACRAMENTO, CALIFORNIA 95825
 (916) 381-9100 FAX: (916) 381-9180
 markthomas.com


CITY OF TURLOCK
 MUNICIPAL SERVICES
 DEPARTMENT
 156 S. BROADWAY
 SUITE 150
 (209) 668-5520



**CITY OF TURLOCK
 ROADS PROGRAM CIP
 PROJECT 23-067 PACKAGE #3
 GRADING PLANS**

NOTE:


UNLESS SPECIFIED OTHERWISE, ALL STATIONS ON THIS SHEET ARE REFERENCED FROM THE "AR" LINE.

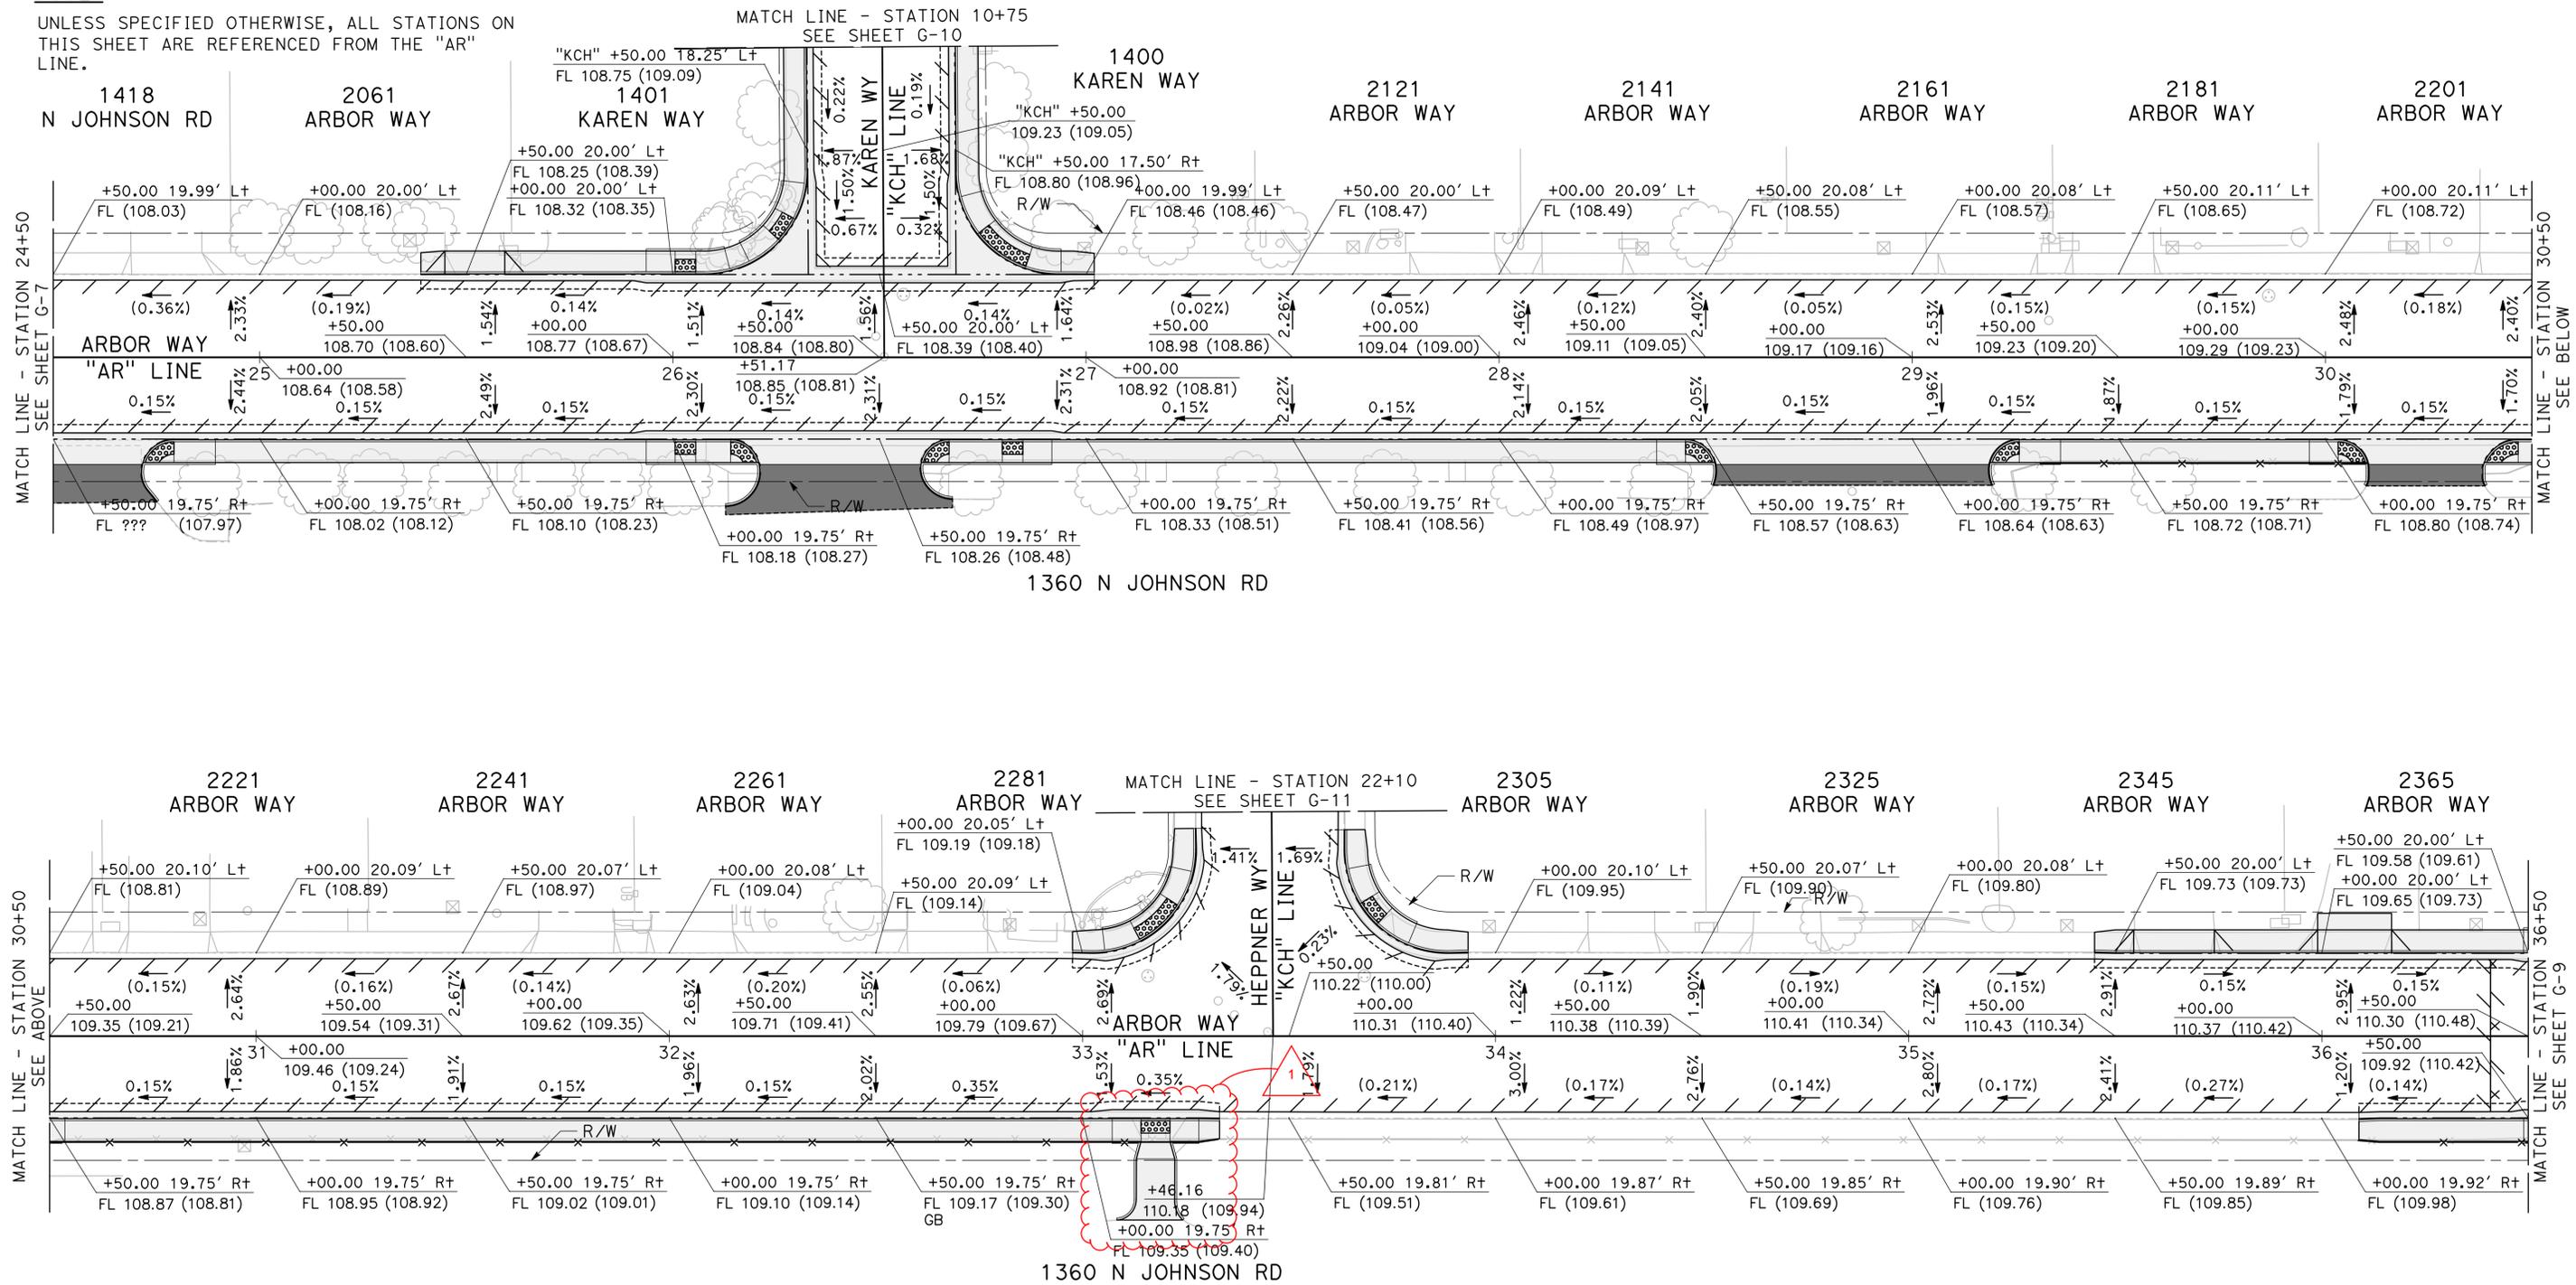

100% PLANS

DESIGNED BY: POORE, B.
 DRAWN BY: FRANCO, N.
 CHECKED BY: NORIEGA, E.
 SCALE: 1"=20'
 DATE: 5/21/2025
 JOB NO.: 24-00061

NOTE:
 ALL REFERENCES AND WRITTEN DIMENSIONS SHALL SUPERCEDE ALL SCALED DISTANCES AND SHALL BE VERIFIED IN THE FIELD. ANY DISCREPANCY SHALL BE BROUGHT TO THE ATTENTION OF THE ENGINEER PRIOR TO THE COMMENCEMENT OF WORK.

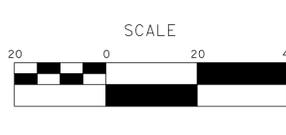

MARK THOMAS
 701 UNIVERSITY AVENUE, SUITE 200
 SACRAMENTO, CALIFORNIA 95825
 (916) 381-9100 FAX:(916)381-9180
 markthomas.com

CITY OF TURLOCK
 MUNICIPAL SERVICES
 DEPARTMENT
 156 S. BROADWAY
 SUITE 150
 (209) 668-5520




**CITY OF TURLOCK
 ROADS PROGRAM CIP
 PROJECT 23-067 PACKAGE #3
 GRADING PLANS**

Sheet **64**
 of
126 Sheets
G - 8

NOTE:


1. UNLESS SPECIFIED OTHERWISE, ALL STATIONS ON THIS SHEET ARE REFERENCED FROM THE "KCH" LINE.

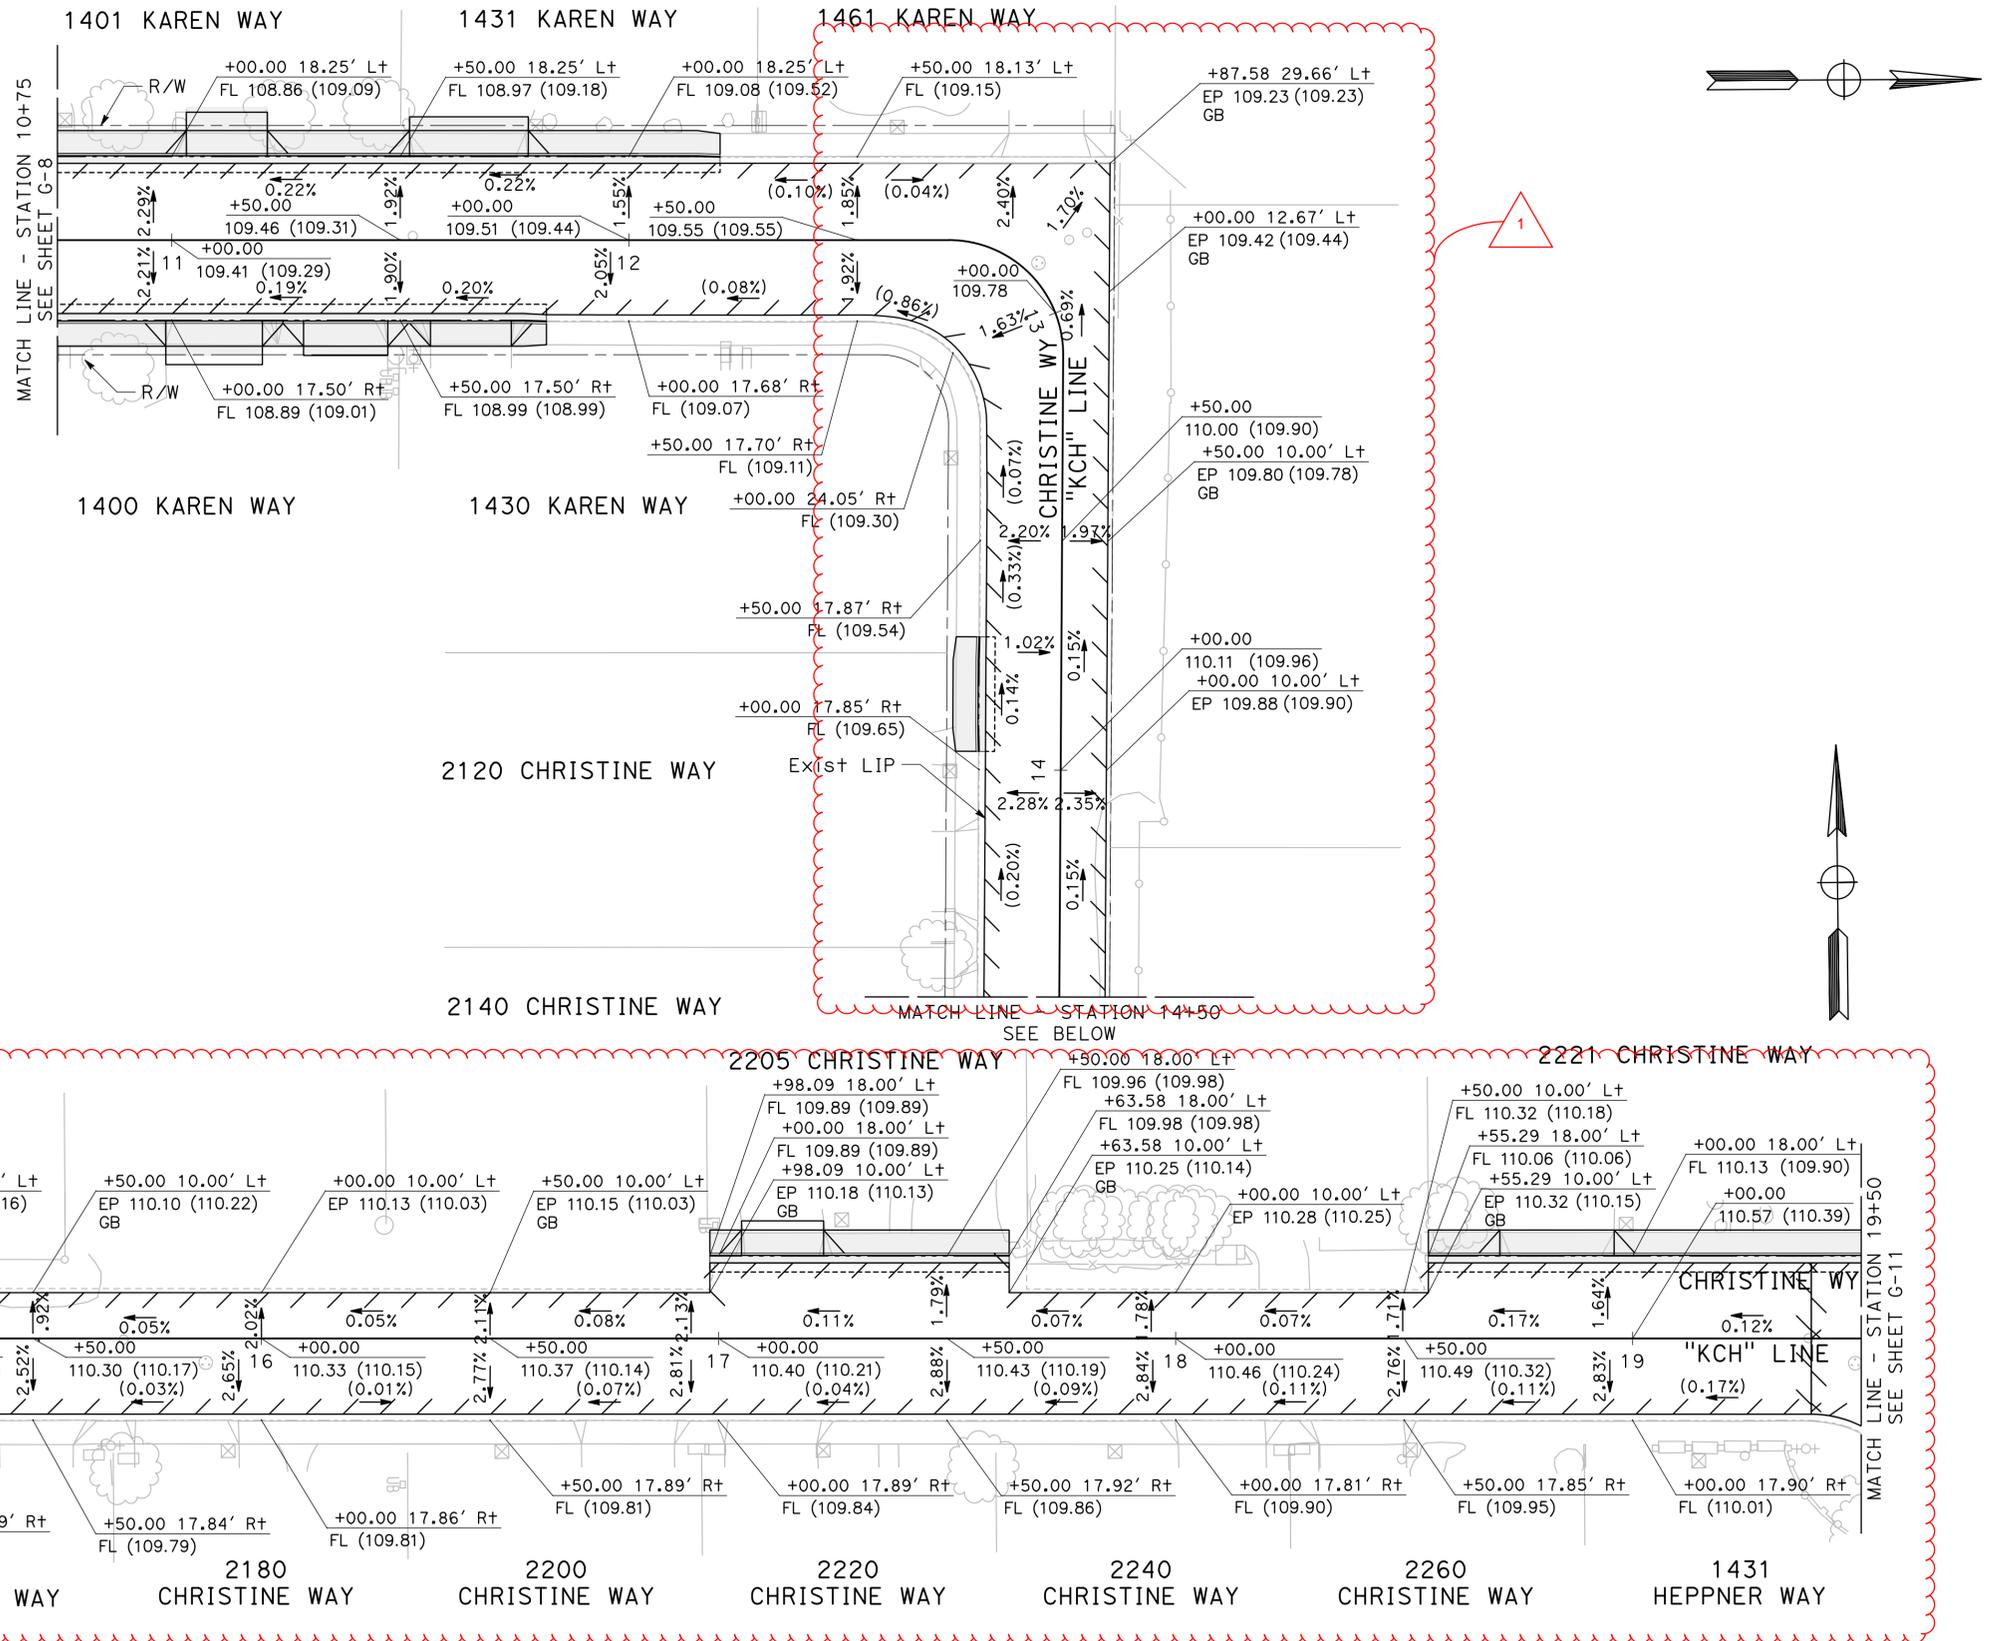

100% PLANS

DESIGNED BY: POORE, B.
 DRAWN BY: FRANCO, N.
 CHECKED BY: NORIEGA, E.
 SCALE: 1"=20'
 DATE: 5/21/2025
 JOB NO.: 24-00061

NOTE:
 ALL REFERENCES AND WRITTEN DIMENSIONS SHALL SUPERCEDE ALL SCALED DISTANCES AND SHALL BE VERIFIED IN THE FIELD. ANY DISCREPANCY SHALL BE BROUGHT TO THE ATTENTION OF THE ENGINEER PRIOR TO THE COMMENCEMENT OF WORK.

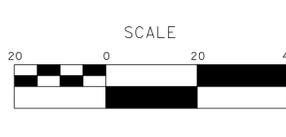

MARK THOMAS
 701 UNIVERSITY AVENUE, SUITE 200
 SACRAMENTO, CALIFORNIA 95825
 (916) 381-9100 FAX: (916) 381-9180
 markthomas.com

CITY OF TURLOCK
 MUNICIPAL SERVICES
 DEPARTMENT
 156 S. BROADWAY
 SUITE 150
 (209) 668-5520




**CITY OF TURLOCK
 ROADS PROGRAM CIP
 PROJECT 23-067 PACKAGE #3
 GRADING PLANS**

Sheet **66**
 of
126 Sheets
G-10

NOTE:


UNLESS SPECIFIED OTHERWISE, ALL STATIONS ARE REFERENCED FROM THE "KCH" OR "NO" LINE.

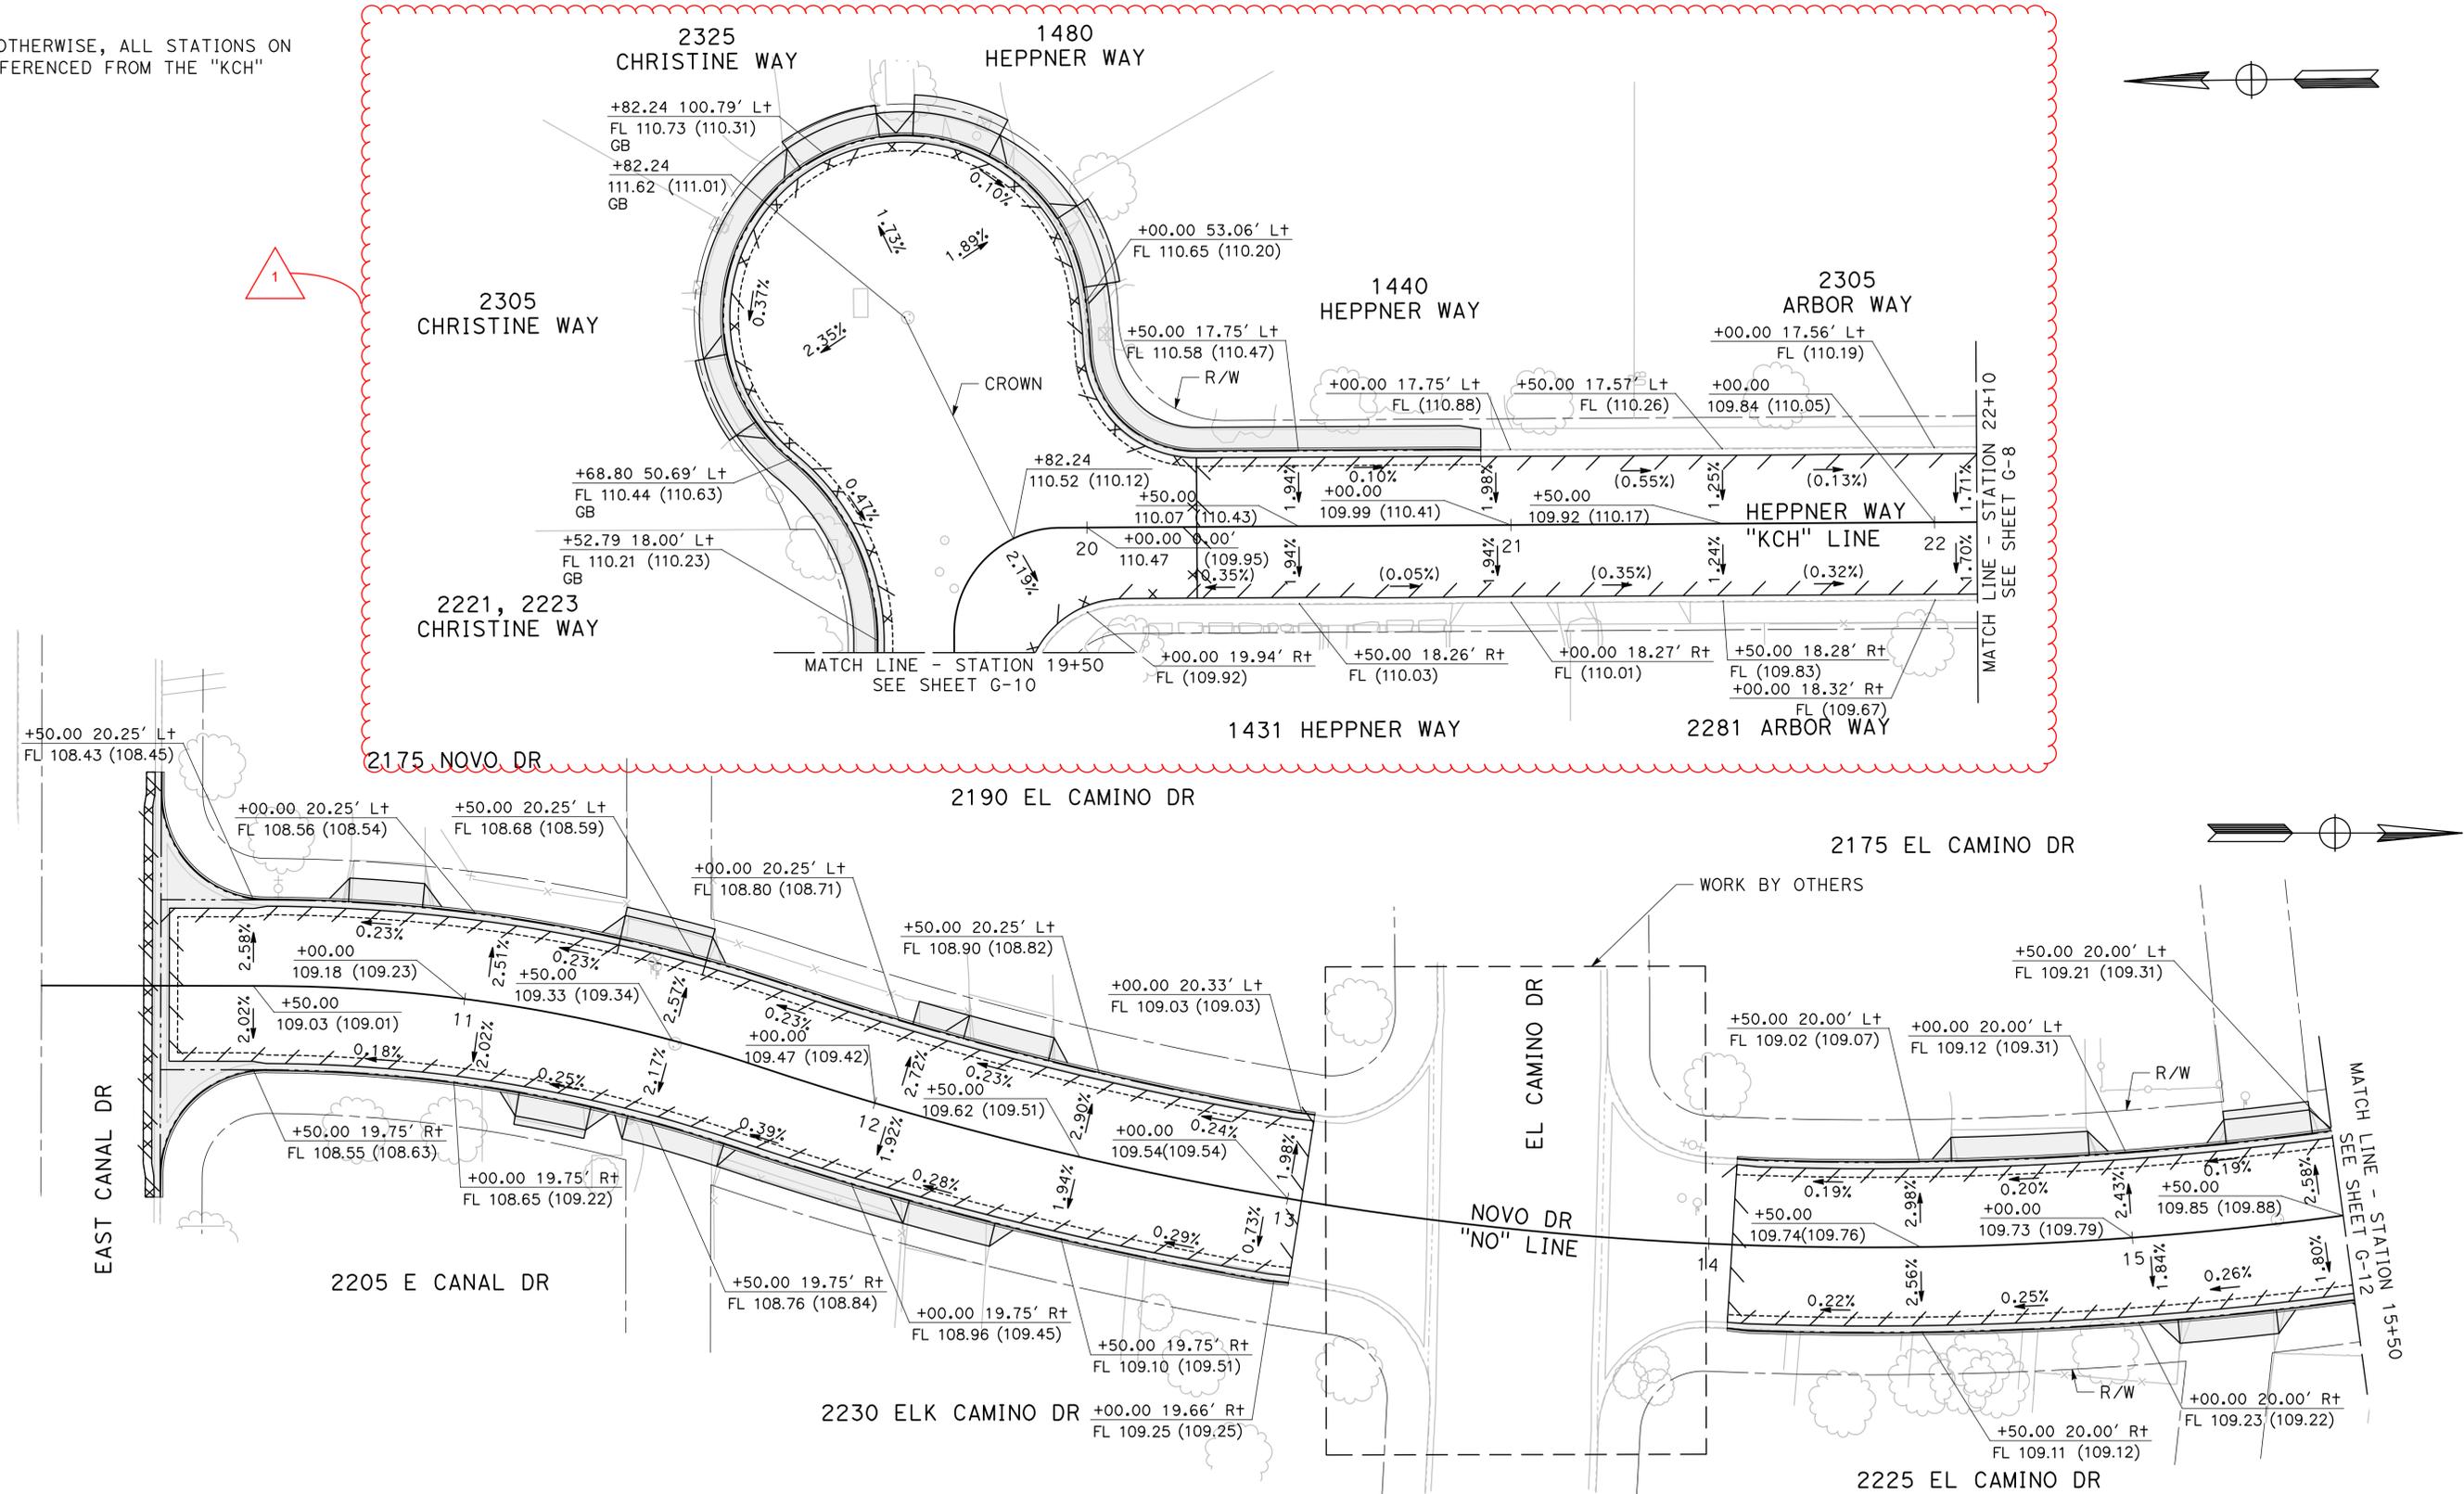

100% PLANS

DESIGNED BY: POORE, B.
 DRAWN BY: FRANCO, N.
 CHECKED BY: NORIEGA, E.
 SCALE: 1"=20'
 DATE: 5/21/2025
 JOB NO.: 24-00061

NOTE:
 ALL REFERENCES AND WRITTEN DIMENSIONS SHALL SUPERCEDE ALL SCALED DISTANCES AND SHALL BE VERIFIED IN THE FIELD. ANY DISCREPANCY SHALL BE BROUGHT TO THE ATTENTION OF THE ENGINEER PRIOR TO THE COMMENCEMENT OF WORK.

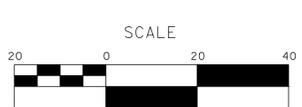


MARK THOMAS
 701 UNIVERSITY AVENUE, SUITE 200
 SACRAMENTO, CALIFORNIA 95825
 (916) 381-9100 FAX:(916)381-9180
 markthomas.com

CITY OF TURLOCK
 MUNICIPAL SERVICES
 DEPARTMENT
 156 S. BROADWAY
 SUITE 150
 (209) 668-5520



**CITY OF TURLOCK
 ROADS PROGRAM CIP
 PROJECT 23-067 PACKAGE #3
 GRADING PLANS**

Sheet **67**
 of
126 Sheets
G-11

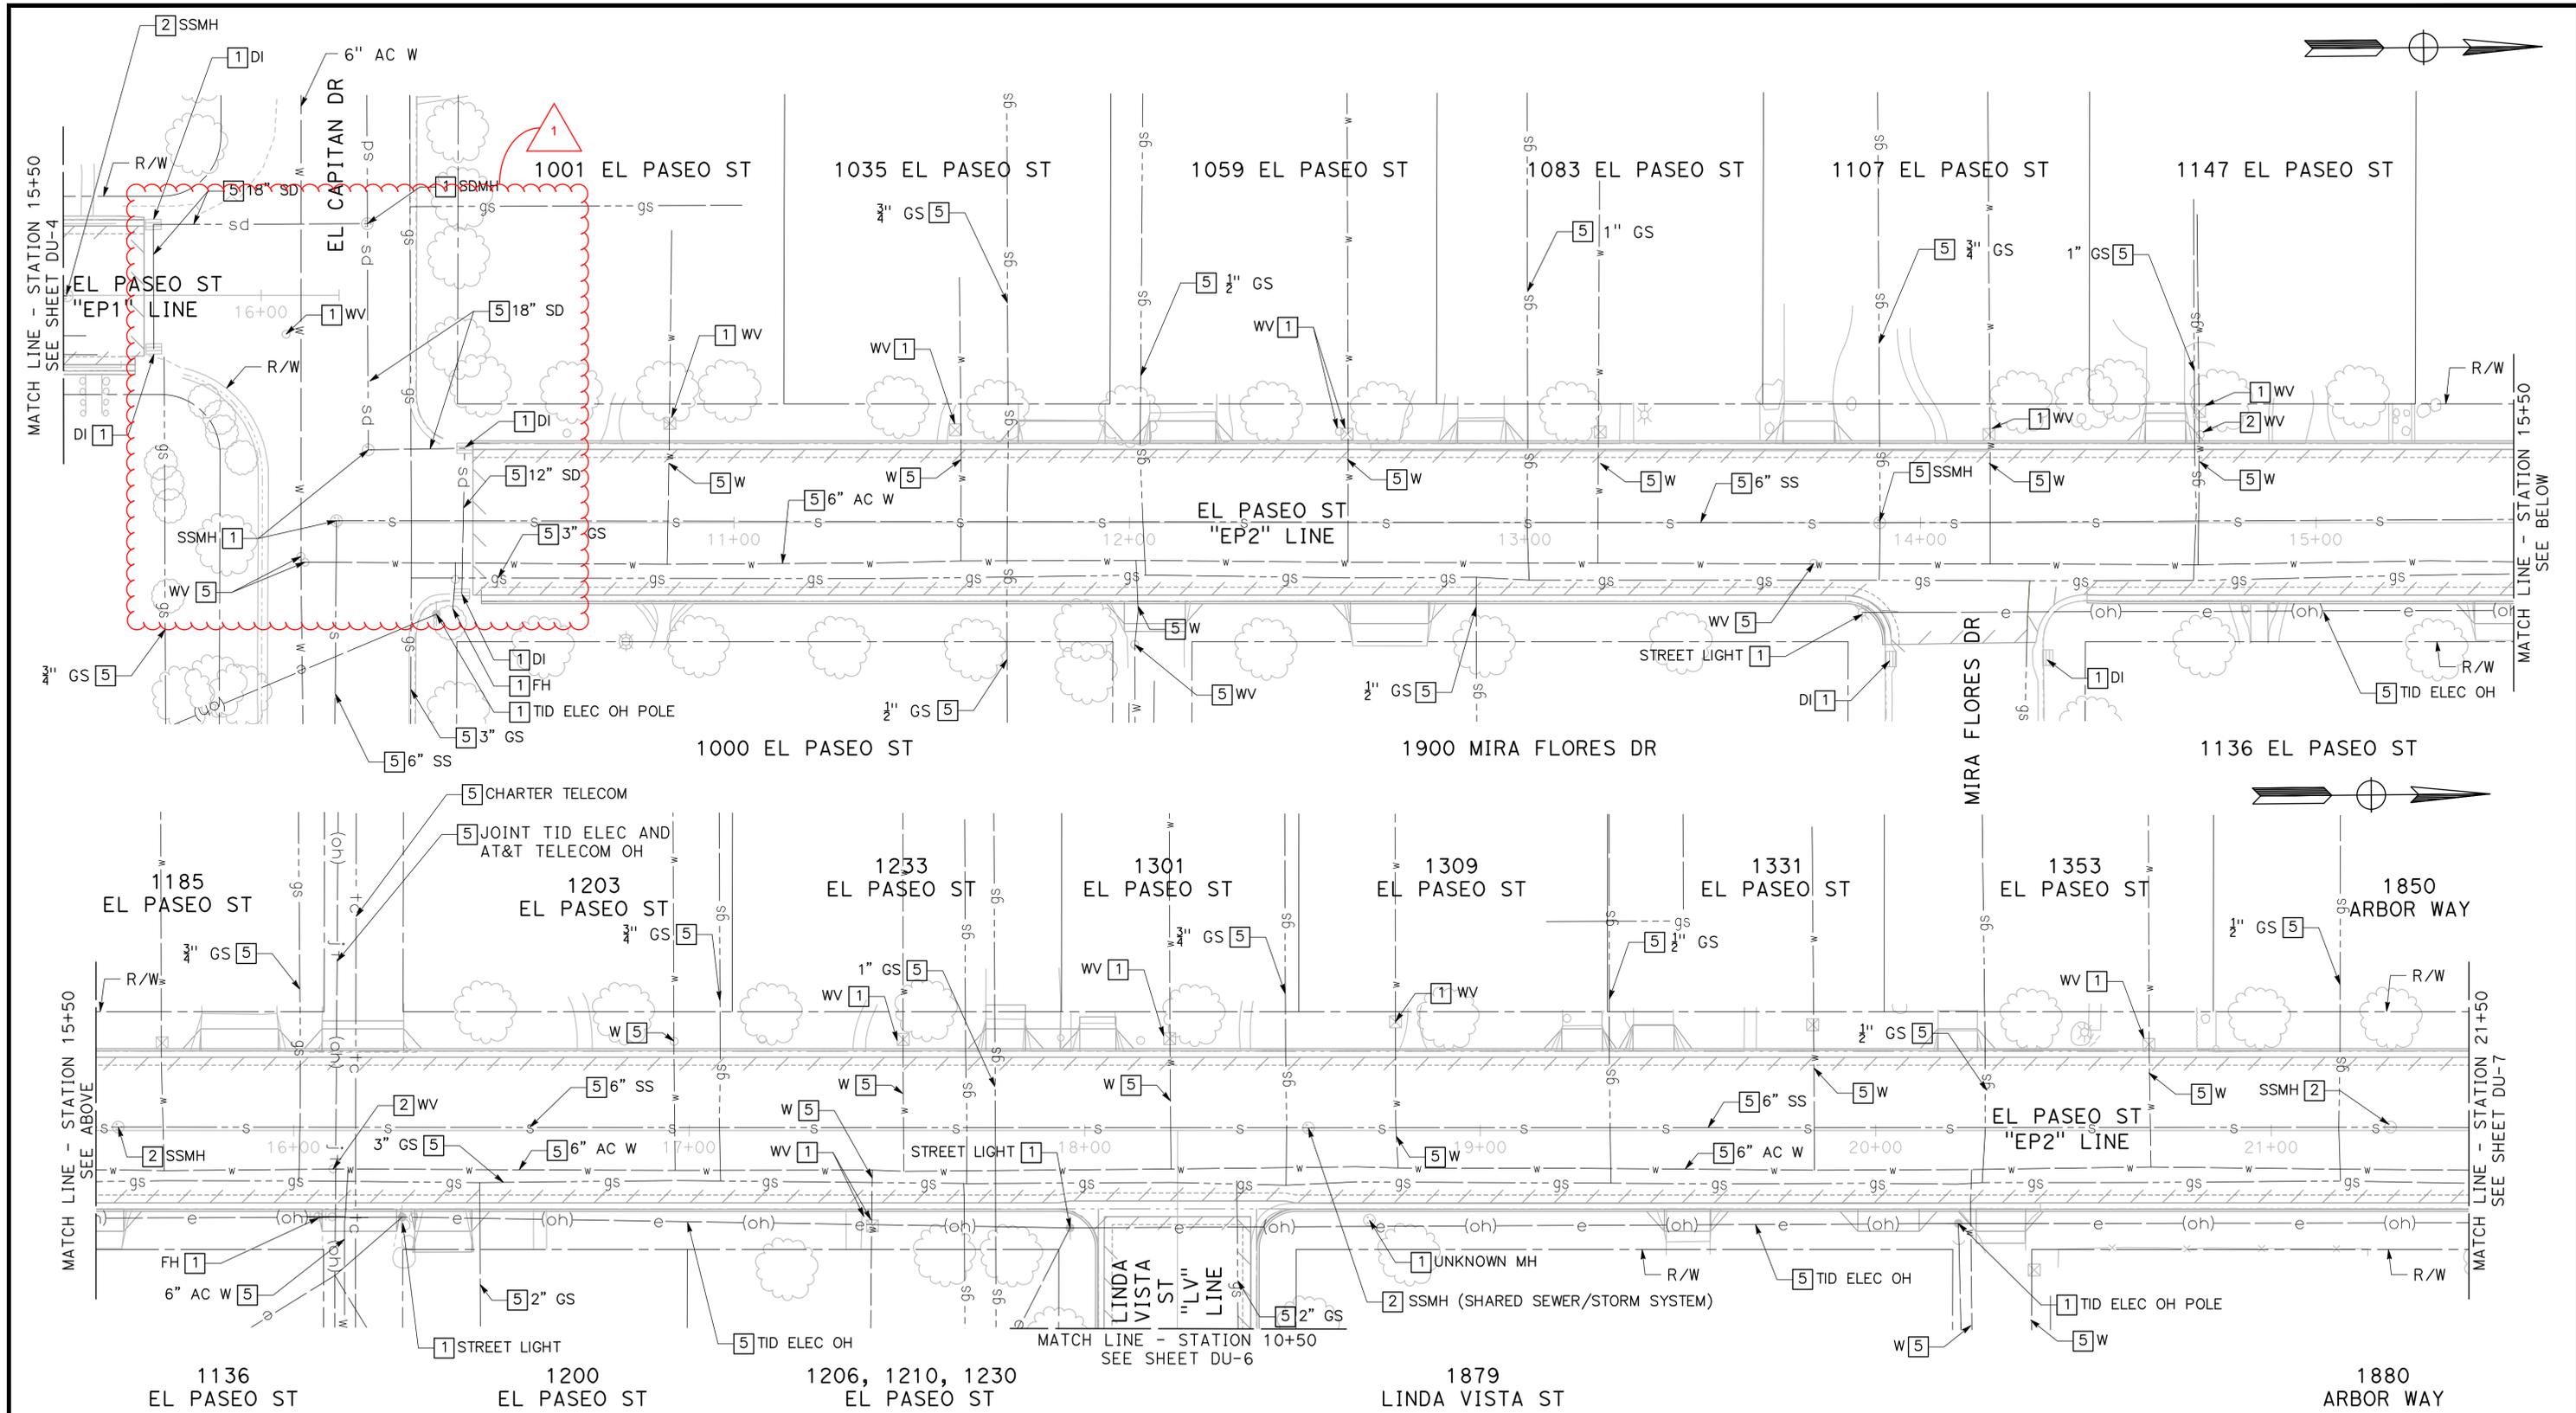

100% PLANS

DESIGNED BY: POORE, B.
 DRAWN BY: FRANCO, N.
 CHECKED BY: NORIEGA, E.
 SCALE: 1"=20'
 DATE: 5/21/2025
 JOB NO.: 24-00061

NOTE:
 ALL REFERENCES AND WRITTEN DIMENSIONS SHALL SUPERCEDE ALL SCALED DISTANCES AND SHALL BE VERIFIED IN THE FIELD. ANY DISCREPANCY SHALL BE BROUGHT TO THE ATTENTION OF THE ENGINEER PRIOR TO THE COMMENCEMENT OF WORK.





MARK THOMAS
 701 UNIVERSITY AVENUE, SUITE 200
 SACRAMENTO, CALIFORNIA 95825
 (916) 381-9100 FAX:(916)381-9180
 markthomas.com

CITY OF TURLOCK
 MUNICIPAL SERVICES
 DEPARTMENT
 156 S. BROADWAY
 SUITE 150
 (209) 668-5520



CITY OF TURLOCK
ROADS PROGRAM CIP
PROJECT 23-067 PACKAGE #3
DRAINAGE AND UTILITIES


Sheet **76**
 of
126 Sheets
DU-5

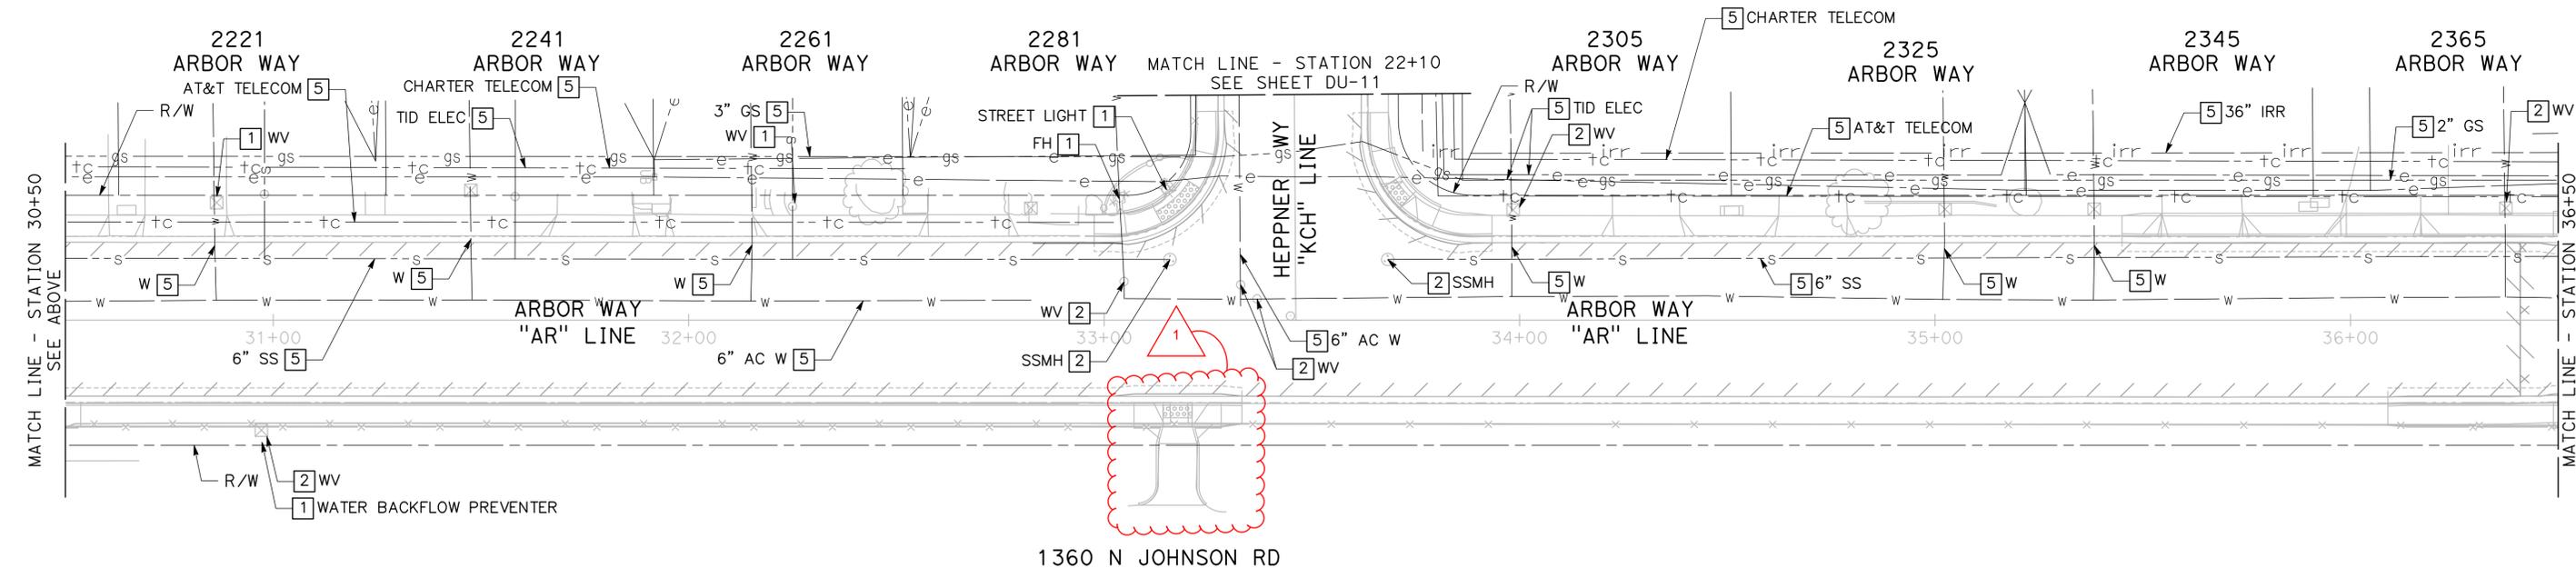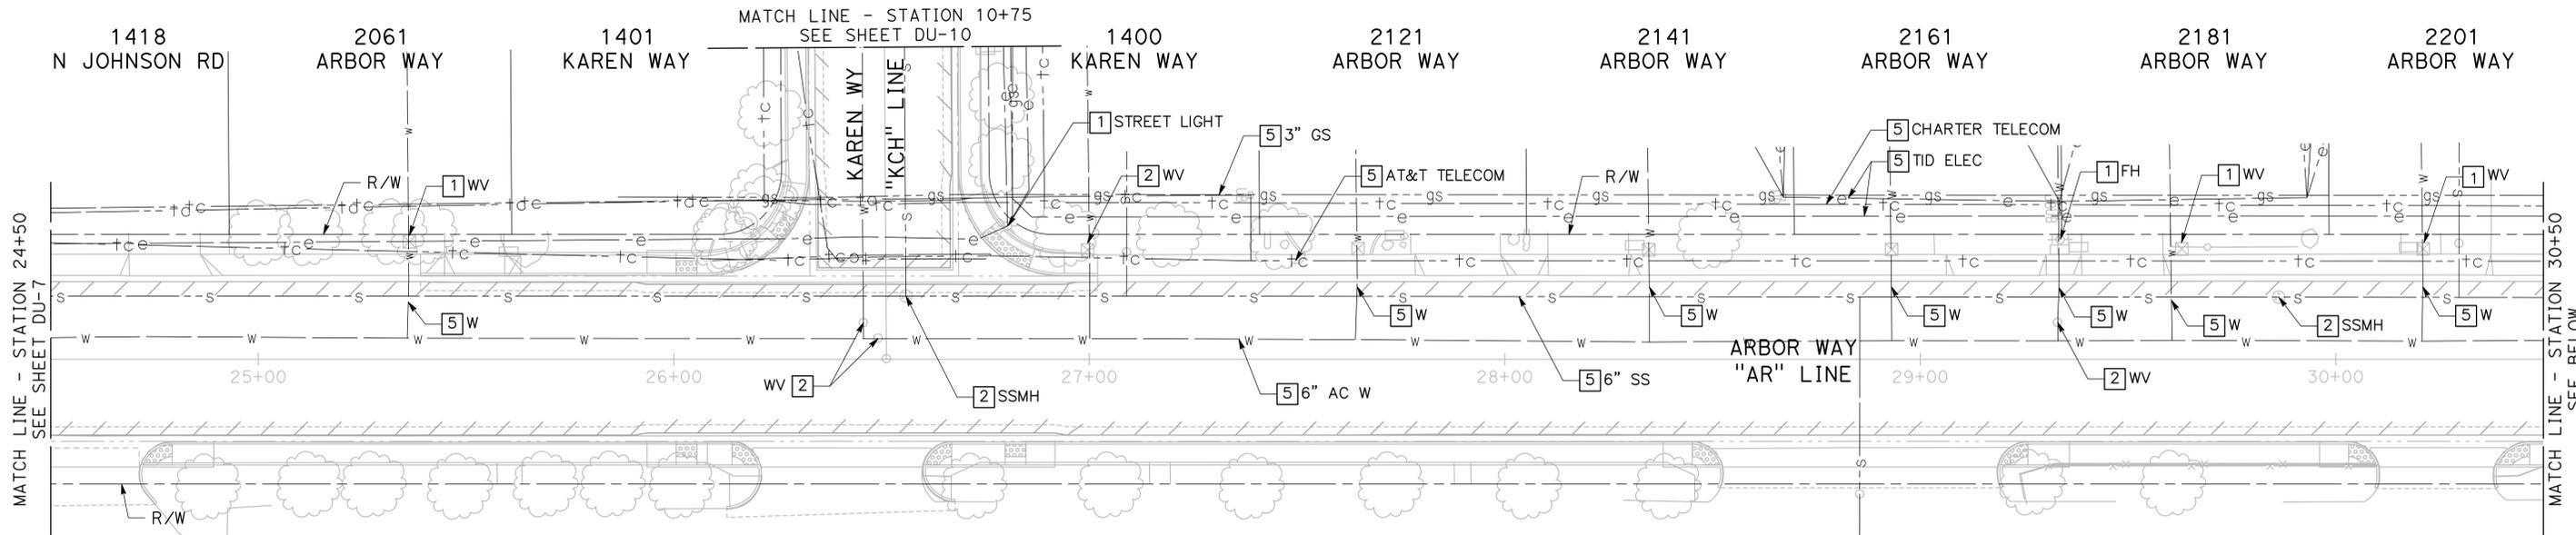

100% PLANS

DESIGNED BY: POORE, B.
 DRAWN BY: FRANCO, N.
 CHECKED BY: NORIEGA, E.
 SCALE: 1"=20'
 DATE: 5/21/2025
 JOB NO.: 24-00061

NOTE:
 ALL REFERENCES AND WRITTEN DIMENSIONS SHALL SUPERCEDE ALL SCALED DISTANCES AND SHALL BE VERIFIED IN THE FIELD. ANY DISCREPANCY SHALL BE BROUGHT TO THE ATTENTION OF THE ENGINEER PRIOR TO THE COMMENCEMENT OF WORK.

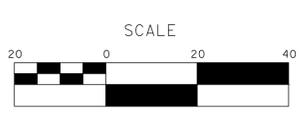


MARK THOMAS
 701 UNIVERSITY AVENUE, SUITE 200
 SACRAMENTO, CALIFORNIA 95825
 (916) 381-9100 FAX:(916)381-9180
 markthomas.com

CITY OF TURLOCK
 MUNICIPAL SERVICES DEPARTMENT
 156 S. BROADWAY
 SUITE 150
 (209) 668-5520



CITY OF TURLOCK
ROADS PROGRAM CIP
PROJECT 23-067 PACKAGE #3
DRAINAGE AND UTILITIES


Sheet **79**
 of
126 Sheets
DU-8

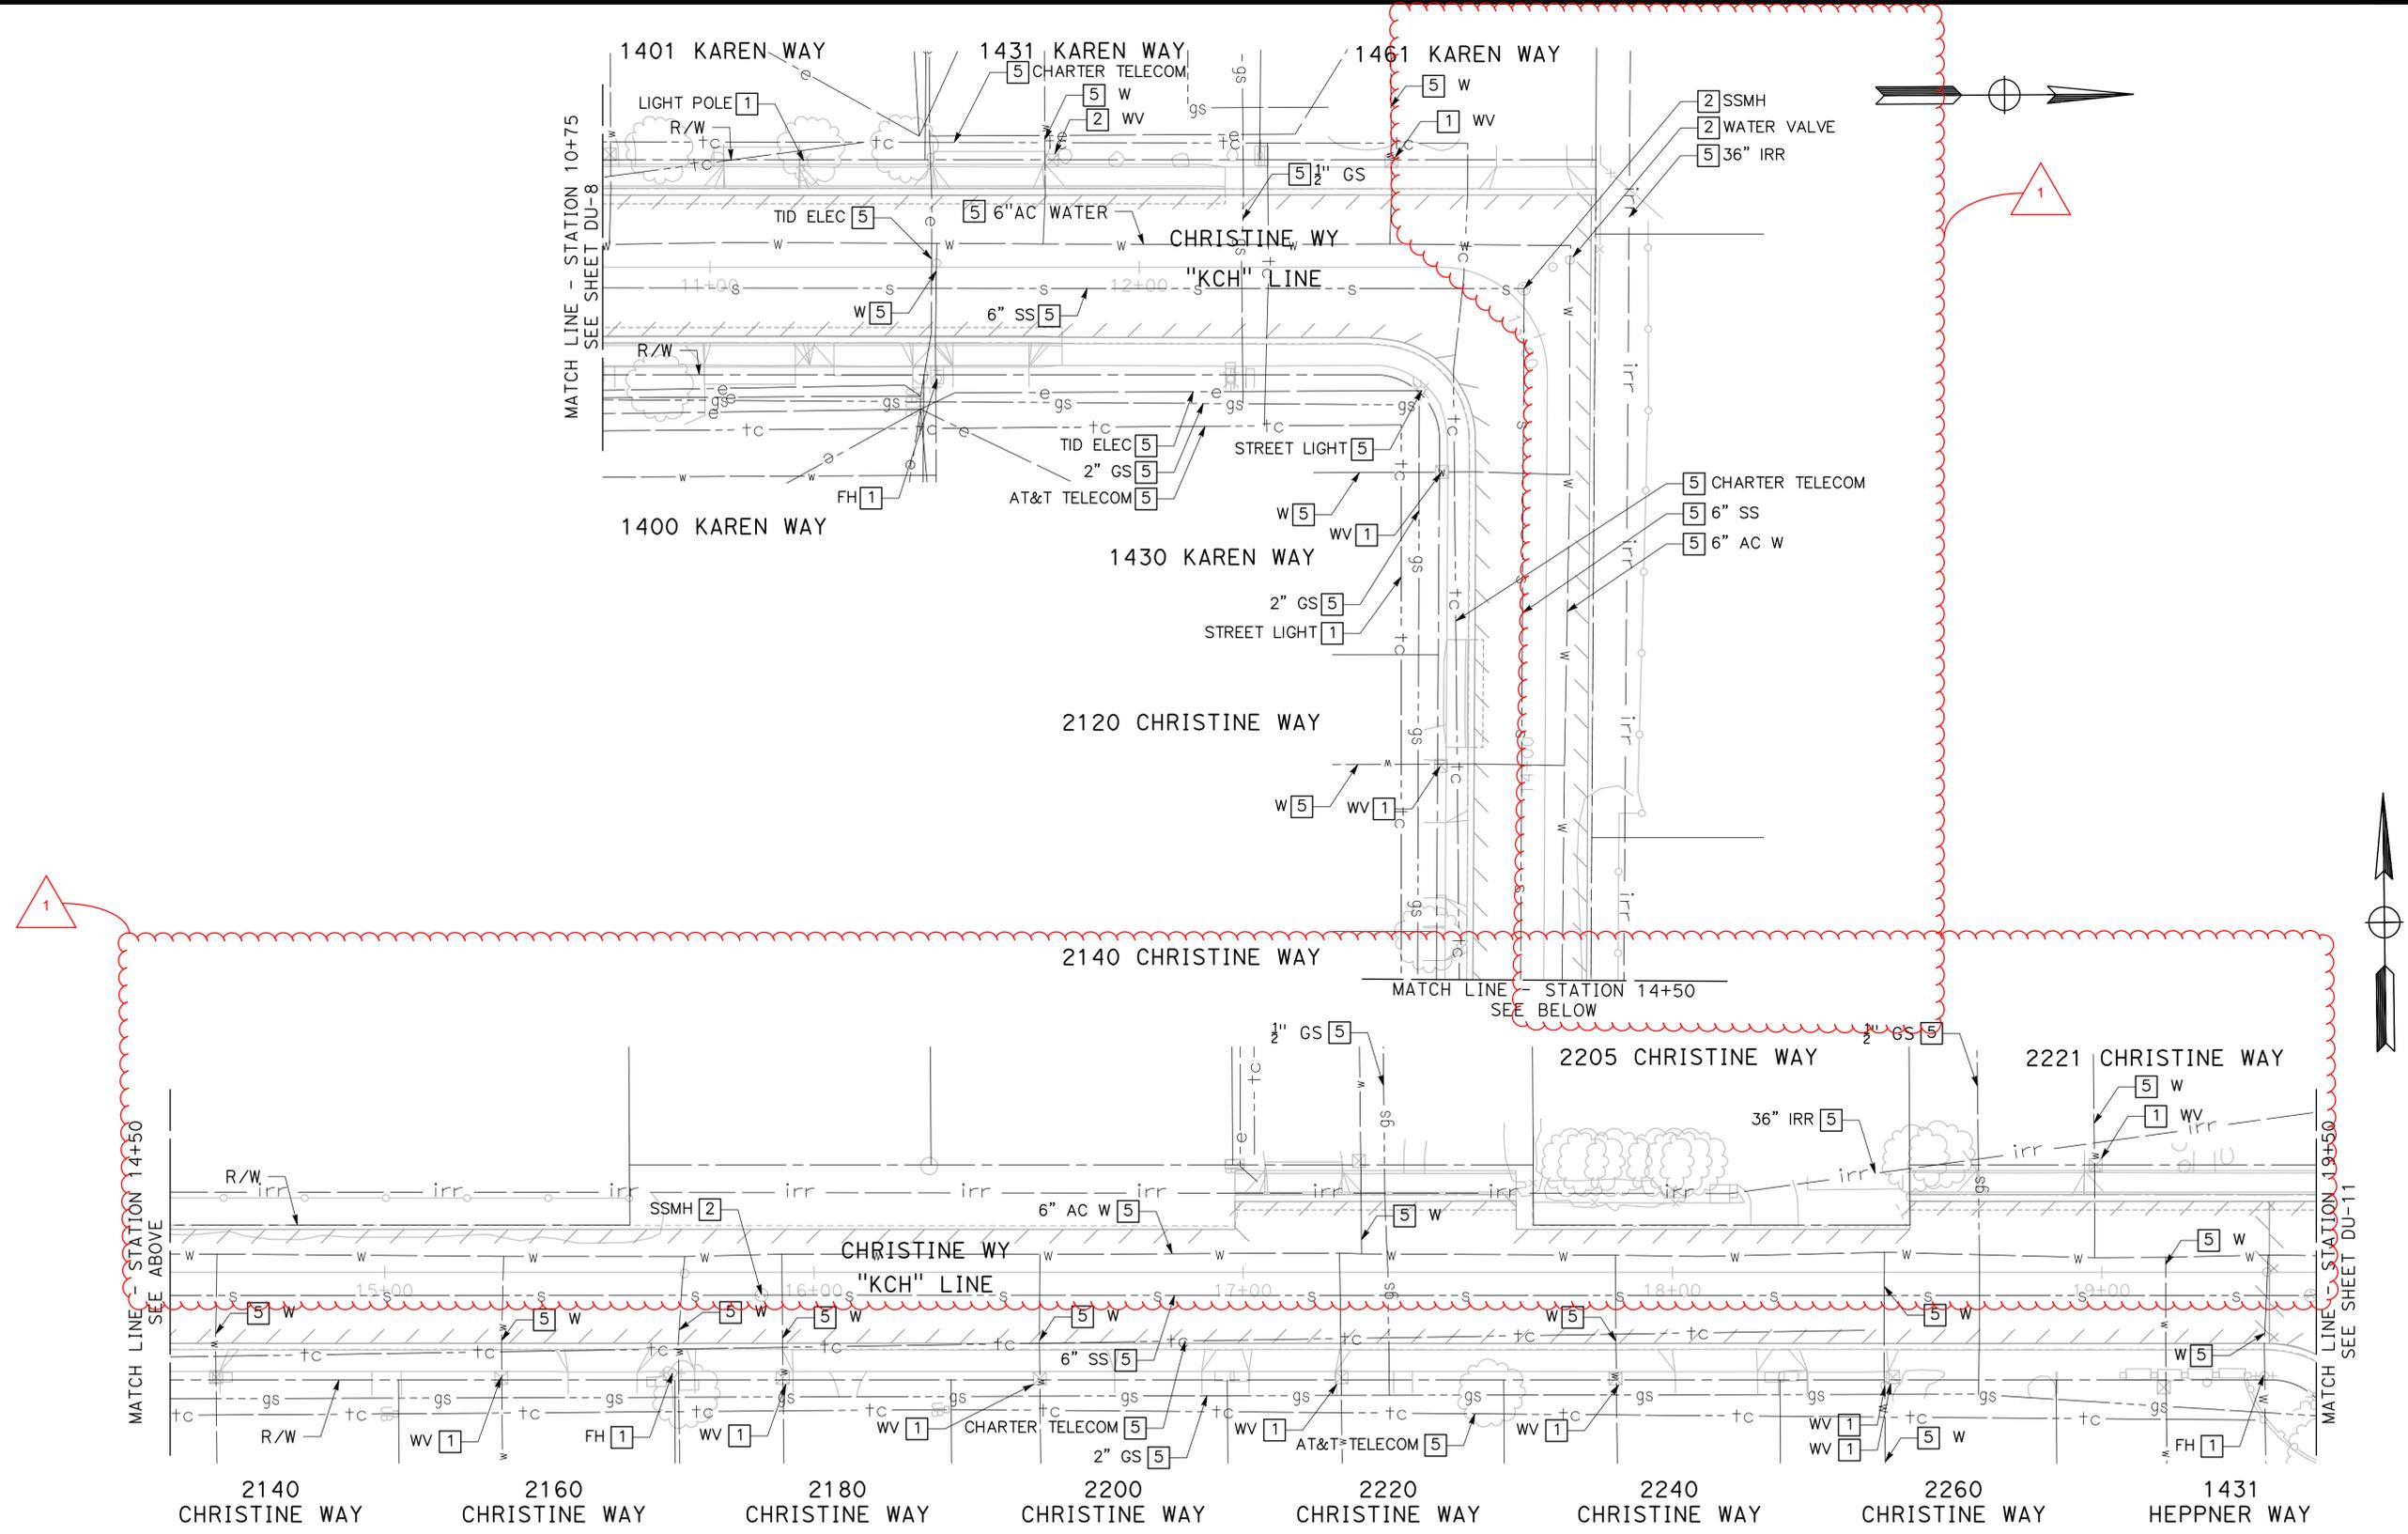

100% PLANS

DESIGNED BY: POORE, B.
 DRAWN BY: FRANCO, N.
 CHECKED BY: NORIEGA, E.
 SCALE: 1"=20'
 DATE: 5/21/2025
 JOB NO.: 24-00061

NOTE:
 ALL REFERENCES AND WRITTEN DIMENSIONS SHALL SUPERCEDE ALL SCALED DISTANCES AND SHALL BE VERIFIED IN THE FIELD. ANY DISCREPANCY SHALL BE BROUGHT TO THE ATTENTION OF THE ENGINEER PRIOR TO THE COMMENCEMENT OF WORK.

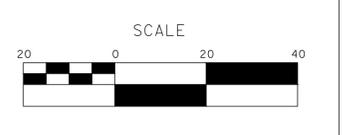


MARK THOMAS
 701 UNIVERSITY AVENUE, SUITE 200
 SACRAMENTO, CALIFORNIA 95825
 (916) 381-9100 FAX:(916)381-9180
 markthomas.com

CITY OF TURLOCK
 MUNICIPAL SERVICES DEPARTMENT
 156 S. BROADWAY
 SUITE 150
 (209) 668-5520



CITY OF TURLOCK
ROADS PROGRAM CIP
PROJECT 23-067 PACKAGE #3
DRAINAGE AND UTILITIES

Sheet **81**
 of
126 Sheets
DU-10

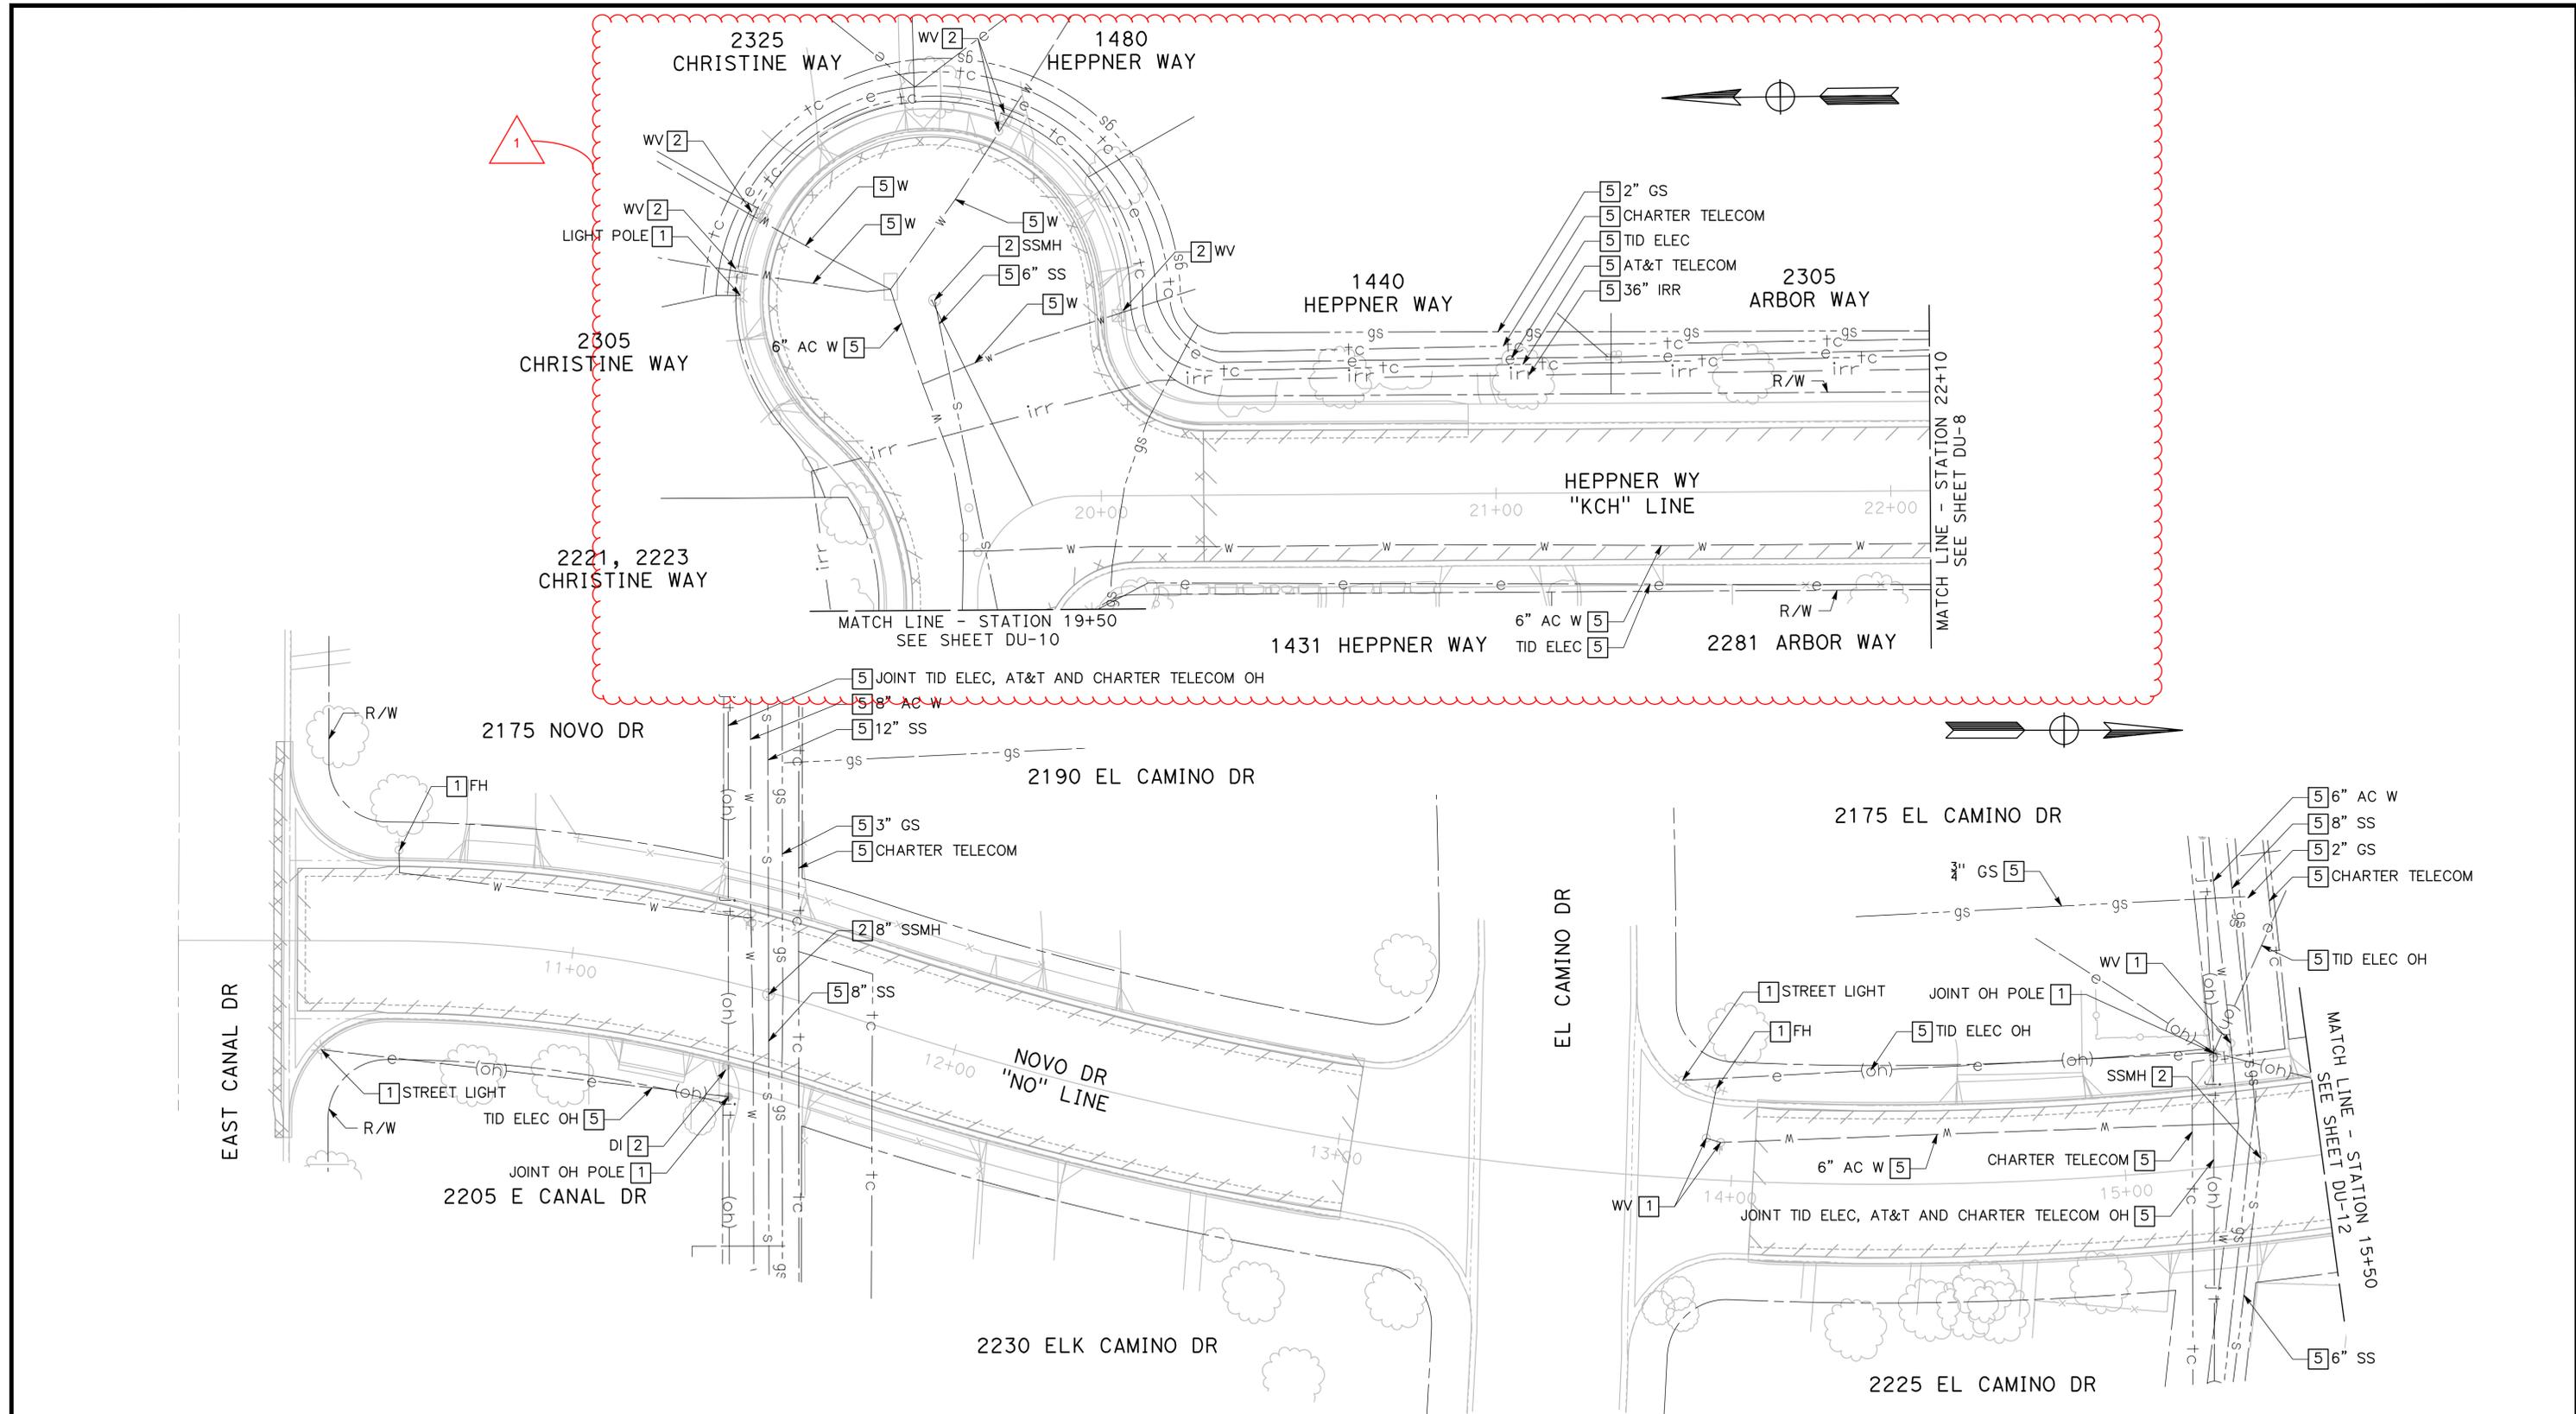

100% PLANS

DESIGNED BY: POORE, B.
 DRAWN BY: FRANCO, N.
 CHECKED BY: NORIEGA, E.
 SCALE: 1"=20'
 DATE: 5/21/2025
 JOB NO.: 24-00061

NOTE:
 ALL REFERENCES AND WRITTEN DIMENSIONS SHALL SUPERCEDE ALL SCALED DISTANCES AND SHALL BE VERIFIED IN THE FIELD. ANY DISCREPANCY SHALL BE BROUGHT TO THE ATTENTION OF THE ENGINEER PRIOR TO THE COMMENCEMENT OF WORK.



MARK THOMAS
 701 UNIVERSITY AVENUE, SUITE 200
 SACRAMENTO, CALIFORNIA 95825
 (916) 381-9100 FAX:(916)381-9180
 markthomas.com

CITY OF TURLOCK
 MUNICIPAL SERVICES DEPARTMENT
 156 S. BROADWAY
 SUITE 150
 (209) 668-5520



**CITY OF TURLOCK
 ROADS PROGRAM CIP
 PROJECT 23-067 PACKAGE #3
 DRAINAGE AND UTILITIES**

Sheet **82**
 of
126 Sheets
DU-11


NOTES (SHEETS UUD-1 TO UUD-15):

1. THE CONTRACTOR SHALL VERIFY LOCATIONS OF ALL EXISTING UNDERGROUND UTILITIES AND SHALL CONTACT THE RESPECTIVE UTILITY COMPANIES PRIOR TO COMMENCEMENT OF WORK. THE CONTRACTOR SHALL BE RESPONSIBLE FOR THE LOCATION AND PRESERVATION OF ALL SUCH FACILITIES IN THE AREA OF CONSTRUCTION AND SHALL NOTIFY UNDERGROUND SERVICE ALERT OF NORTHERN CALIFORNIA FORTY-EIGHT (48) HOURS IN ADVANCE OF ANY CONSTRUCTION.
2. THE CONTRACTOR SHALL BE RESPONSIBLE FOR COORDINATION OF THE REMOVAL OR RELOCATIONS OF ALL EXISTING UTILITIES WITH RESPECTIVE UTILITY COMPANIES.
3. MANHOLE CASTINGS AND COVERS SHALL BE ADJUSTED TO FINAL GRADES BY THE CONTRACTOR AFTER STREET IMPROVEMENTS ARE COMPLETED. ALL EXISTING MANHOLE LIDS WITHIN LIMITS OF STREET IMPROVEMENT SHALL BE MARKED AND TIED TO SURVEY PRIOR TO ADJUSTMENT.
4. FOR CLARITY, OH UTILITIES WILL NOT BE SHOWN ON THE UNDERGROUND UTILITY DEPTHS SHEETS. INFORMATION REGARDING OH UTILITIES CAN BE FOUND ON DRAINAGE AND UTILITIES SHEETS.

5. DEPTHS SHOWN ON THESE SHEETS WERE OBTAINED USING SUBSURFACE UTILITY ENGINEERING METHODS INCLUDING GROUND PENETRATING RADAR. THIS DATA IS PROVIDED FOR INFORMATIONAL PURPOSES ONLY AND IT IS THE CONTRACTOR'S RESPONSIBILITY TO VERIFY THE LOCATION OF ALL UTILITIES.
6. FOR PAVEMENT SECTION OVER SHALLOW UTILITIES, SEE DETAIL A AND DETAIL B ON CD-13.

LEGEND (UUD-1 TO UUD-15):


-----+c-----	(E) COMMUNICATION UG (AT&T)	⊙	(E) SURVEY MONUMENT
-----+-----	(E) COMMUNICATION UG (CHARTER)	⊗	(E) PG&E GAS VALVE
-----e-----	(E) ELECTRIC UG (TID)	○	(E) SANITARY SEWER CLEANOUT OR (E) WATER VALVE
-----gs-----	(E) GAS (PG&E)	⊠	(E) WATER METER BOX
-----w-----	(E) WATER (TID)	■	(P) DRAINAGE INLET
-----s-----	(E) SEWER (CITY OF TURLOCK)	⊠	(E) WATER METER OR WATER BOX
-----sd-----	(E) STORM DRAIN (CITY OF TURLOCK)	⊠	(E) STREET LIGHT
⊙	(E) SD/SS MANHOLE	⊠	SHALLOW UTILITY - EXCAVATE AND EXPOSE (SEE NOTE 6)
⊗	(E) WATER VALVE		
+o+	(E) FIRE HYDRANT		
■	(E) DRAIN INLET		

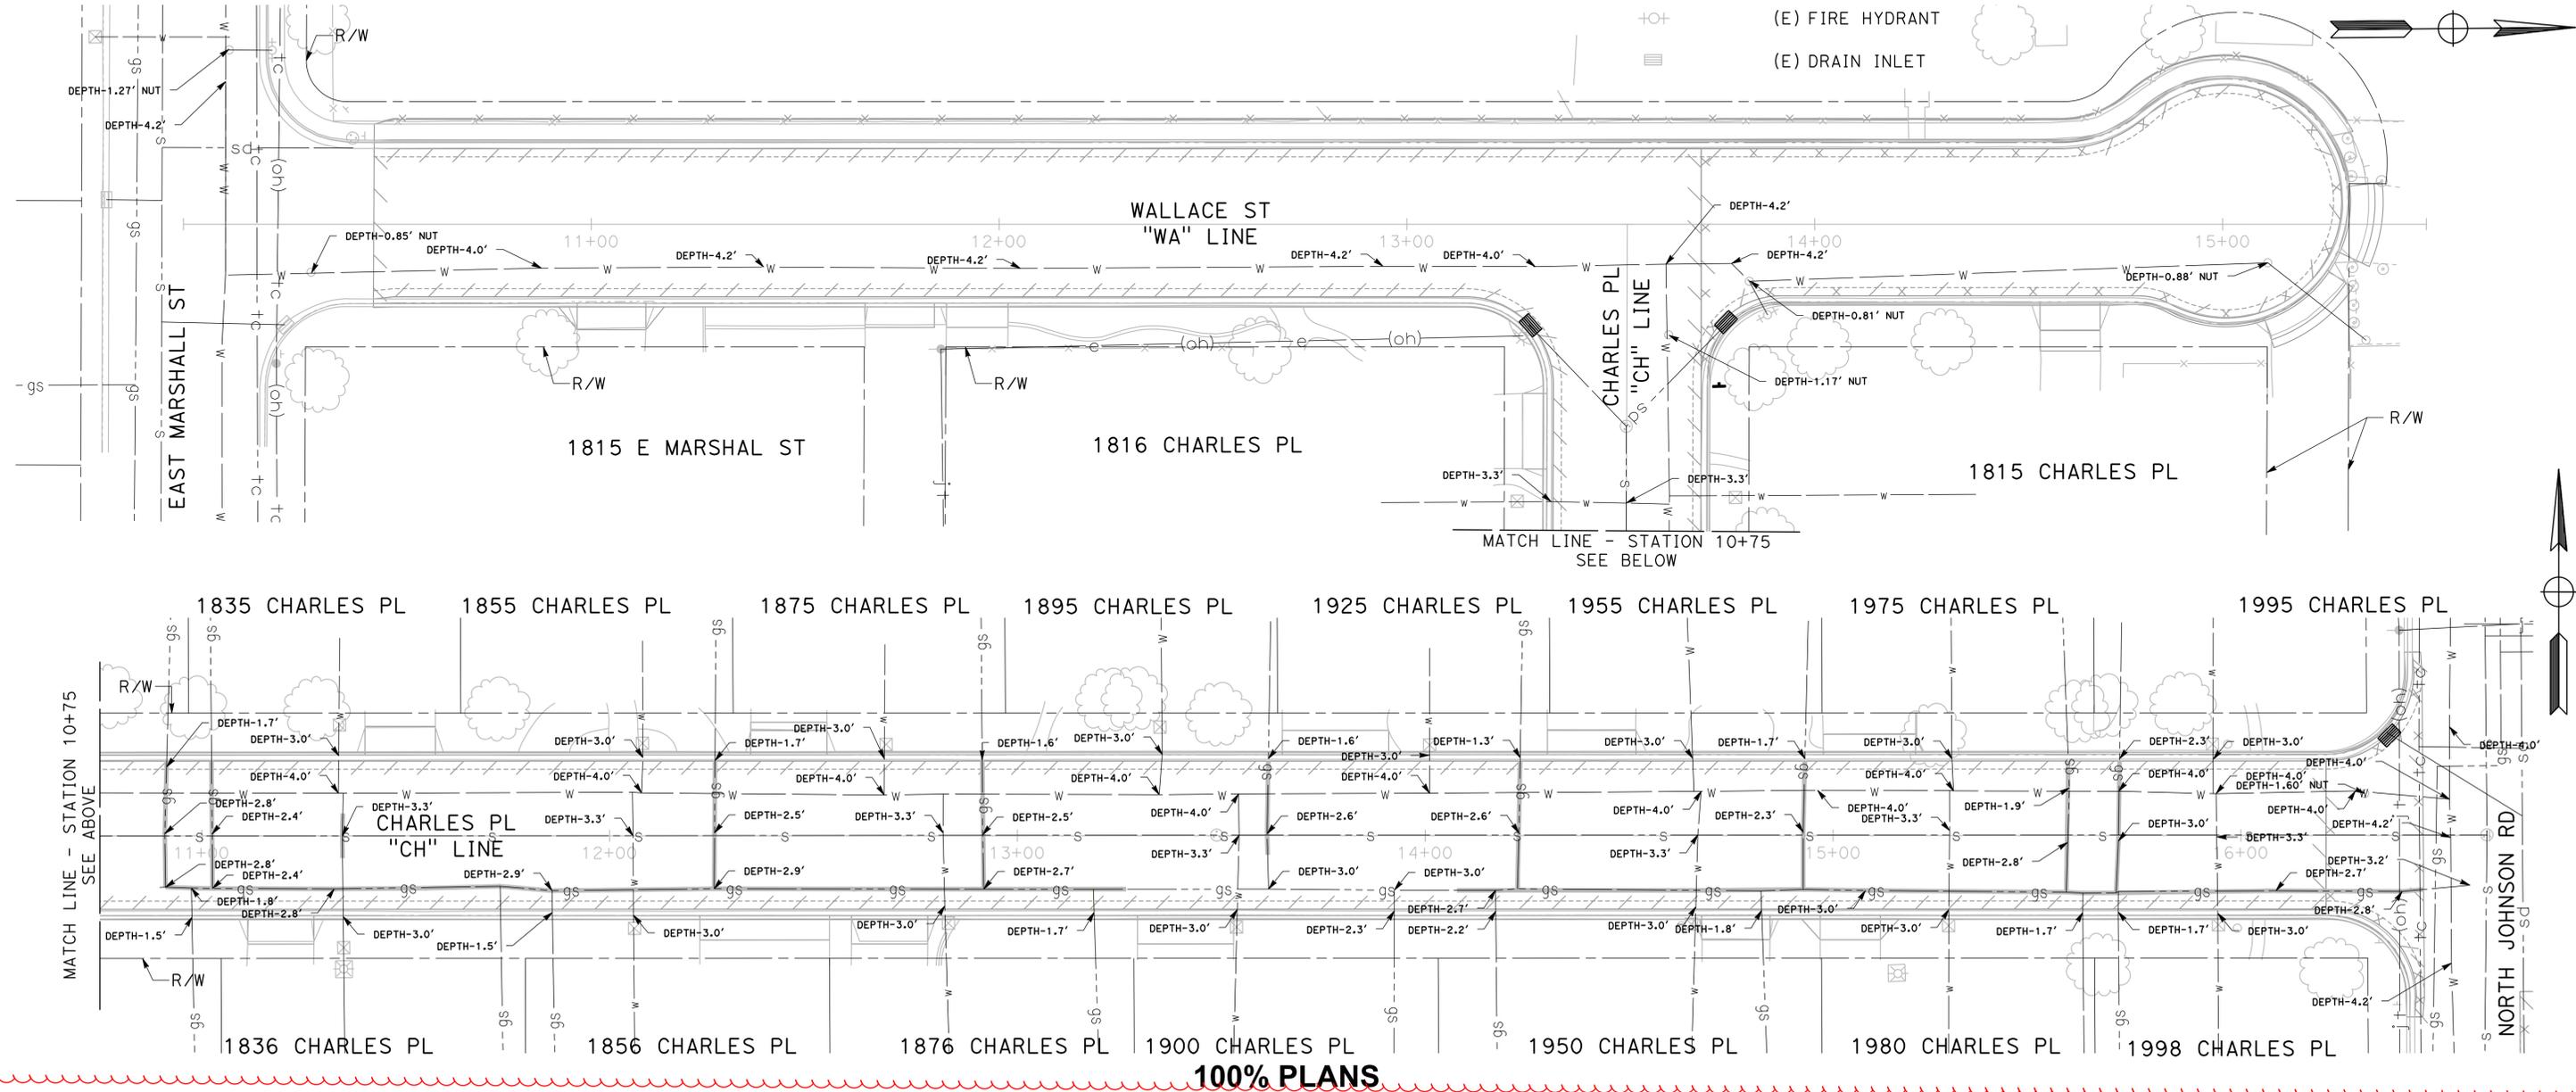

100% PLANS

DESIGNED BY: POORE, B.
 DRAWN BY: FRANCO, N.
 CHECKED BY: NORIEGA, E.
 SCALE: 1"=20'
 DATE: 5/21/2025
 JOB NO.: 24-00061

NOTE:
 ALL REFERENCES AND WRITTEN DIMENSIONS SHALL SUPERCEDE ALL SCALED DISTANCES AND SHALL BE VERIFIED IN THE FIELD. ANY DISCREPANCY SHALL BE BROUGHT TO THE ATTENTION OF THE ENGINEER PRIOR TO THE COMMENCEMENT OF WORK.

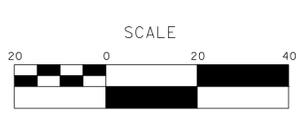



MARK THOMAS
 701 UNIVERSITY AVENUE, SUITE 200
 SACRAMENTO, CALIFORNIA 95825
 (916) 381-9100 FAX:(916)381-9180
 markthomas.com

CITY OF TURLOCK
 MUNICIPAL SERVICES
 DEPARTMENT
 156 S. BROADWAY
 SUITE 150
 (209) 668-5520



CITY OF TURLOCK
ROADS PROGRAM CIP
PROJECT 23-067 PACKAGE #3
UNDERGROUND UTILITY DEPTHS

Sheet **87**
 of
126 Sheets
UUD - 1

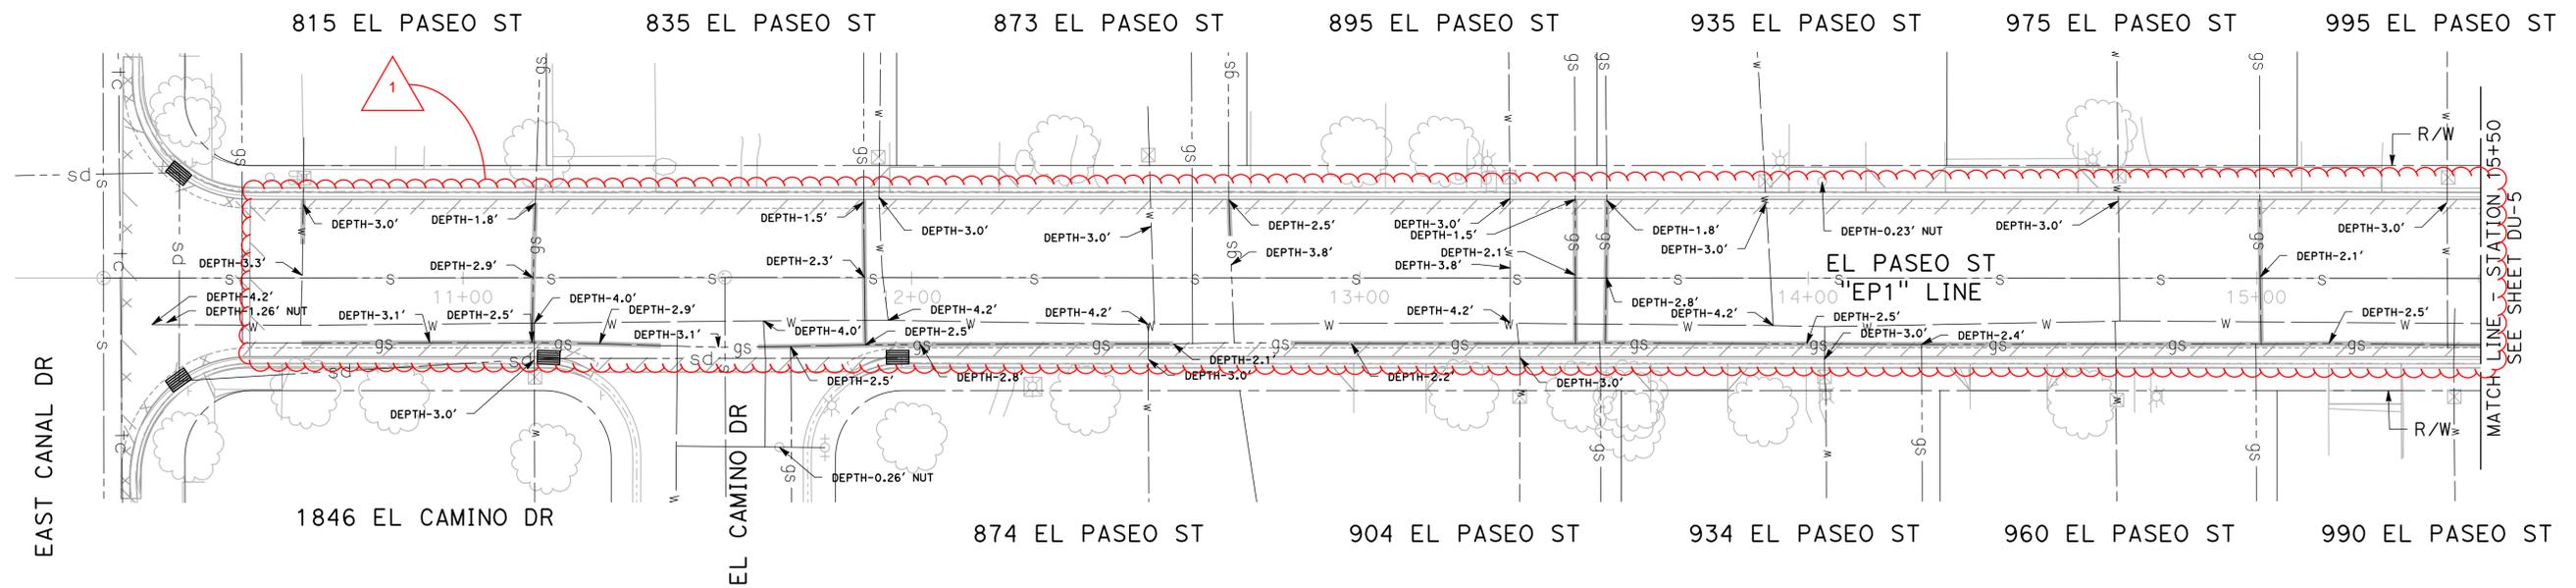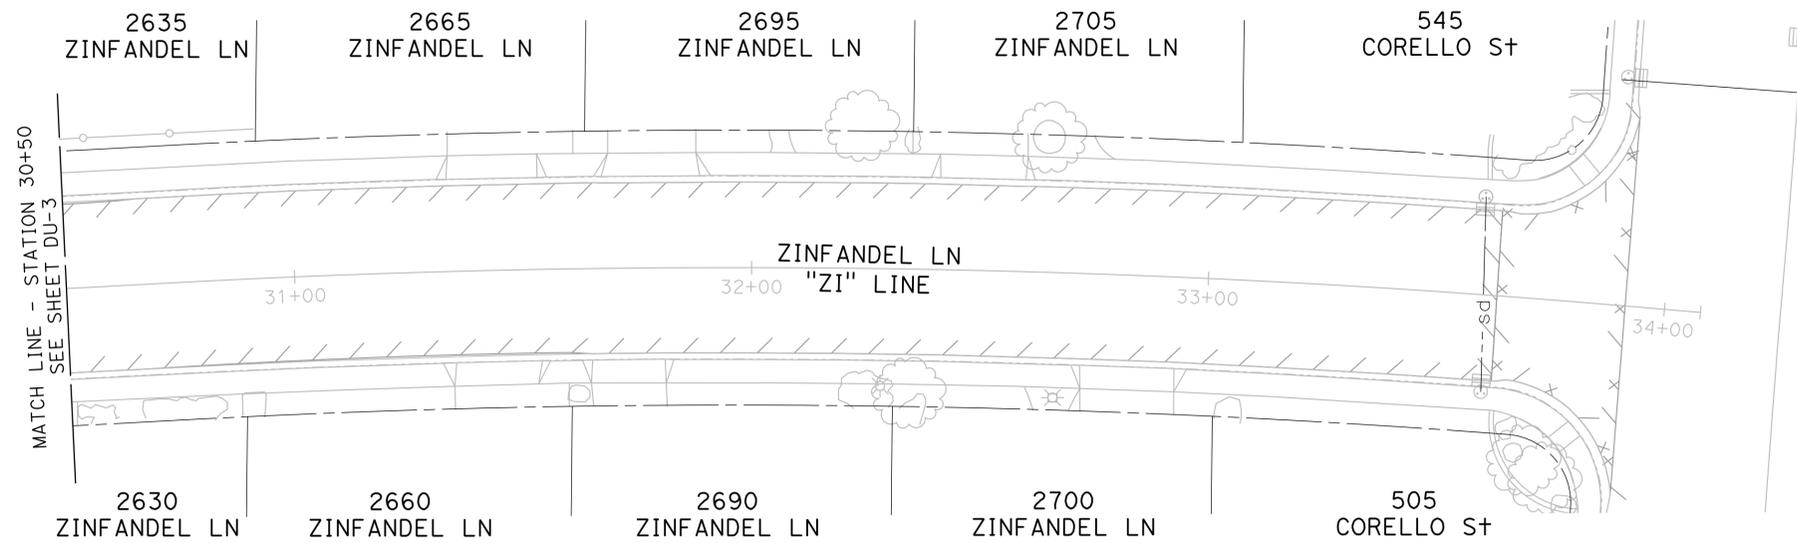

100% PLANS

DESIGNED BY: POORE, B.
 DRAWN BY: FRANCO, N.
 CHECKED BY: NORIEGA, E.
 SCALE: 1"=20'
 DATE: 5/21/2025
 JOB NO.: 24-00061

NOTE:
 ALL REFERENCES AND WRITTEN DIMENSIONS SHALL SUPERCEDE ALL SCALED DISTANCES AND SHALL BE VERIFIED IN THE FIELD. ANY DISCREPANCY SHALL BE BROUGHT TO THE ATTENTION OF THE ENGINEER PRIOR TO THE COMMENCEMENT OF WORK.



MARK THOMAS
 701 UNIVERSITY AVENUE, SUITE 200
 SACRAMENTO, CALIFORNIA 95825
 (916) 381-9100 FAX:(916)381-9180
 markthomas.com




CITY OF TURLOCK
 MUNICIPAL SERVICES
 DEPARTMENT
 156 S. BROADWAY
 SUITE 150
 (209) 668-5520



CITY OF TURLOCK
ROADS PROGRAM CIP
PROJECT 23-067 PACKAGE #3
UNDERGROUND UTILITY DEPTHS

Sheet 90
 of
 126 Sheets

UUD - 4

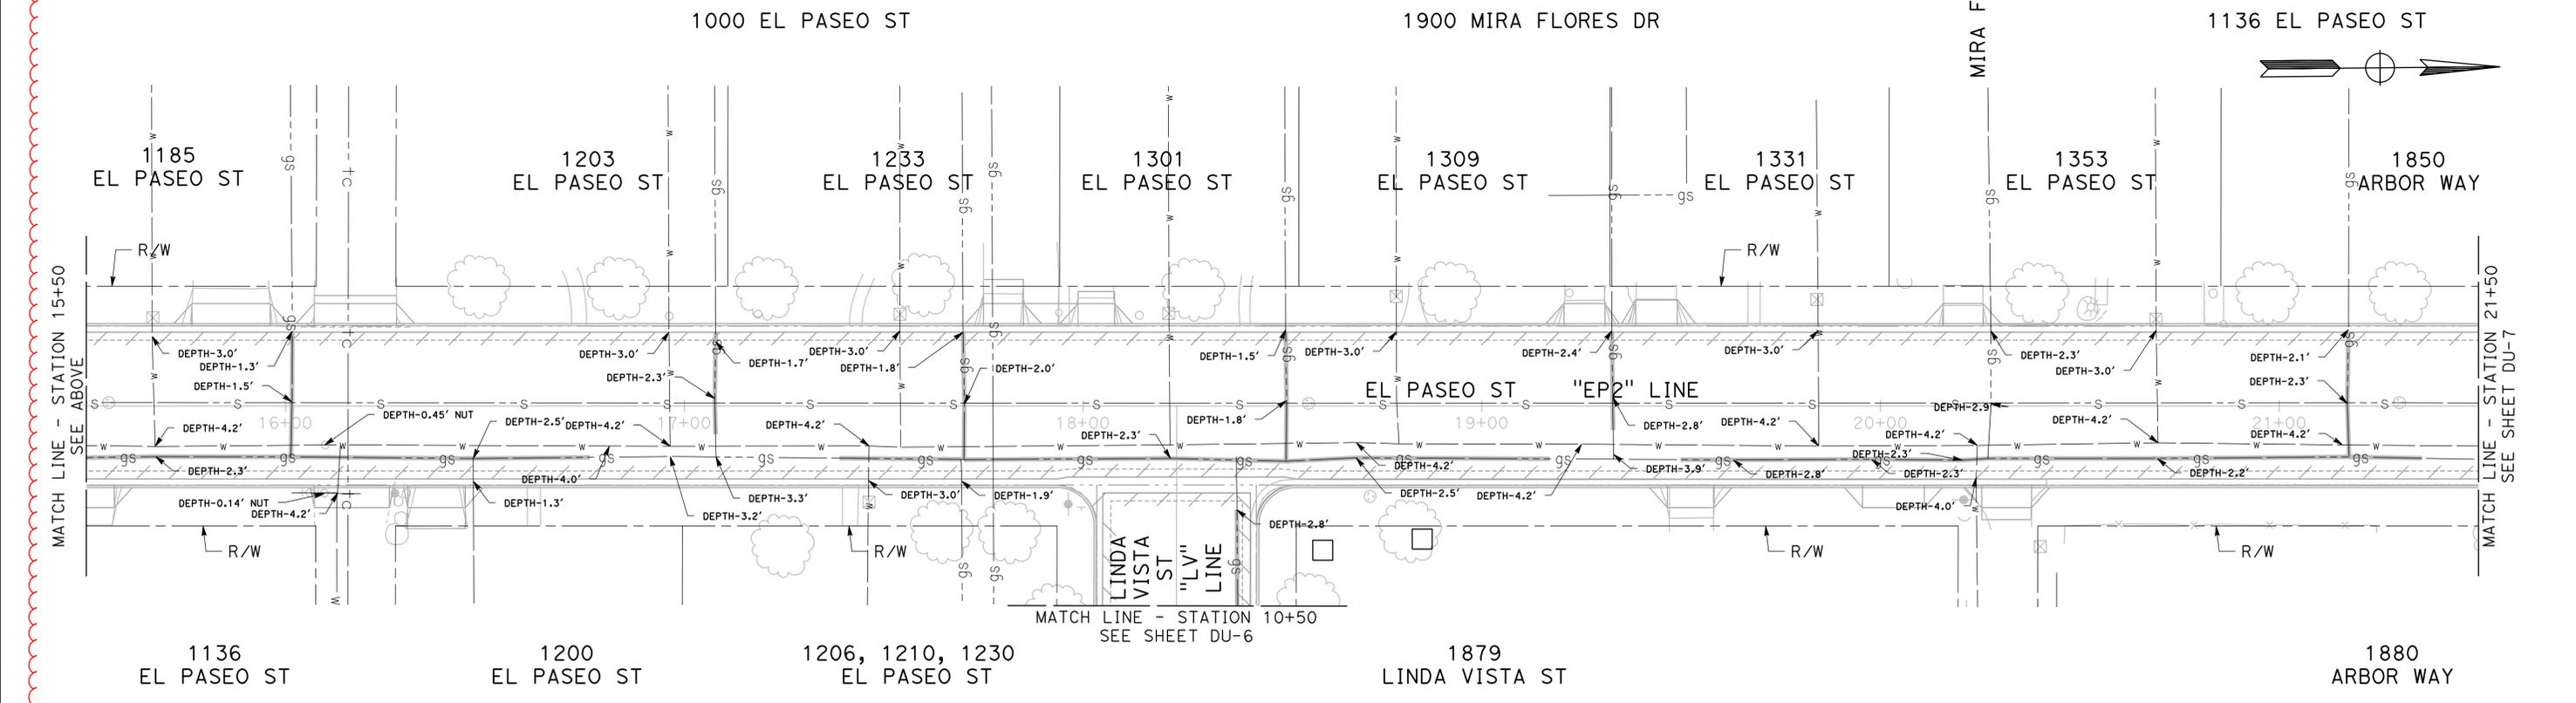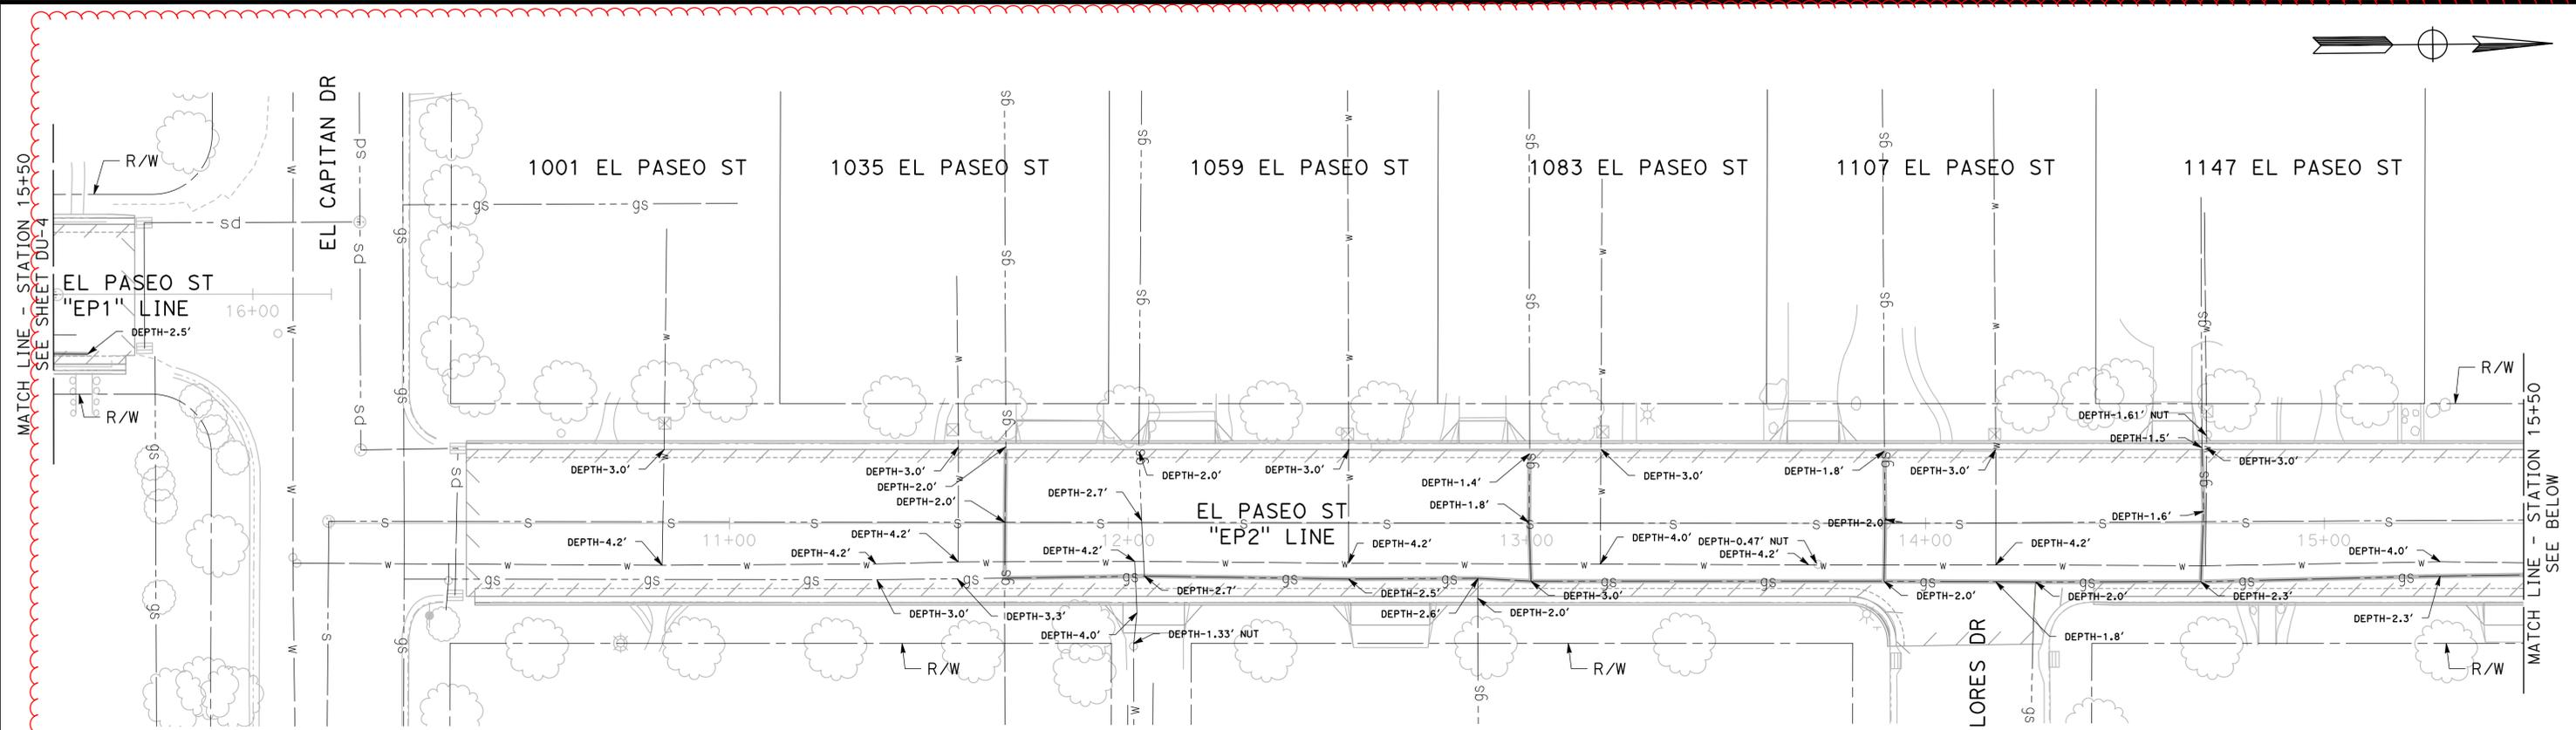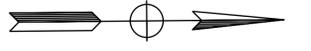

100% PLANS

DESIGNED BY: POORE, B.
 DRAWN BY: FRANCO, N.
 CHECKED BY: NORIEGA, E.
 SCALE: 1"=20'
 DATE: 5/21/2025
 JOB NO.: 24-00061

NOTE:
 ALL REFERENCES AND WRITTEN DIMENSIONS SHALL SUPERCEDE ALL SCALED DISTANCES AND SHALL BE VERIFIED IN THE FIELD. ANY DISCREPANCY SHALL BE BROUGHT TO THE ATTENTION OF THE ENGINEER PRIOR TO THE COMMENCEMENT OF WORK.





MARK THOMAS
 701 UNIVERSITY AVENUE, SUITE 200
 SACRAMENTO, CALIFORNIA 95825
 (916) 381-9100 FAX:(916)381-9180
 markthomas.com

CITY OF TURLOCK
 MUNICIPAL SERVICES
 DEPARTMENT
 156 S. BROADWAY
 SUITE 150
 (209) 668-5520



CITY OF TURLOCK
ROADS PROGRAM CIP
PROJECT 23-067 PACKAGE #3
UNDERGROUND UTILITY DEPTHS

Sheet **91**
 of **126** Sheets
UUD - 5

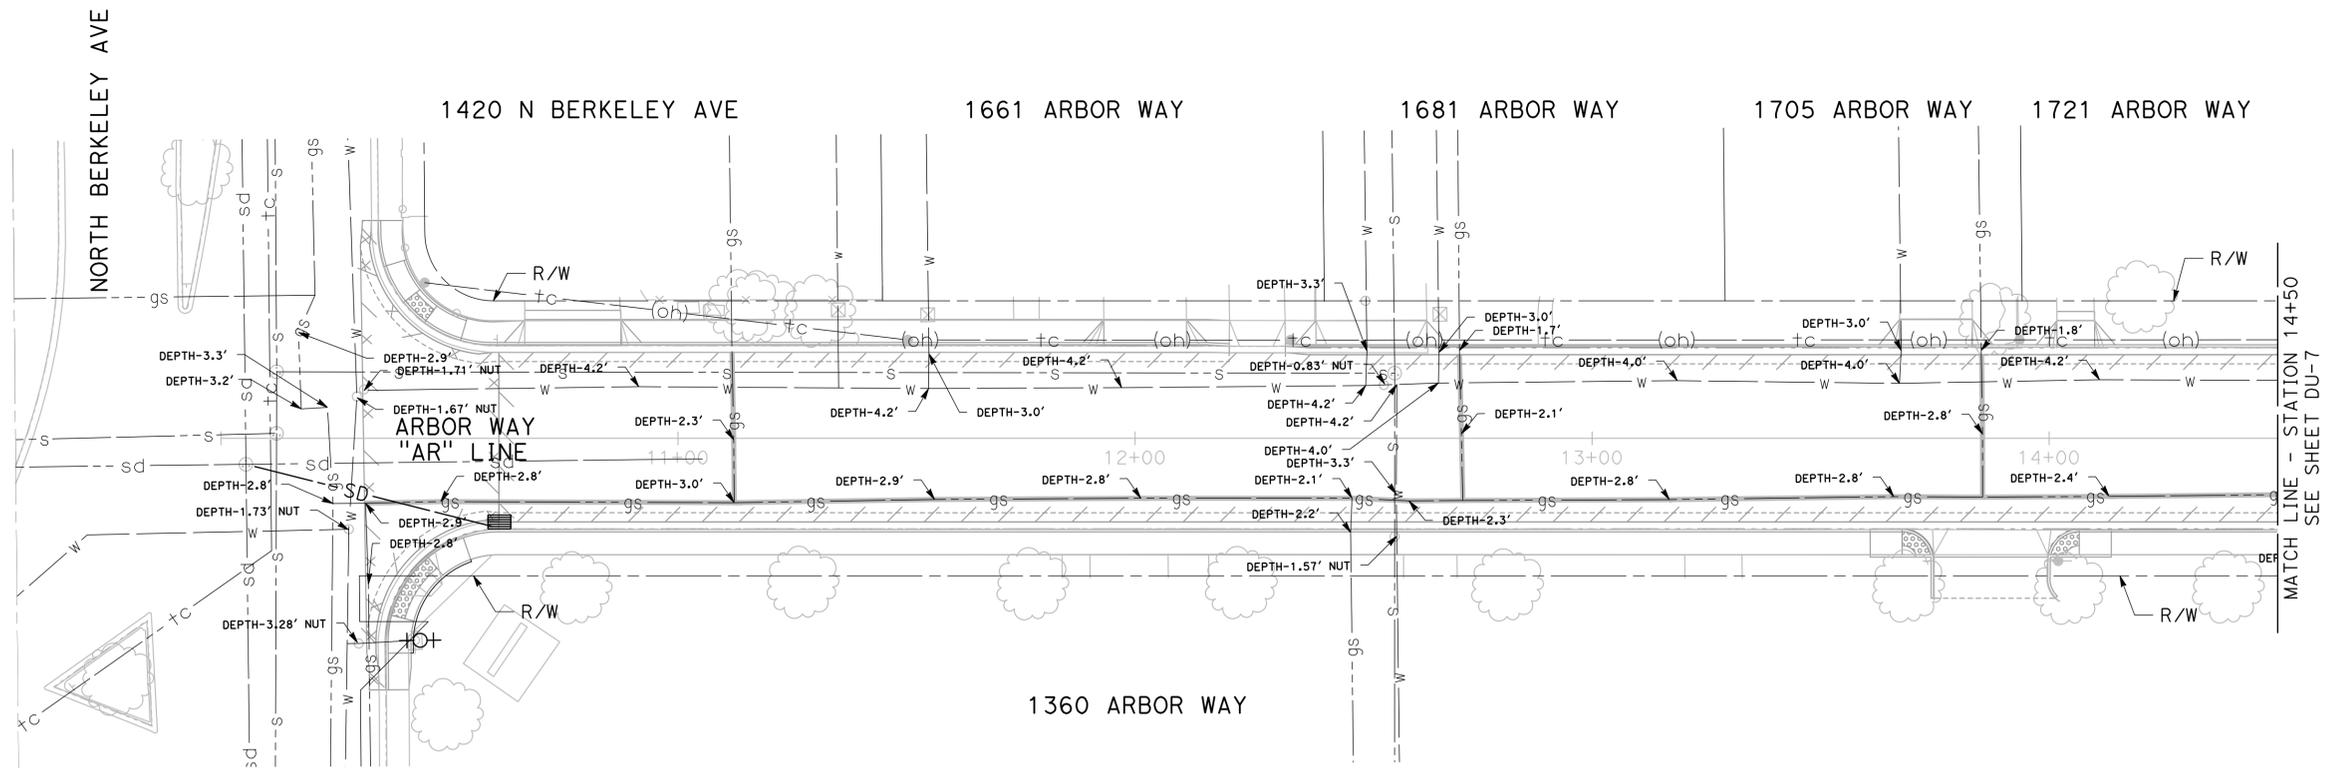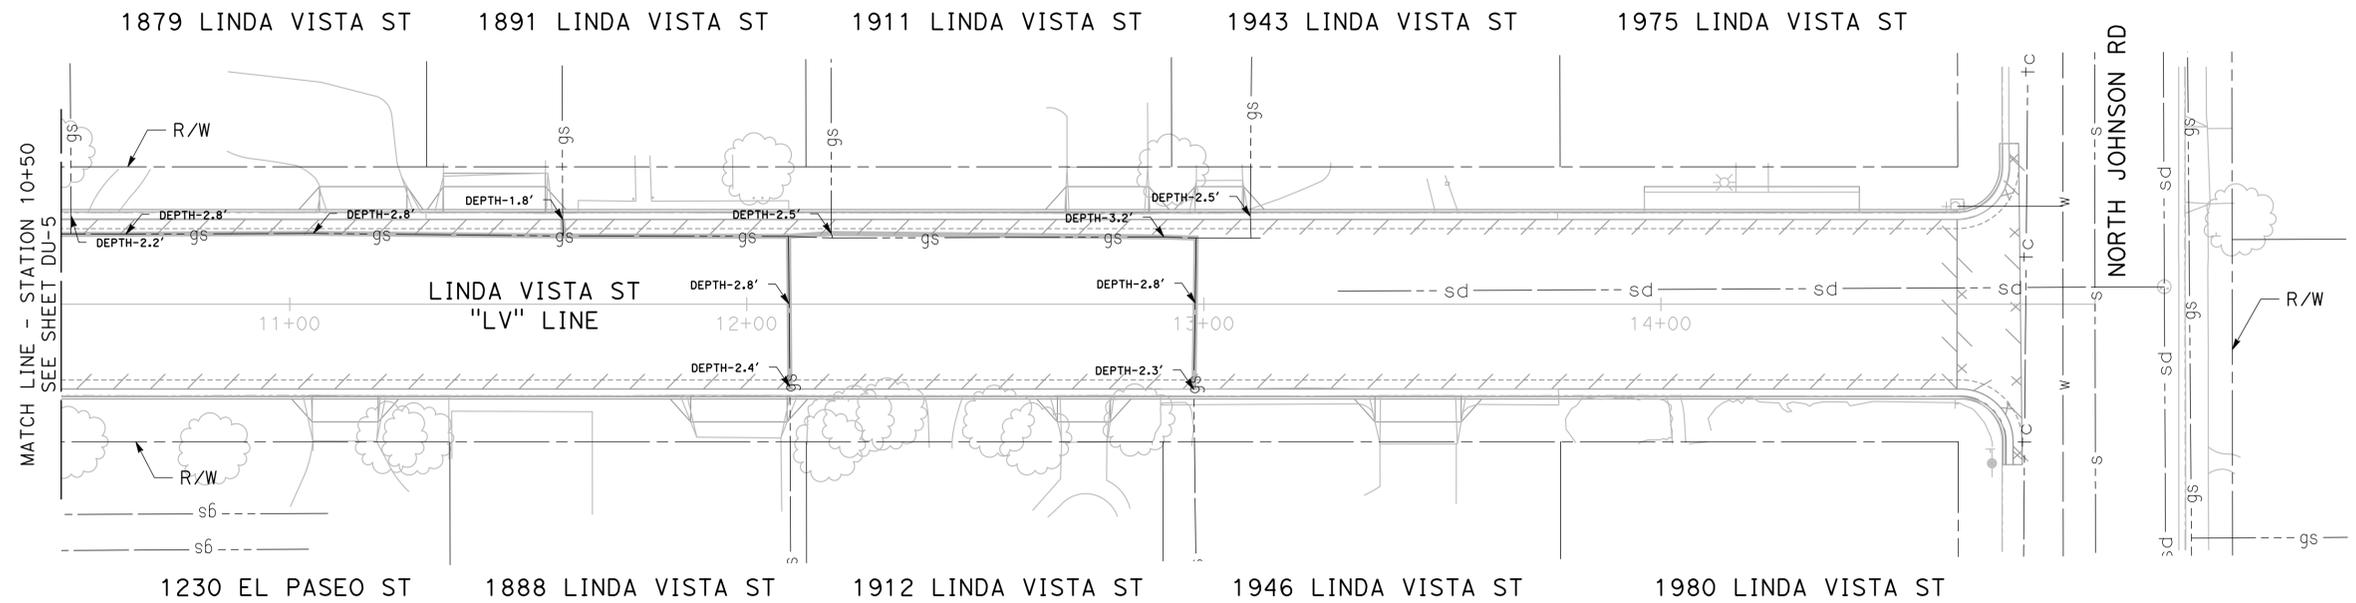

100% PLANS

DESIGNED BY: POORE, B.
 DRAWN BY: FRANCO, N.
 CHECKED BY: NORIEGA, E.
 SCALE: 1"=20'
 DATE: 5/21/2025
 JOB NO.: 24-00061

NOTE:
 ALL REFERENCES AND WRITTEN DIMENSIONS SHALL SUPERCEDE ALL SCALED DISTANCES AND SHALL BE VERIFIED IN THE FIELD. ANY DISCREPANCY SHALL BE BROUGHT TO THE ATTENTION OF THE ENGINEER PRIOR TO THE COMMENCEMENT OF WORK.



MARK THOMAS
 701 UNIVERSITY AVENUE, SUITE 200
 SACRAMENTO, CALIFORNIA 95825
 (916) 381-9100 FAX:(916)381-9180
 markthomas.com



CITY OF TURLOCK
 MUNICIPAL SERVICES
 DEPARTMENT
 156 S. BROADWAY
 SUITE 150
 (209) 668-5520



CITY OF TURLOCK
ROADS PROGRAM CIP
PROJECT 23-067 PACKAGE #3
UNDERGROUND UTILITY DEPTHS

Sheet **92**
 of
126 Sheets

UUD - 6

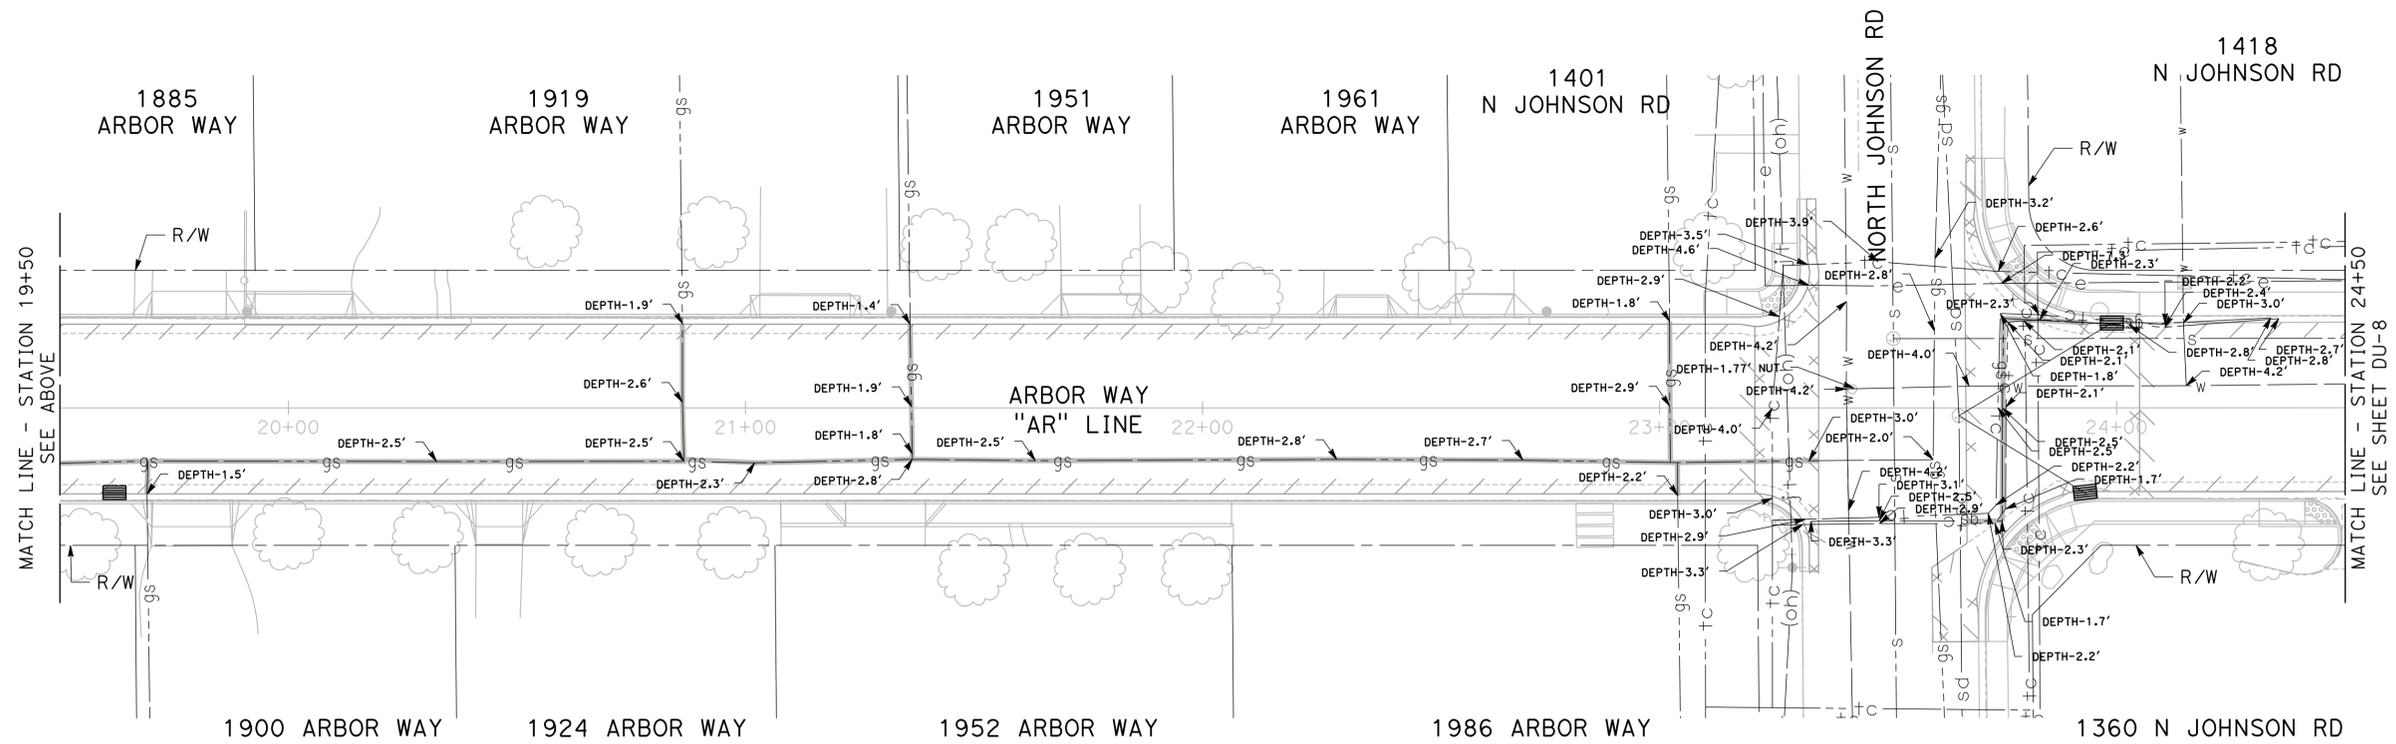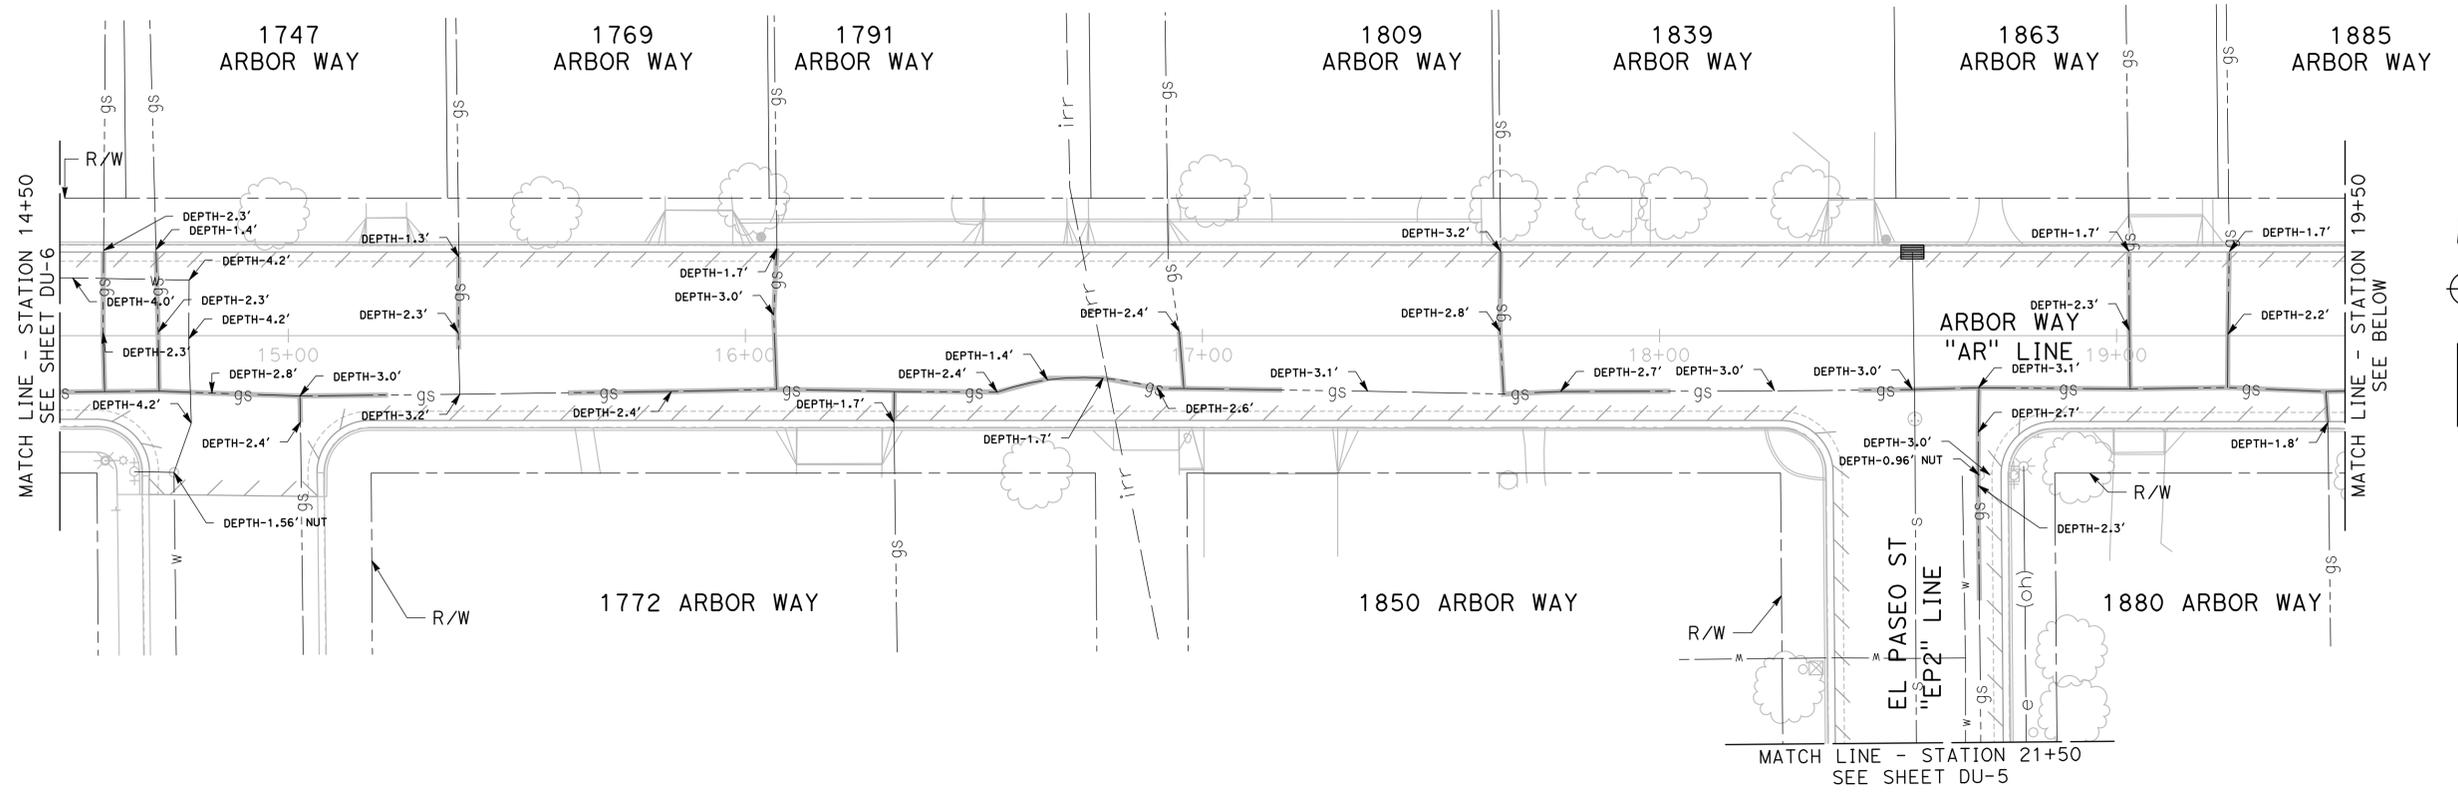

100% PLANS

DESIGNED BY: POORE, B.
 DRAWN BY: FRANCO, N.
 CHECKED BY: NORIEGA, E.
 SCALE: 1"=20'
 DATE: 5/21/2025
 JOB NO.: 24-00061

NOTE:
 ALL REFERENCES AND WRITTEN DIMENSIONS SHALL SUPERCEDE ALL SCALED DISTANCES AND SHALL BE VERIFIED IN THE FIELD. ANY DISCREPANCY SHALL BE BROUGHT TO THE ATTENTION OF THE ENGINEER PRIOR TO THE COMMENCEMENT OF WORK.



MARK THOMAS
 701 UNIVERSITY AVENUE, SUITE 200
 SACRAMENTO, CALIFORNIA 95825
 (916) 381-9100 FAX:(916)381-9180
 markthomas.com


CITY OF TURLOCK
 MUNICIPAL SERVICES
 DEPARTMENT
 156 S. BROADWAY
 SUITE 150
 (209) 668-5520



CITY OF TURLOCK
ROADS PROGRAM CIP
PROJECT 23-067 PACKAGE #3
UNDERGROUND UTILITY DEPTHS

Sheet **93**
 of
126 Sheets


UUD - 7

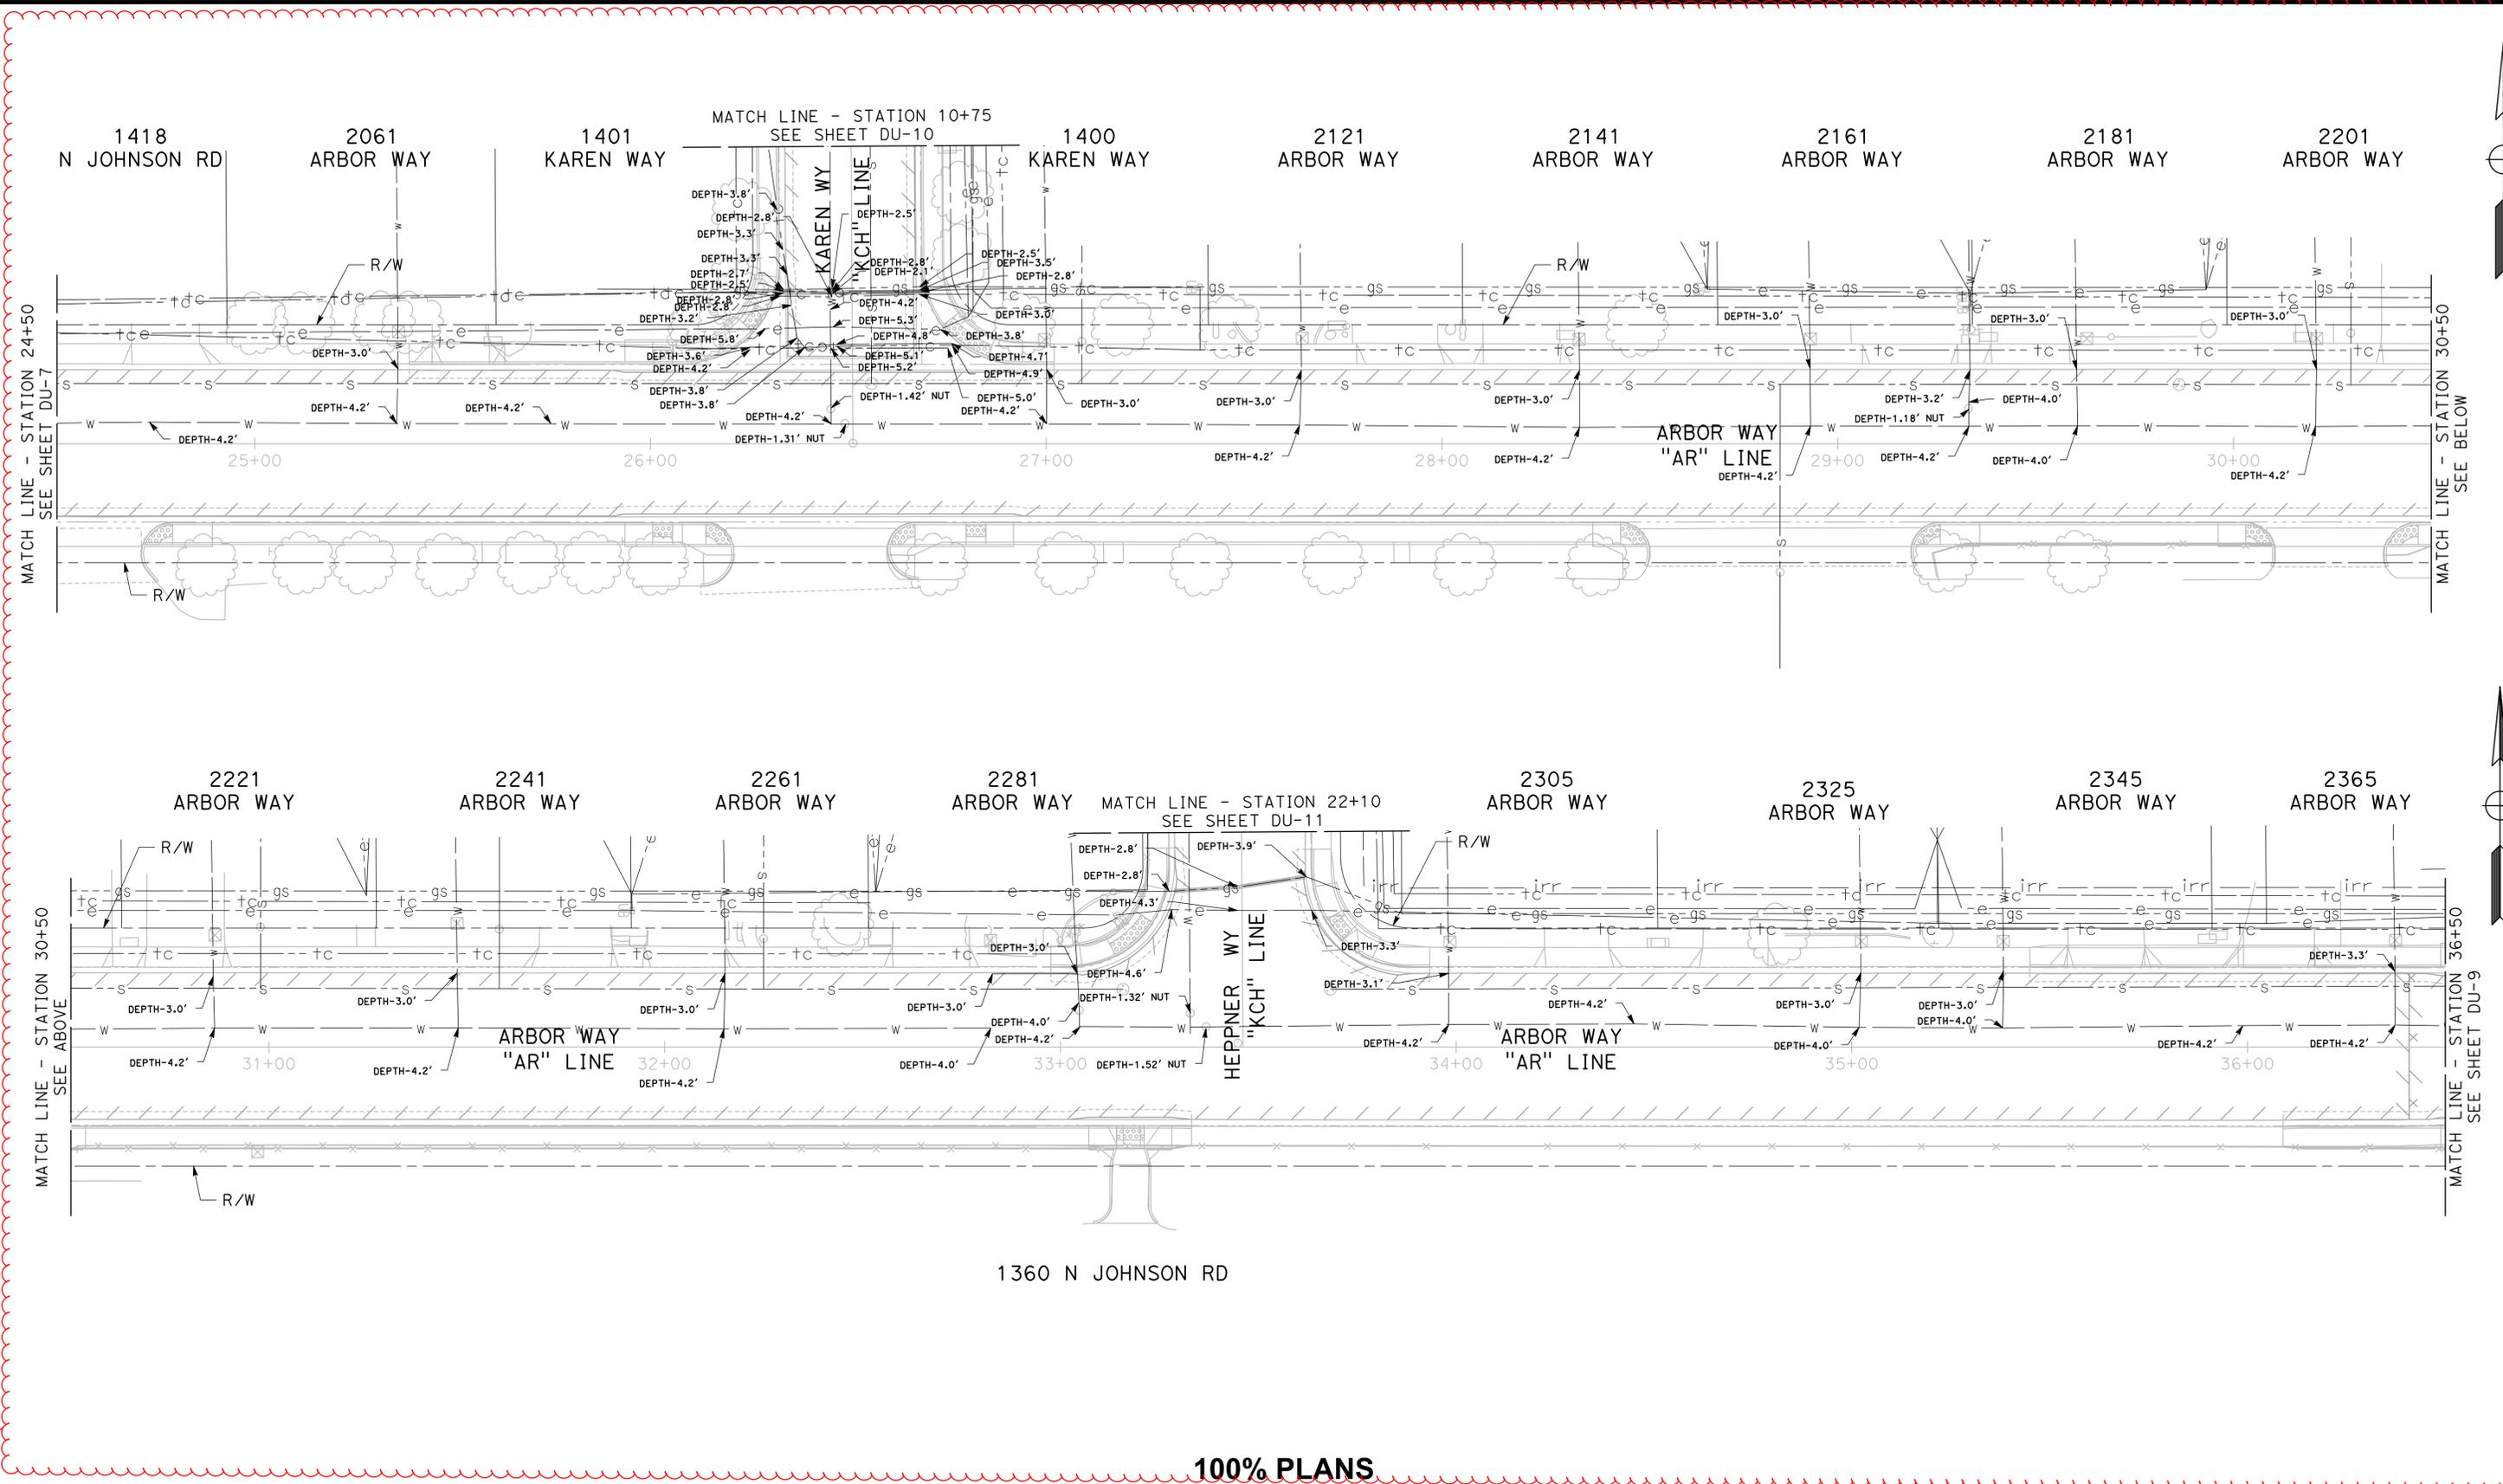

100% PLANS

DESIGNED BY: POORE, B.
 DRAWN BY: FRANCO, N.
 CHECKED BY: NORIEGA, E.
 SCALE: 1"=20'
 DATE: 5/21/2025
 JOB NO.: 24-00061

NOTE:
 ALL REFERENCES AND WRITTEN DIMENSIONS SHALL SUPERCEDE ALL SCALED DISTANCES AND SHALL BE VERIFIED IN THE FIELD. ANY DISCREPANCY SHALL BE BROUGHT TO THE ATTENTION OF THE ENGINEER PRIOR TO THE COMMENCEMENT OF WORK.

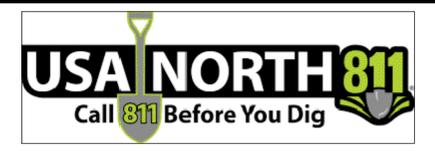


MARK THOMAS
 701 UNIVERSITY AVENUE, SUITE 200
 SACRAMENTO, CALIFORNIA 95825
 (916) 381-9100 FAX:(916)381-9180
 markthomas.com

CITY OF TURLOCK
 MUNICIPAL SERVICES DEPARTMENT
 156 S. BROADWAY
 SUITE 150
 (209) 668-5520



CITY OF TURLOCK
ROADS PROGRAM CIP
PROJECT 23-067 PACKAGE #3
UNDERGROUND UTILITY DEPTHS


Sheet **94**
 of **126** Sheets
UUD - 8

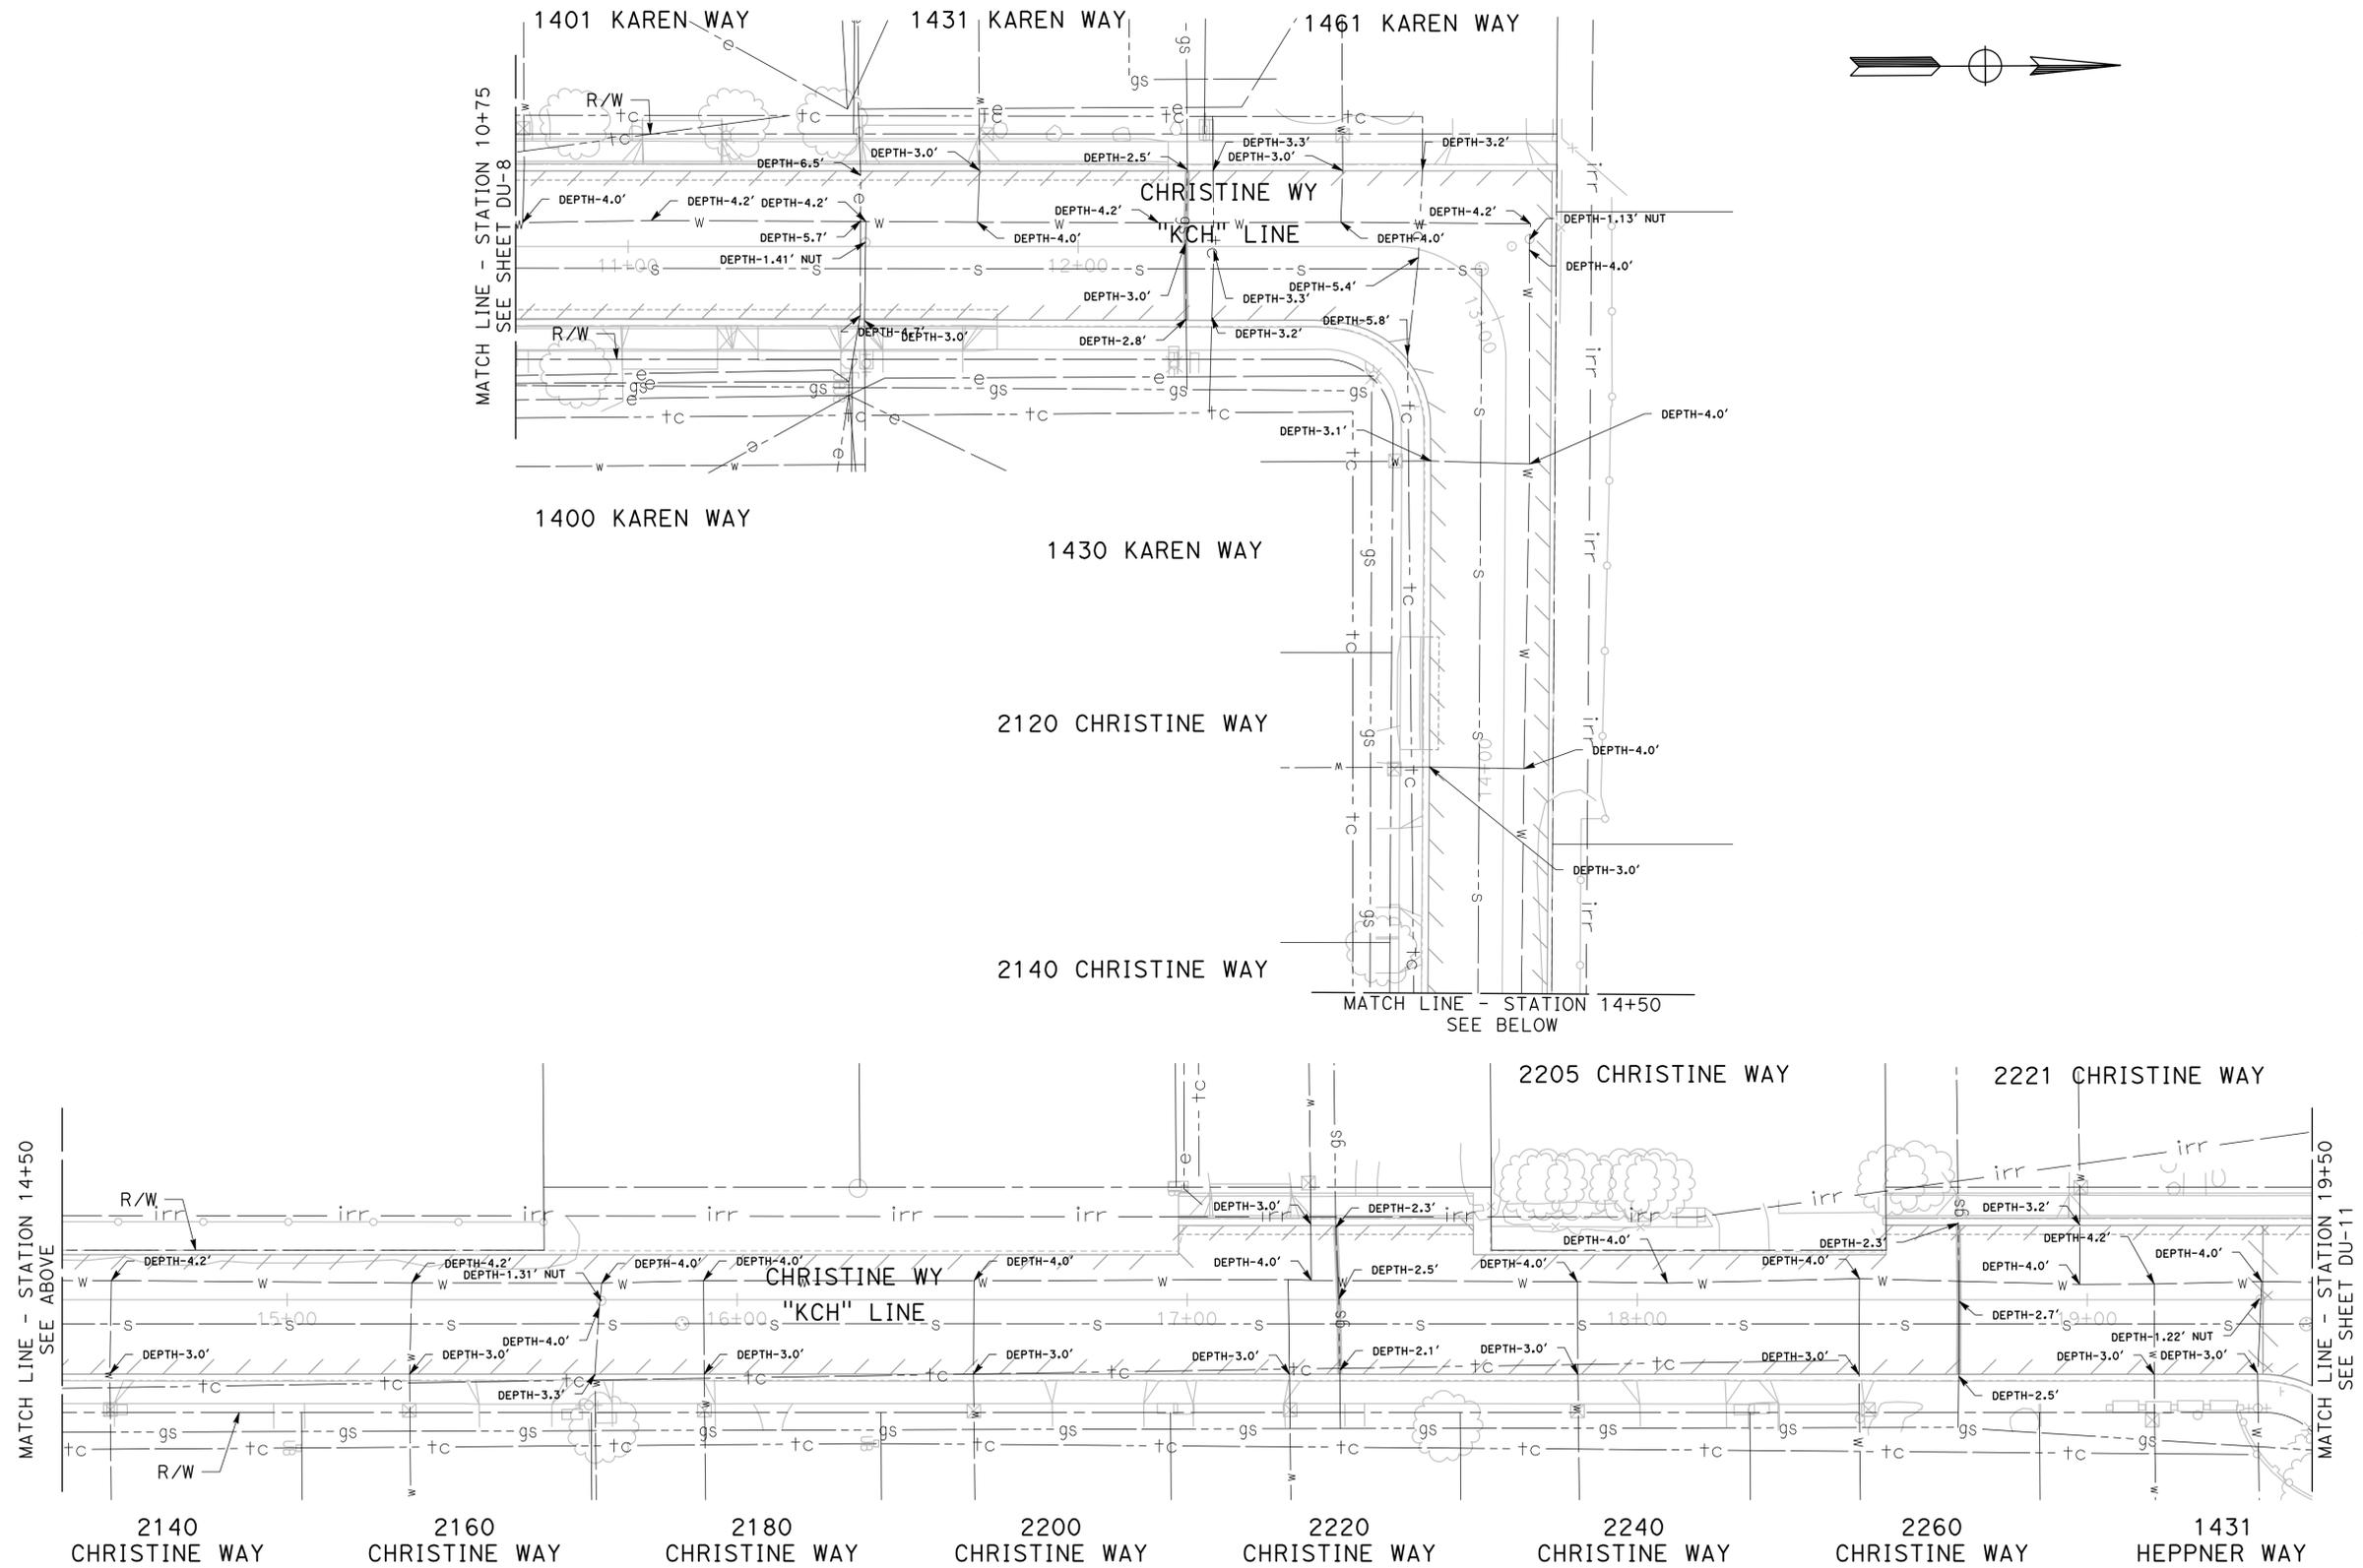

100% PLANS

DESIGNED BY: POORE, B.
 DRAWN BY: FRANCO, N.
 CHECKED BY: NORIEGA, E.
 SCALE: 1"=20'
 DATE: 5/21/2025
 JOB NO.: 24-00061

NOTE:
 ALL REFERENCES AND WRITTEN DIMENSIONS SHALL SUPERCEDE ALL SCALED DISTANCES AND SHALL BE VERIFIED IN THE FIELD. ANY DISCREPANCY SHALL BE BROUGHT TO THE ATTENTION OF THE ENGINEER PRIOR TO THE COMMENCEMENT OF WORK.

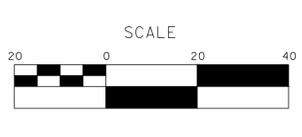



MARK THOMAS
 701 UNIVERSITY AVENUE, SUITE 200
 SACRAMENTO, CALIFORNIA 95825
 (916) 381-9100 FAX:(916)381-9180
 markthomas.com

CITY OF TURLOCK
 MUNICIPAL SERVICES DEPARTMENT
 156 S. BROADWAY
 SUITE 150
 (209) 668-5520



CITY OF TURLOCK
ROADS PROGRAM CIP
PROJECT 23-067 PACKAGE #3
UNDERGROUND UTILITY DEPTHS


Sheet **96**
 of
126 Sheets
UUD-10

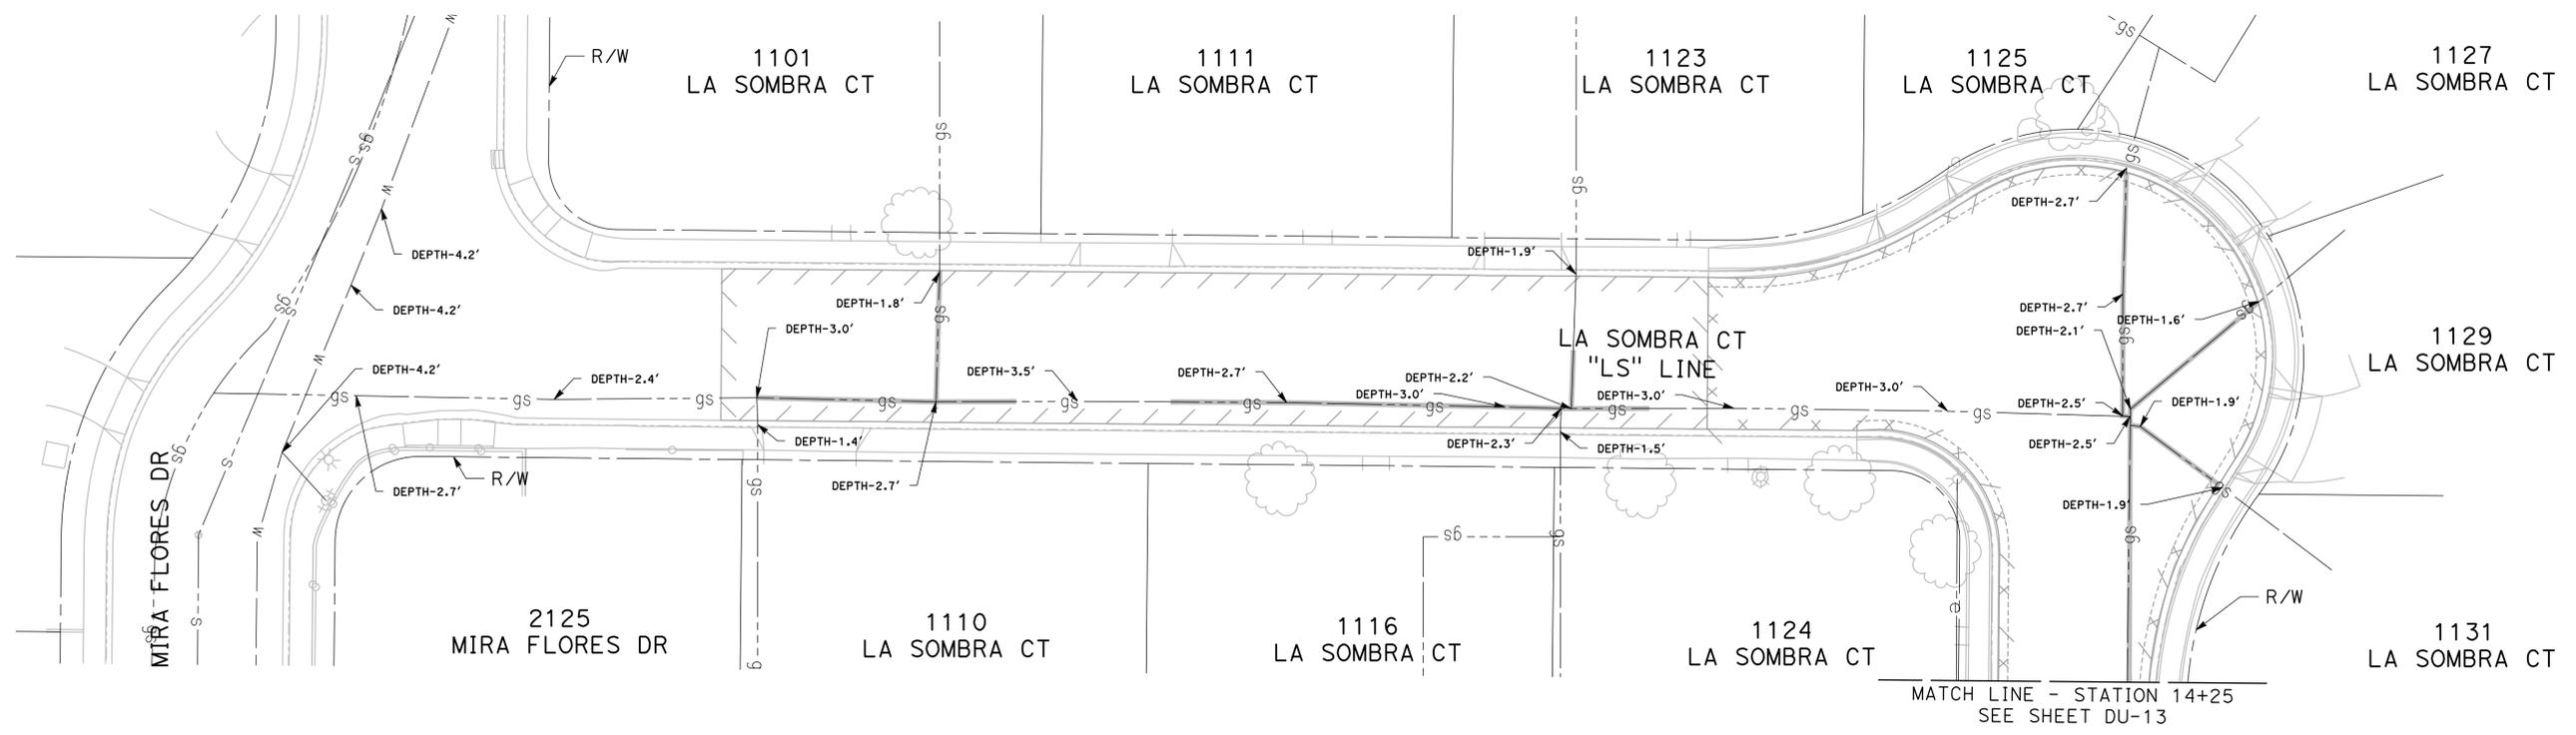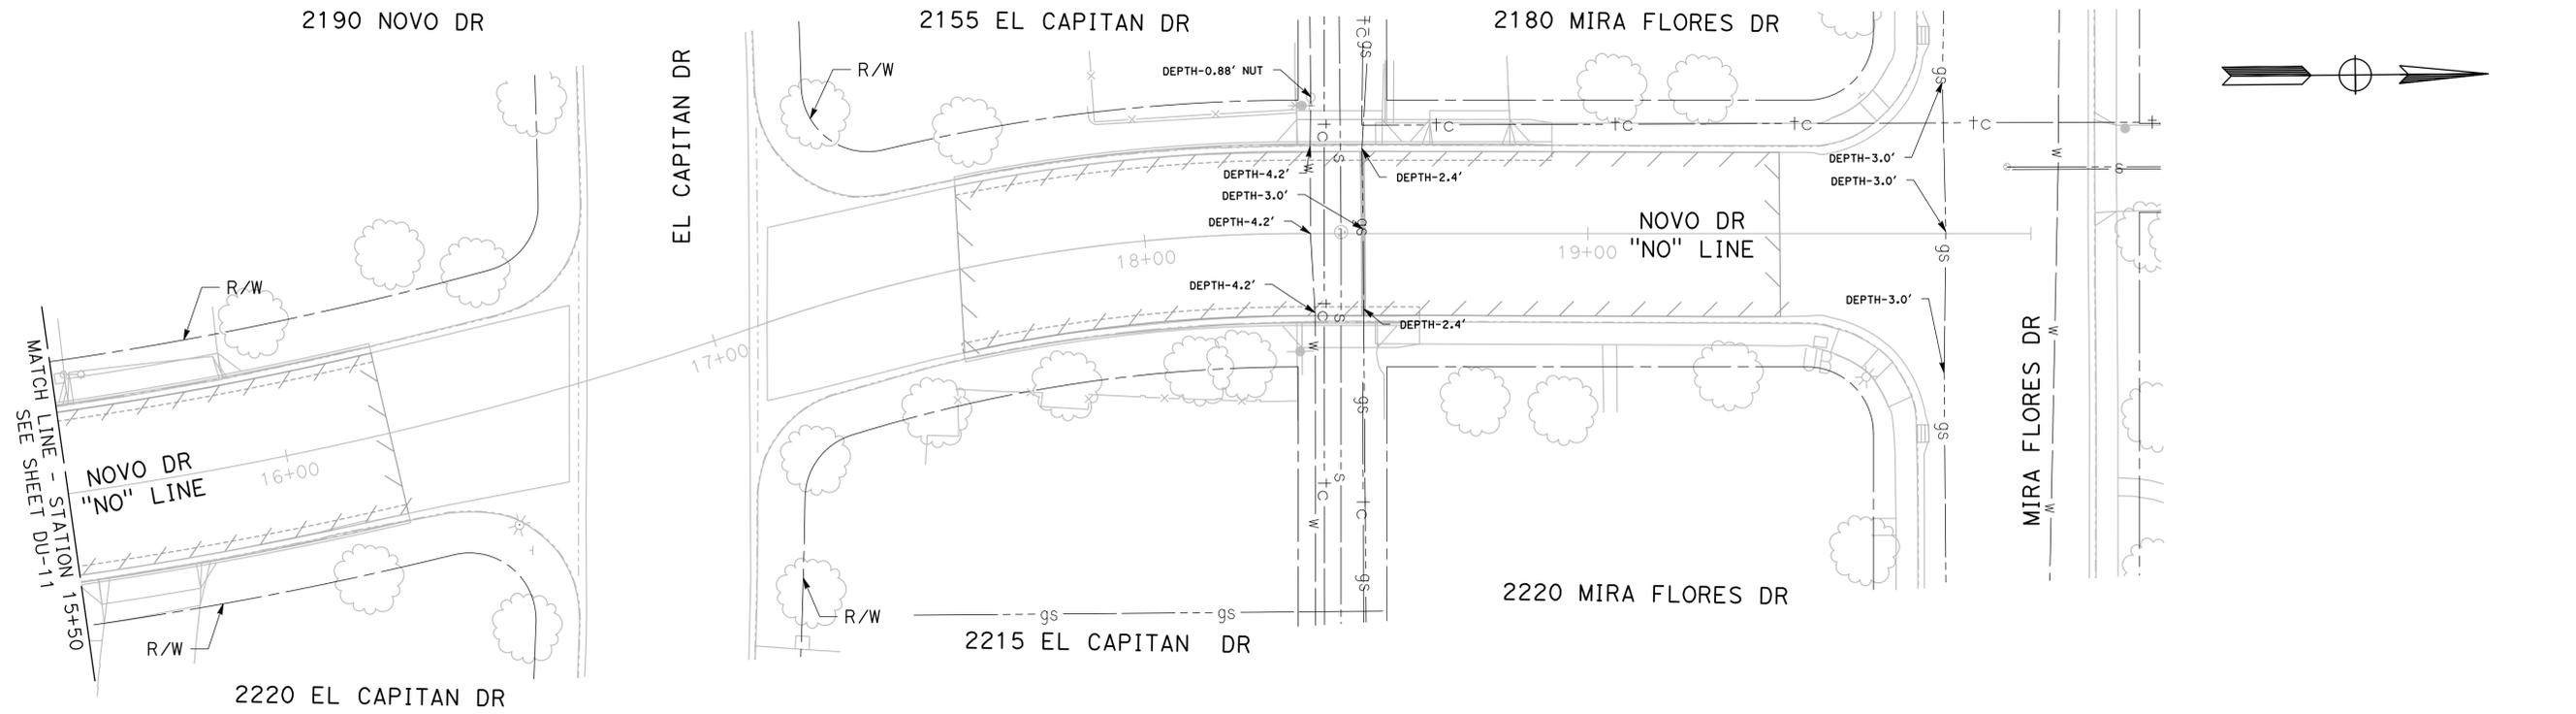

100% PLANS

DESIGNED BY: POORE, B.
 DRAWN BY: FRANCO, N.
 CHECKED BY: NORIEGA, E.
 SCALE: 1"=20'
 DATE: 5/21/2025
 JOB NO.: 24-00061

NOTE:
 ALL REFERENCES AND WRITTEN DIMENSIONS SHALL SUPERCEDE ALL SCALED DISTANCES AND SHALL BE VERIFIED IN THE FIELD. ANY DISCREPANCY SHALL BE BROUGHT TO THE ATTENTION OF THE ENGINEER PRIOR TO THE COMMENCEMENT OF WORK.

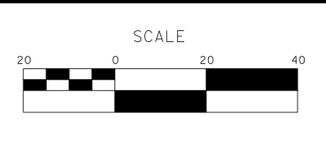



MARK THOMAS
 701 UNIVERSITY AVENUE, SUITE 200
 SACRAMENTO, CALIFORNIA 95825
 (916) 381-9100 FAX: (916) 381-9180
 markthomas.com

CITY OF TURLOCK
 MUNICIPAL SERVICES
 DEPARTMENT
 156 S. BROADWAY
 SUITE 150
 (209) 668-5520



CITY OF TURLOCK
ROADS PROGRAM CIP
PROJECT 23-067 PACKAGE #3
UNDERGROUND UTILITY DEPTHS


Sheet **98**
 of
126 Sheets
UUD-12

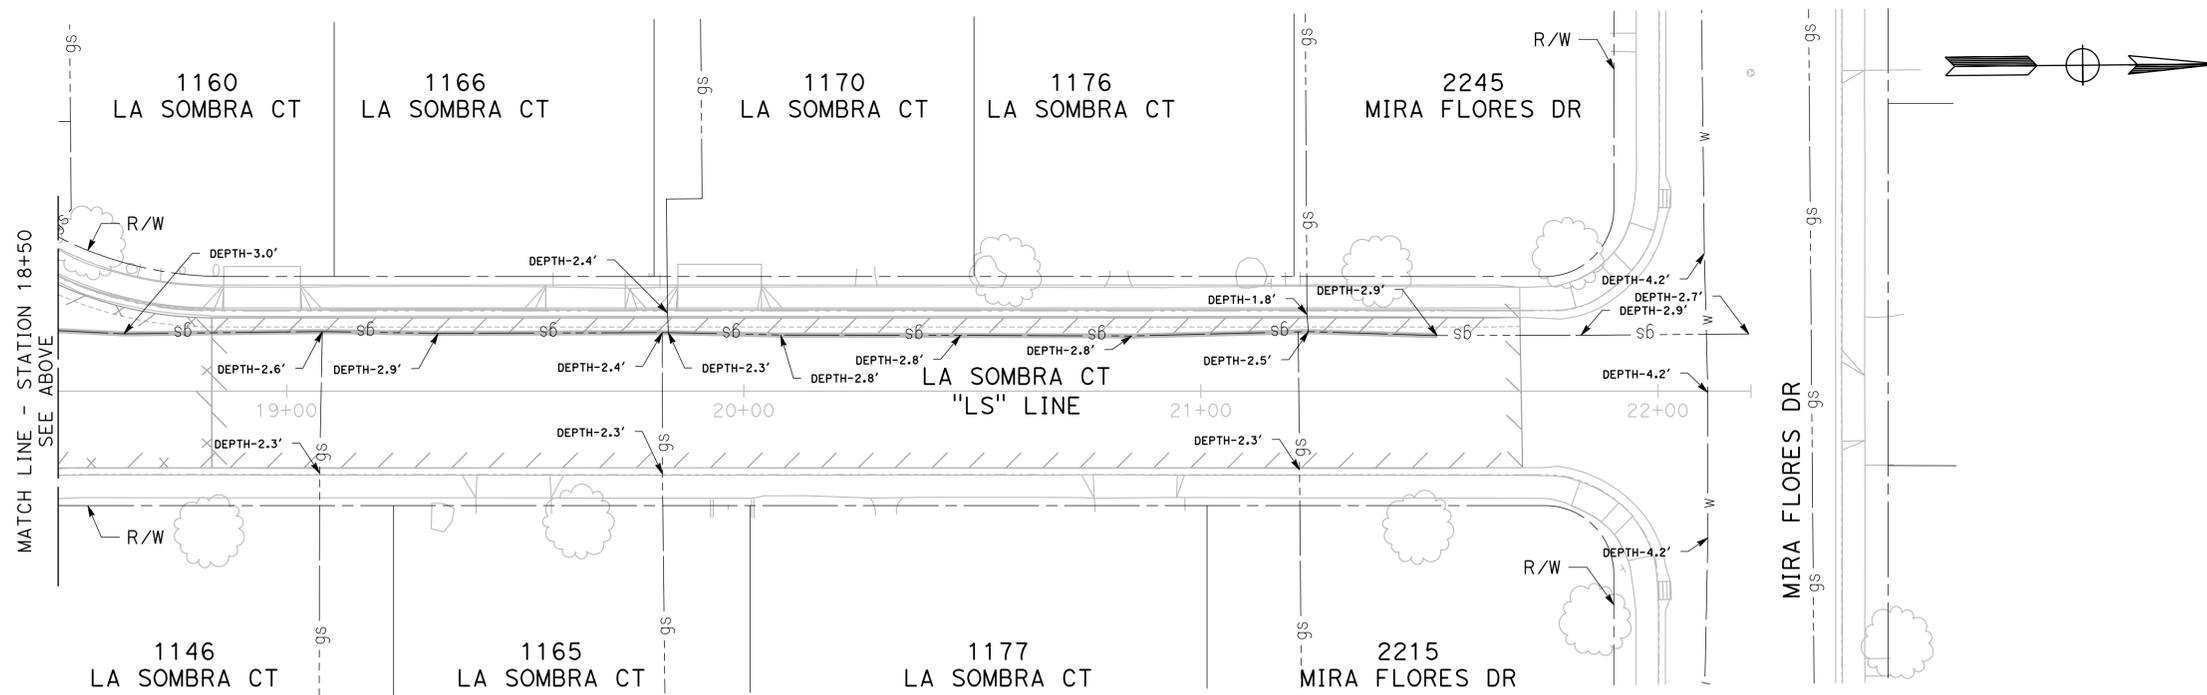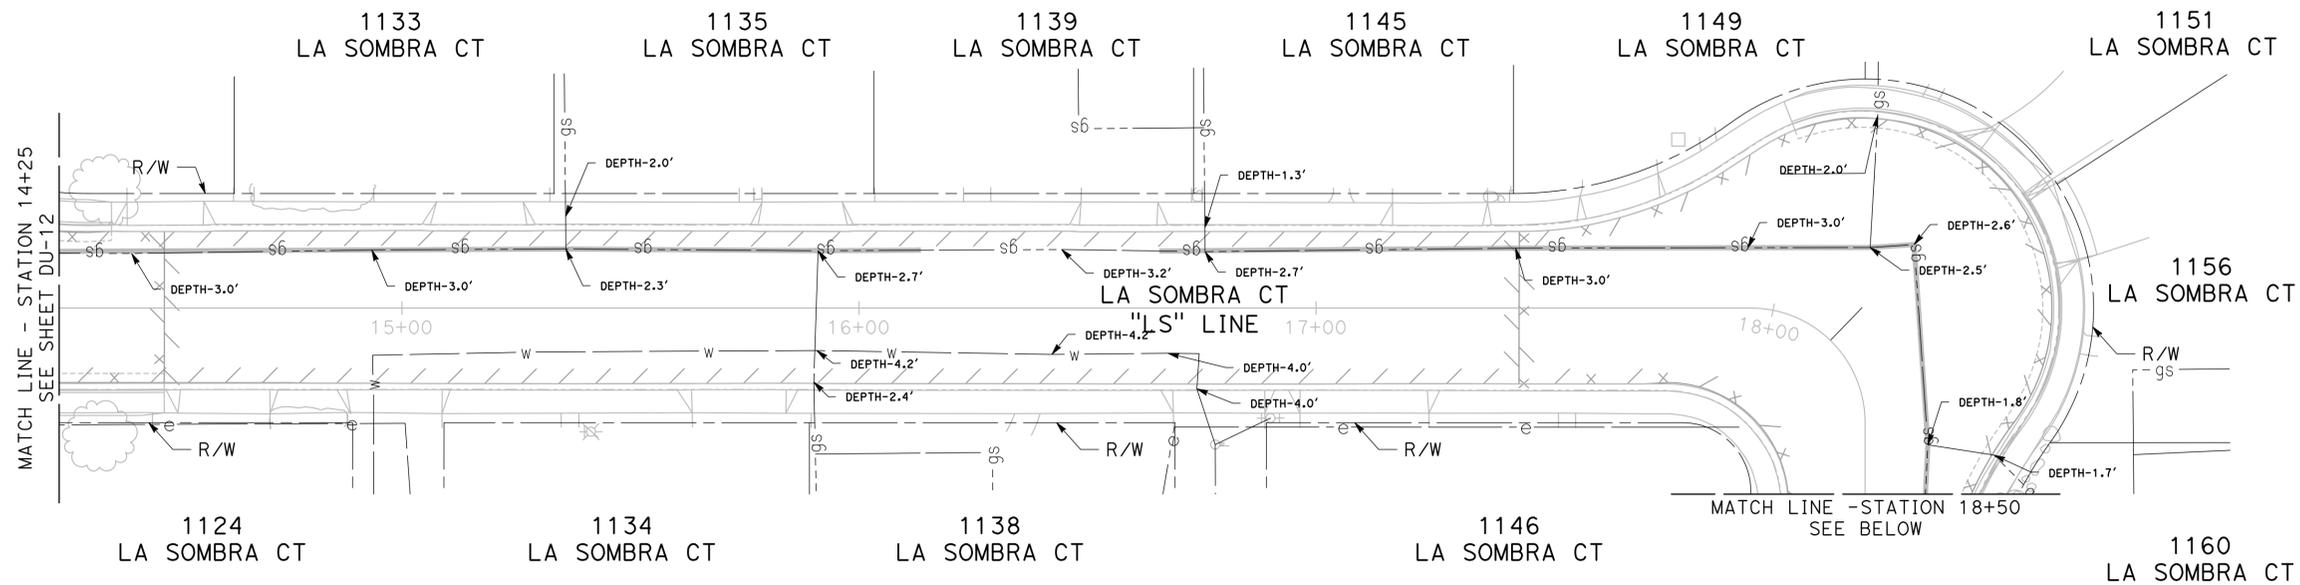

100% PLANS

DESIGNED BY: POORE, B.
 DRAWN BY: FRANCO, N.
 CHECKED BY: NORIEGA, E.
 SCALE: 1"=20'
 DATE: 5/21/2025
 JOB NO.: 24-00061

NOTE:
 ALL REFERENCES AND WRITTEN DIMENSIONS SHALL SUPERCEDE ALL SCALED DISTANCES AND SHALL BE VERIFIED IN THE FIELD. ANY DISCREPANCY SHALL BE BROUGHT TO THE ATTENTION OF THE ENGINEER PRIOR TO THE COMMENCEMENT OF WORK.

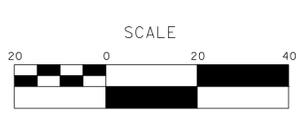



MARK THOMAS
 701 UNIVERSITY AVENUE, SUITE 200
 SACRAMENTO, CALIFORNIA 95825
 (916) 381-9100 FAX:(916)381-9180
 markthomas.com

CITY OF TURLOCK
 MUNICIPAL SERVICES DEPARTMENT
 156 S. BROADWAY
 SUITE 150
 (209) 668-5520



CITY OF TURLOCK
ROADS PROGRAM CIP
PROJECT 23-067 PACKAGE #3
UNDERGROUND UTILITY DEPTHS


Sheet **99**
 of
126 Sheets
UUD - 13

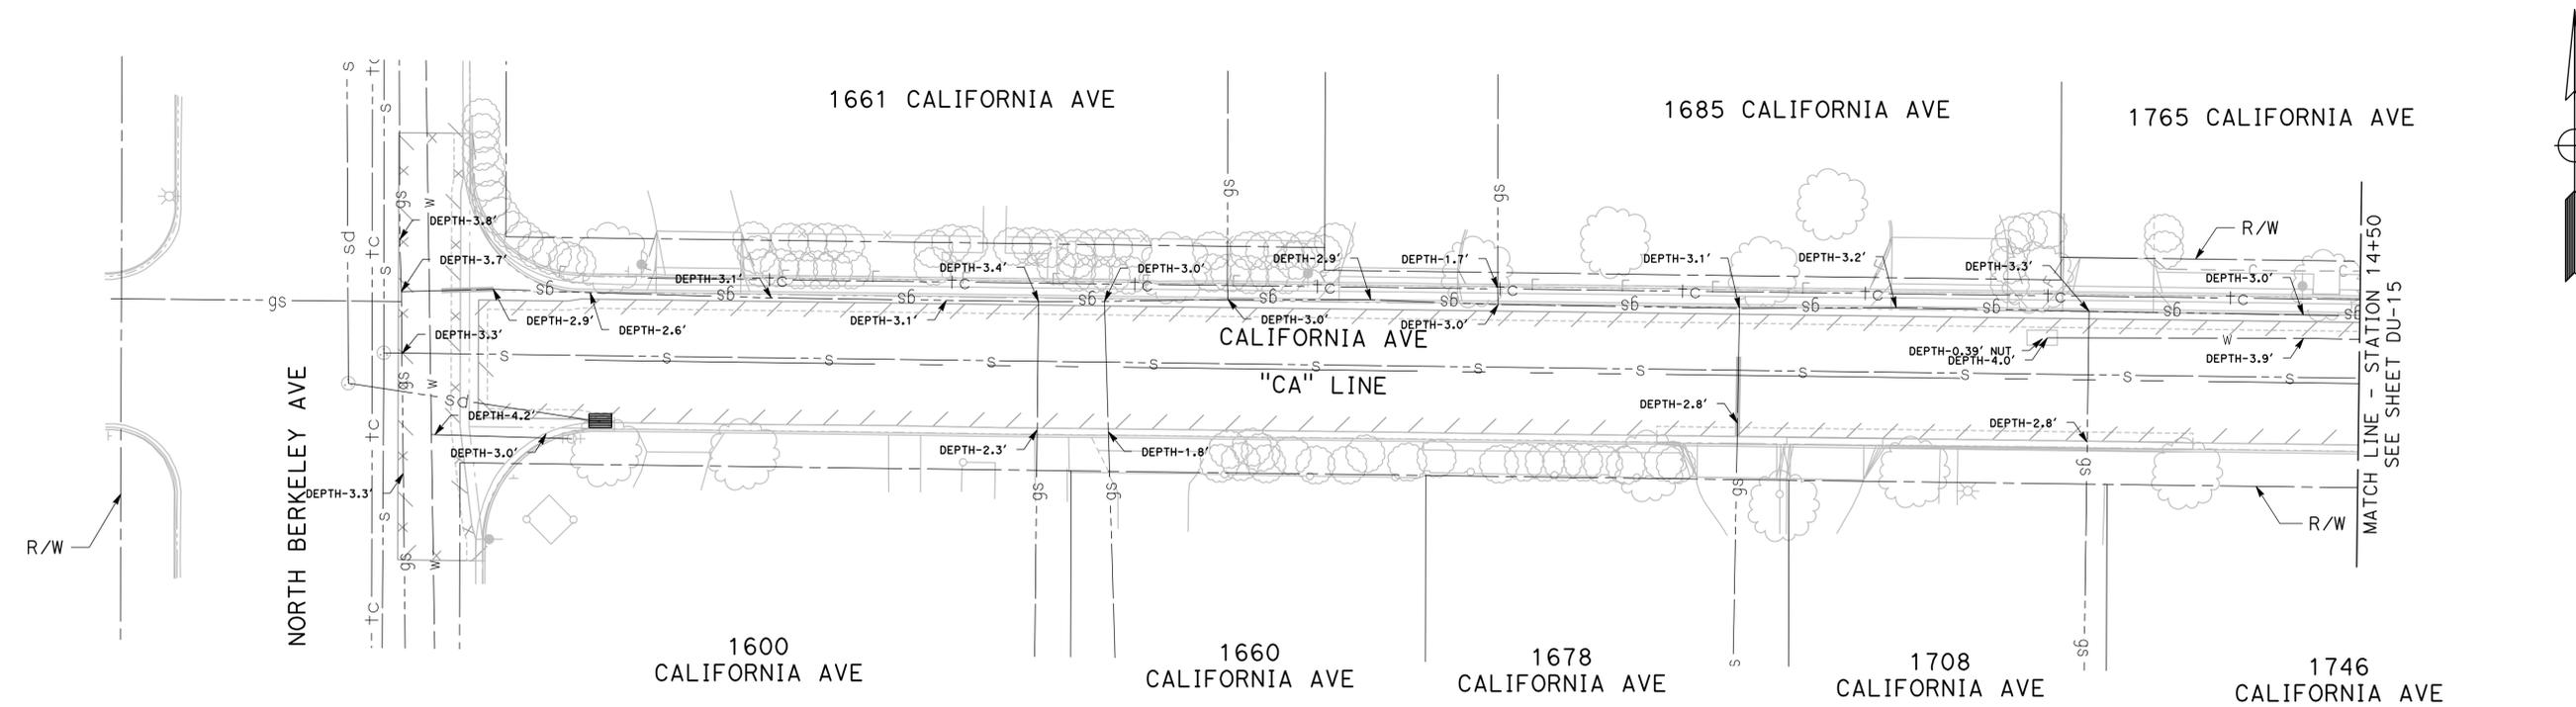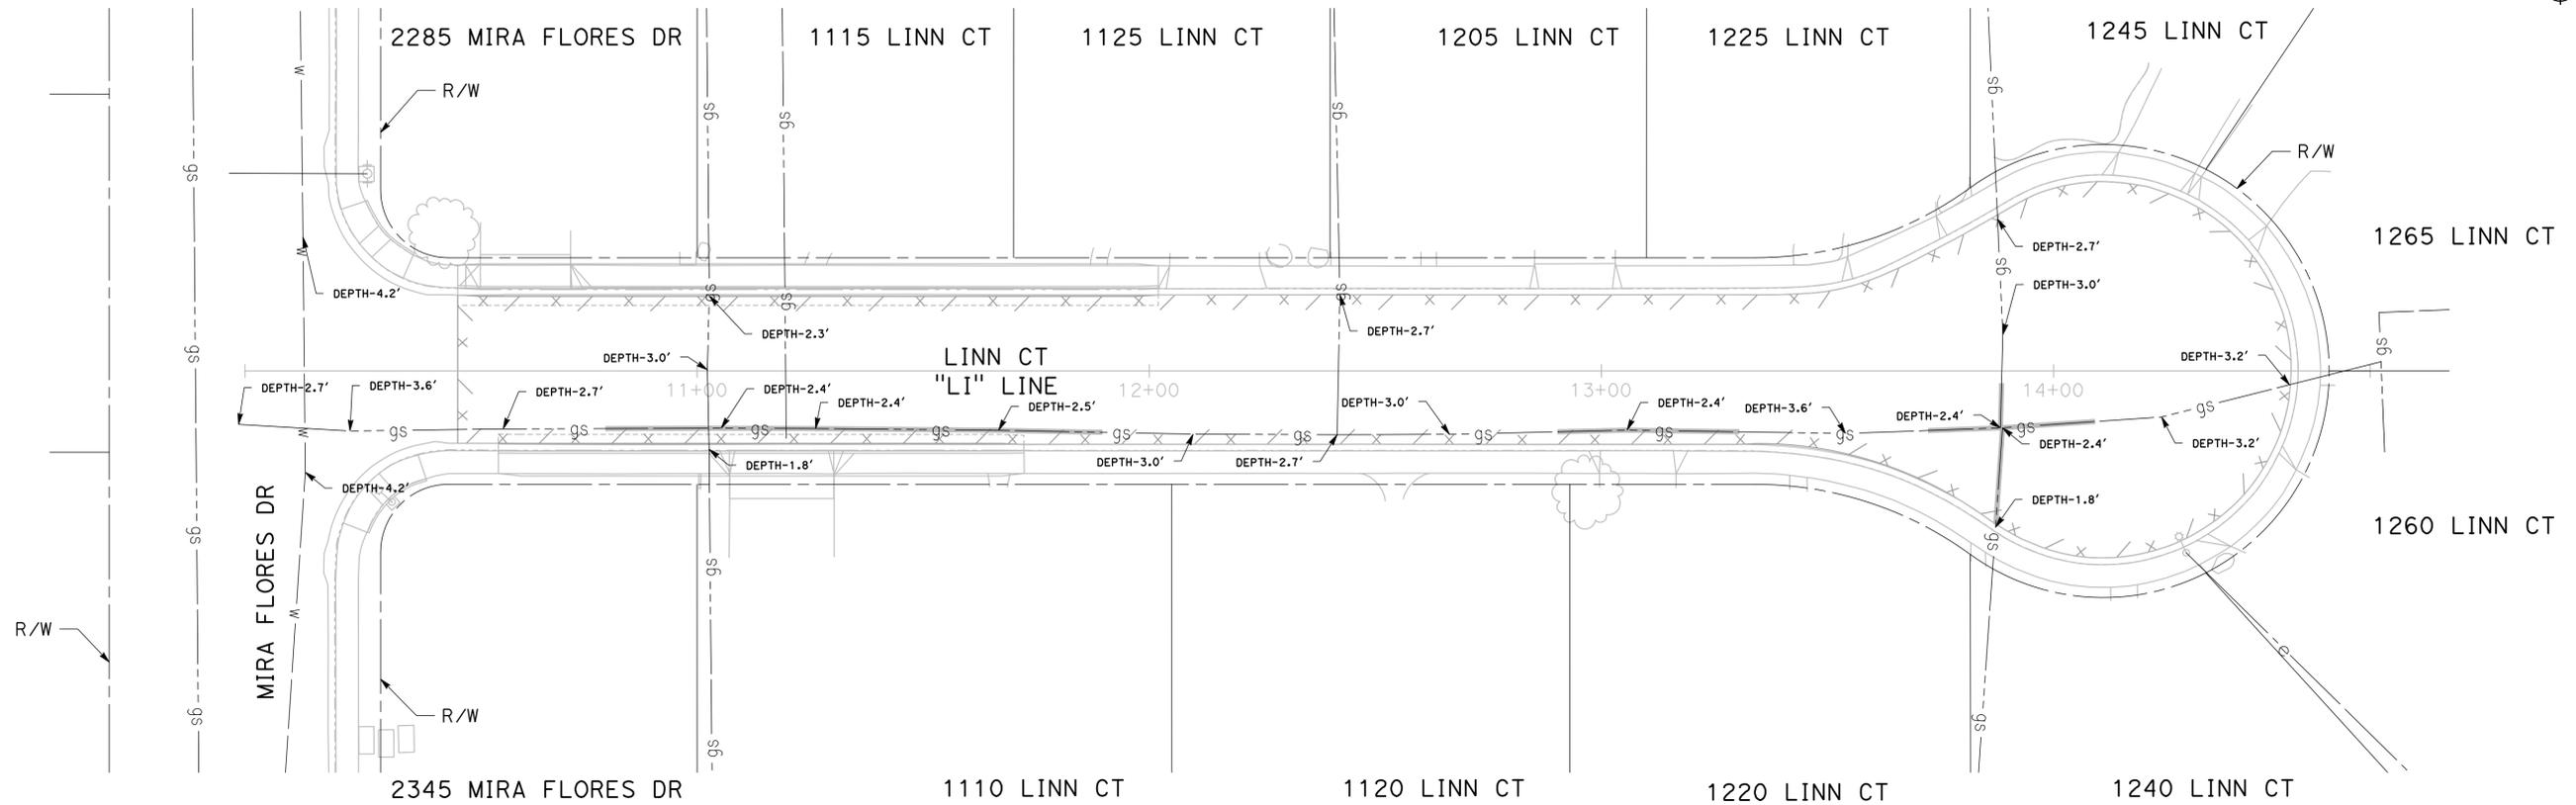

100% PLANS

DESIGNED BY: POORE, B.
 DRAWN BY: FRANCO, N.
 CHECKED BY: NORIEGA, E.
 SCALE: 1"=20'
 DATE: 5/21/2025
 JOB NO.: 24-00061

NOTE:
 ALL REFERENCES AND WRITTEN DIMENSIONS SHALL SUPERCEDE ALL SCALED DISTANCES AND SHALL BE VERIFIED IN THE FIELD. ANY DISCREPANCY SHALL BE BROUGHT TO THE ATTENTION OF THE ENGINEER PRIOR TO THE COMMENCEMENT OF WORK.

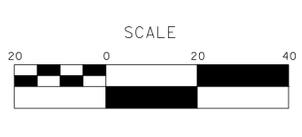



MARK THOMAS
 701 UNIVERSITY AVENUE, SUITE 200
 SACRAMENTO, CALIFORNIA 95825
 (916) 381-9100 FAX:(916)381-9180
 markthomas.com

CITY OF TURLOCK
 MUNICIPAL SERVICES DEPARTMENT
 156 S. BROADWAY
 SUITE 150
 (209) 668-5520



CITY OF TURLOCK
ROADS PROGRAM CIP
PROJECT 23-067 PACKAGE #3
UNDERGROUND UTILITY DEPTHS

Sheet **100**
 of
126 Sheets
UUD - 14

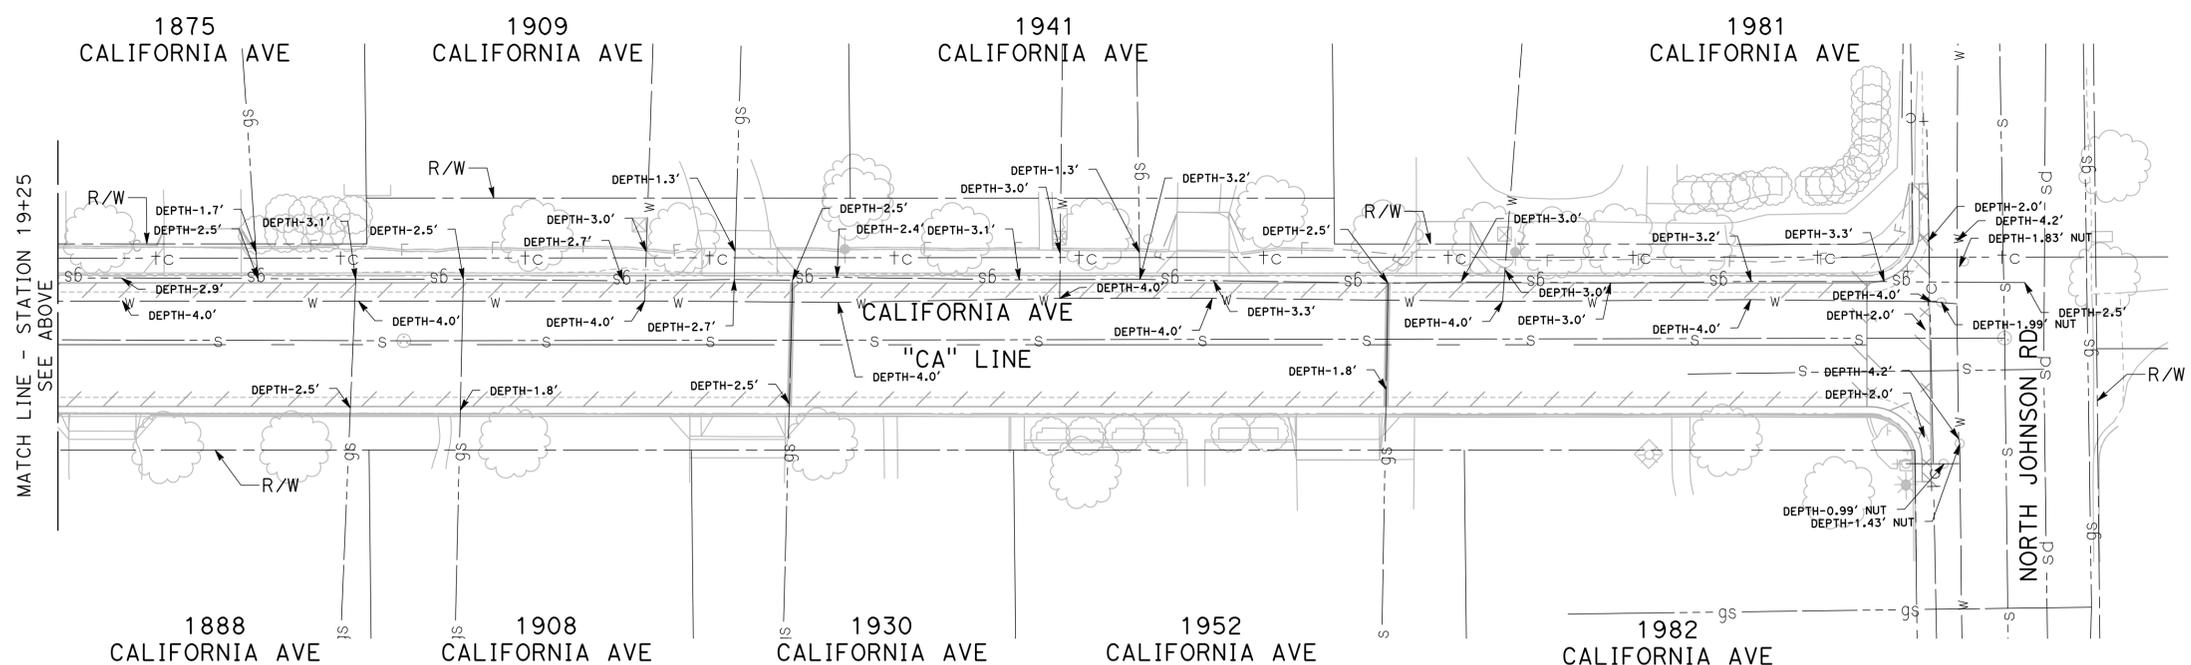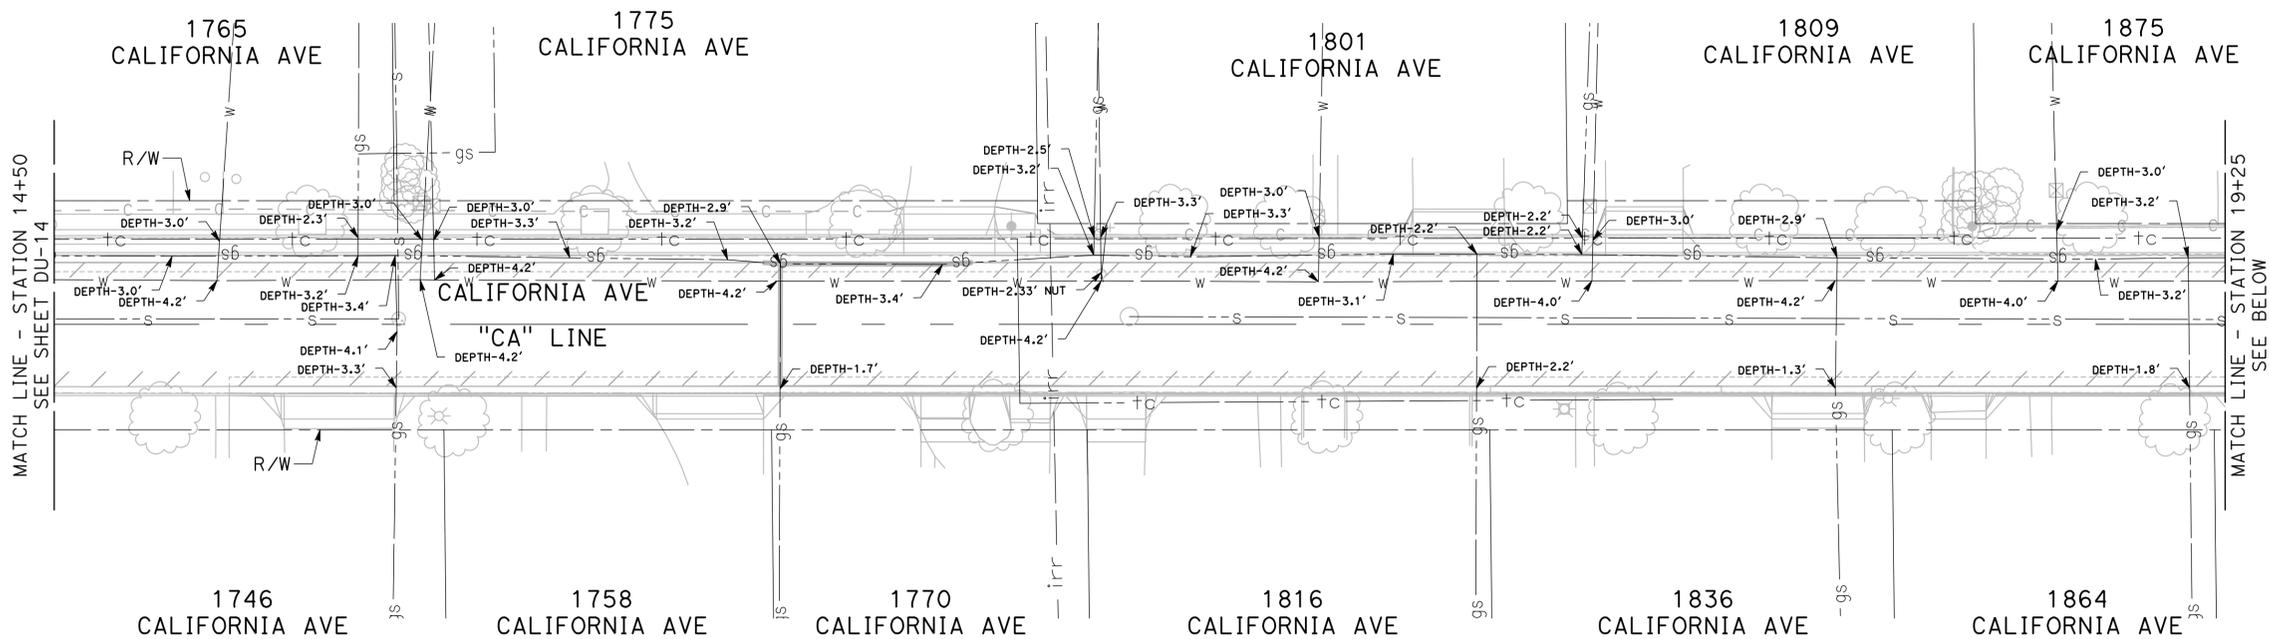

100% PLANS

DESIGNED BY: POORE, B.
 DRAWN BY: FRANCO, N.
 CHECKED BY: NORIEGA, E.
 SCALE: 1"=20'
 DATE: 5/21/2025
 JOB NO.: 24-00061

NOTE:
 ALL REFERENCES AND WRITTEN DIMENSIONS SHALL SUPERCEDE ALL SCALED DISTANCES AND SHALL BE VERIFIED IN THE FIELD. ANY DISCREPANCY SHALL BE BROUGHT TO THE ATTENTION OF THE ENGINEER PRIOR TO THE COMMENCEMENT OF WORK.



MARK THOMAS
 701 UNIVERSITY AVENUE, SUITE 200
 SACRAMENTO, CALIFORNIA 95825
 (916) 381-9100 FAX:(916)381-9180
 markthomas.com

CITY OF TURLOCK
 MUNICIPAL SERVICES DEPARTMENT
 156 S. BROADWAY
 SUITE 150
 (209) 668-5520




CITY OF TURLOCK
ROADS PROGRAM CIP
PROJECT 23-067 PACKAGE #3
UNDERGROUND UTILITY DEPTHS

Sheet **101**
 of **126** Sheets
UUD - 15

NOTES:


1. LOCATION REFERENCE FOR MH IS AT CENTER OF THE LID.
2. LOCATION INFORMATION FOR DI ADJACENT TO THE CURB & GUTTER IS PROVIDED ALONG THE FLOWLINE AT THE CENTER OF THE GRATE.
3. INFORMATION FOR CITY OF TURLOCK Std DETAIL SD-3 AND S-3.
4. MINIMUM VERTICAL CLEARANCE OF 12" SHALL BE MAINTAINED BETWEEN CROSSING UTILITIES PER CITY OF TURLOCK Std DETAIL W-14.

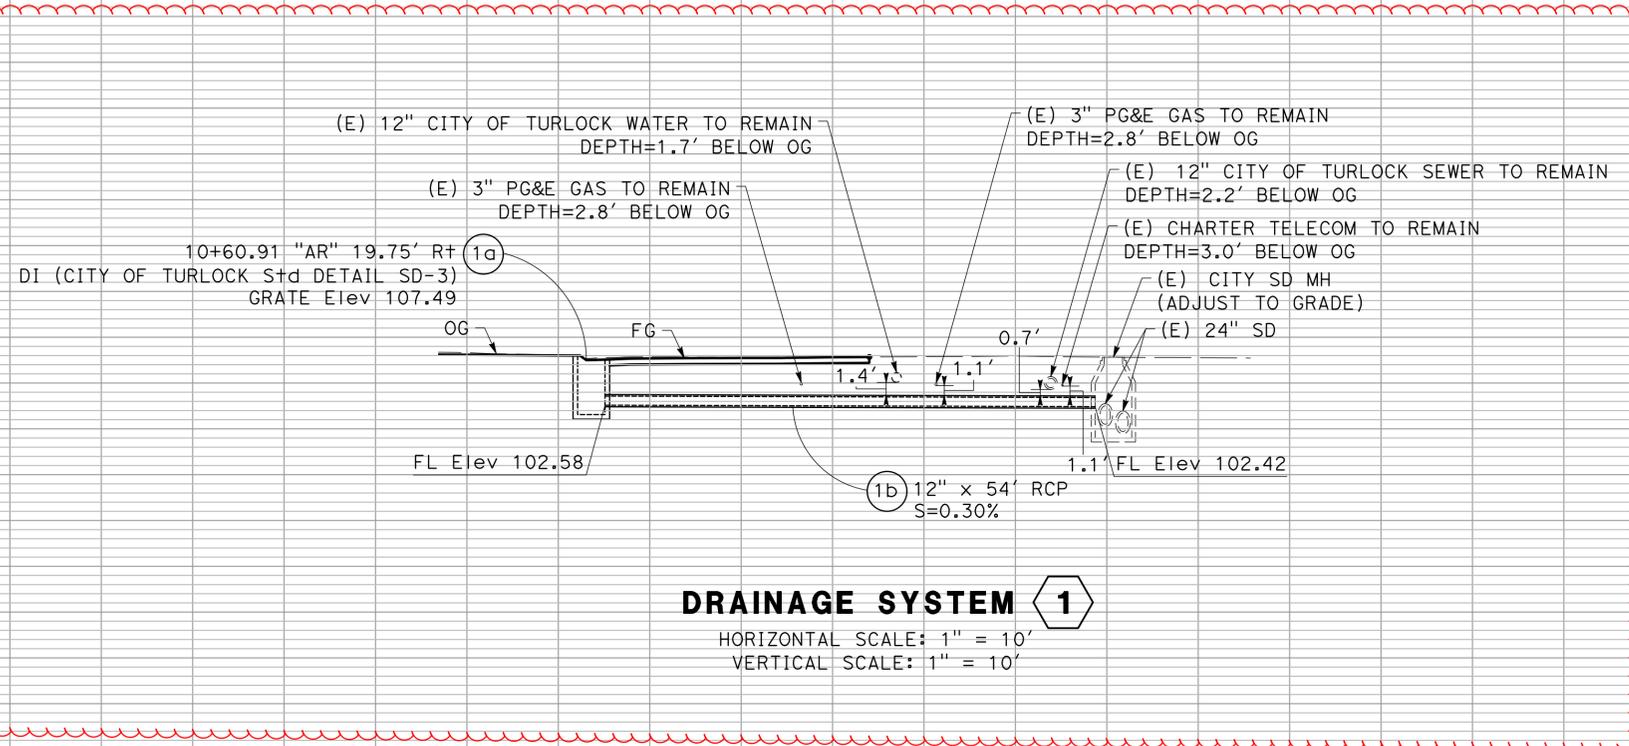

100% PLANS

DESIGNED BY: POORE, B.
 DRAWN BY: FRANCO, N.
 CHECKED BY: NORIEGA, E.
 SCALE: 1"=10'
 DATE: 5/21/2025
 JOB NO.: 24-00061

NOTE:
 ALL REFERENCES AND WRITTEN DIMENSIONS SHALL SUPERCEDE ALL SCALED DISTANCES AND SHALL BE VERIFIED IN THE FIELD. ANY DISCREPANCY SHALL BE BROUGHT TO THE ATTENTION OF THE ENGINEER PRIOR TO THE COMMENCEMENT OF WORK.

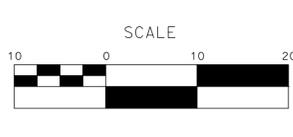

MARK THOMAS
 701 UNIVERSITY AVENUE, SUITE 200
 SACRAMENTO, CALIFORNIA 95825
 (916) 381-9100 FAX:(916)381-9180
 markthomas.com

CITY OF TURLOCK
 MUNICIPAL SERVICES
 DEPARTMENT
 156 S. BROADWAY
 SUITE 150
 (209)668-5520



**CITY OF TURLOCK
 ROADS PROGRAM CIP
 PROJECT 23-067 PACKAGE #3
 DRAINAGE PROFILE**


Sheet **102**
 of
126 Sheets

DP-1


TRAFFIC CONTROL GENERAL NOTES:

1. VALIDATION: THE TRAFFIC CONTROL PLAN IS NOT VALID UNTIL WORK DATES ARE APPROVED. THE CONTRACTOR SHALL, PER SECTION 601-2 OF THE CITY SUPPLEMENT TO THE STANDARD SPECIFICATIONS FOR PUBLIC WORKS CONSTRUCTION, CONTACT THE PUBLIC WORKS TRAFFIC CONTROL SECTION AT (209) 668-5520 TO OBTAIN A PERMIT. THE CONTRACTOR MUST SUBMIT A COMPLETED TRAFFIC CONTROL PERMIT FORM A MINIMUM OF TWO (2) WORKING DAYS PRIOR TO STARTING WORK, OR FIVE (5) WORKING DAYS WHEN WORK WILL AFFECT A TRAFFIC SIGNAL.
2. STANDARDS: THIS TRAFFIC CONTROL PLAN SHALL CONFORM TO EACH OF THE FOLLOWING MANUALS:

EDITION	DESCRIPTION
2014	CALIFORNIA MANUAL ON UNIFORM TRAFFIC CONTROL DEVICES (CA MUTCD)
2016	CITY OF TURLOCK STANDARD SPECIFICATIONS AND DRAWINGS
2023	CALTRANS STANDARD PLANS
3. NOTIFICATIONS: THE CONTRACTOR SHALL NOTIFY RELEVANT AGENCIES A MINIMUM OF FIVE (5) WORKING DAYS PRIOR TO ANY EXCAVATION, CONSTRUCTION, OR TRAFFIC CONTROL.
4. THE CONTRACTOR SHALL NOTIFY PROPERTY OWNERS AND TENANTS A MINIMUM OF SEVEN (7) WORKING DAYS PRIOR TO CLOSURE OF DRIVEWAYS. THE CONTRACTOR SHALL POST SIGNS NOTIFYING THE PUBLIC A MINIMUM OF SEVEN (7) WORKING DAYS PRIOR TO CLOSURE OF STREETS.
5. POSTING PARKING RESTRICTIONS: THE CONTRACTOR SHALL POST "TOW-AWAY/NO PARKING SIGNS SEVENTY TWO (72) HOURS IN ADVANCE OF PARKING REMOVAL. SIGNS SHALL INDICATE SPECIFIC DAYS, DATES, AND TIMES OF RESTRICTIONS.
6. EXCAVATIONS: EXCEPT AS OTHERWISE SHOWN ON THE PLANS, TRENCHES SHALL BE BACKFILLED OR TRENCH-PLATED AT THE END OF EACH WORK DAY, AN ASPHALT RAMP SHALL BE PLACED AROUND EACH TRENCH PLATE TO PREVENT THE PLATE FROM BEING DISLODGED. CONTRACTOR SHALL MONITOR TRENCH PLATES DURING NON-WORKING HOURS TO ENSURE THAT THEY DO NOT BECOME DISLODGED, UPON COMPLETION OF EXCAVATION BACKFILL, THE CONTRACTOR SHALL PROVIDE A SATISFACTORY SURFACE FOR TRAFFIC, WHEN CONSTRUCTION OPERATIONS ARE NOT ACTIVELY IN PROGRESS, THE CONTRACTOR SHALL MAINTAIN ALL TRAVEL LANES, BIKE LANES, AND PEDESTRIAN WALKWAYS OPEN TO THE APPROPRIATE TRAFFIC EXCEPT AS OTHERWISE SHOWN ON THE PLANS.
7. RESTORATION OF TRAFFIC CONTROL DEVICES: THE CONTRACTOR SHALL REPAIR OR REPLACE TRAFFIC CONTROL DEVICES (INCLUDING TRAFFIC SIGNS, STRIPING, PAVEMENT MARKERS, PAVEMENT MARKINGS, LEGENDS, CURB MARKINGS, LOOP DETECTORS, TRAFFIC SIGNAL EQUIPMENT, ETC.) DAMAGED OR REMOVED AS A RESULT OF OPERATIONS AND NOT DESIGNATED FOR REMOVAL. REPAIRS AND REPLACEMENTS SHALL BE AT LEAST EQUAL TO EXISTING IMPROVEMENT.
8. TEMPORARY TRAFFIC SIGNAL DETECTION: THE CONTRACTOR SHALL INSTALL CITY APPROVED TEMPORARY VIDEO OR RADAR DETECTION WHEN EXISTING TRAFFIC SIGNAL DETECTION SYSTEMS ARE DAMAGED, DISABLED, OR BECOME INEFFECTIVE DUE TO CONSTRUCTION FOR A PERIOD OF FIVE (5) OR MORE DAYS. THE CONTRACTOR SHALL COMPLETELY REMOVE ALL TEMPORARY TRAFFIC SIGNAL DETECTION EQUIPMENT AND RESTORE/INSTALL A CITY APPROVED PERMANENT VEHICLE DETECTION SYSTEM UPON COMPLETION OF CONSTRUCTION. ALL INSTALLATION AND REMOVALS ARE SUBJECT TO APPROVAL BY THE CITY ENGINEER.
9. CHANGE IN WORK: THE CITY ENGINEER WILL OBSERVE THESE TRAFFIC CONTROL PLANS IN OPERATION AND RESERVE THE RIGHT TO MAKE ANY CHANGES AS FIELD CONDITIONS WARRANT, ANY CHANGES SHALL BE DOCUMENTED AND SUPERCEDE THESE PLANS.
10. OPEN TRENCH: THE CONTRACTOR SHALL PLACE "OPEN TRENCH" SIGNS (C27(CA)) ON TYPE BARRICADES WITHIN THE WORK ZONE, AHEAD OF ANY WORK AREA WHICH INCLUDES OPEN TRENCHES IN EXCESS OF THREE (3) INCHES IN DEPTH, PER CA MUTCD SECTION 6F.103 (CA) GUIDELINES.
11. FOR WORK NOT COVERED BY THESE TRAFFIC CONTROL PLANS: THE CONTRACTOR SHALL PREPARE TRAFFIC CONTROL WORKING DRAWINGS AND SUBMIT THEM TO THE CITY RESIDENT ENGINEER. THE CONTRACTOR SHALL ALLOW A MINIMUM OF TWENTY (20) WORKING DAYS FOR REVIEW OF THE WORKING DRAWINGS. UPON APPROVAL OF THE TRAFFIC CONTROL PLAN, THE PUBLIC WORKS TRAFFIC CONTROL SECTION WILL ISSUE A TRAFFIC CONTROL PLAN (TCP) PERMIT FOR THIS WORK.
12. CONTRACTOR SHALL INSTALL UNEVEN PAVEMENT SIGNS C46 (CA) ALONG THE EDGE OF AREAS WHERE A STEP OF GREATER THAN 2" EXISTS WHETHER PARALLEL OR PERPENDICULAR TO THE DIRECTION OF TRAVEL.
13. SEE TABLE 6H-3 IN THE CALIFORNIA MANUAL ON UNIFORM TRAFFIC CONTROL DEVICES (CA MUTCD) FOR MEANING OF LETTER CODES ON TYPICAL APPLICATION DIAGRAMS.
14. CONTRACTOR SHALL DEPLOY EIGHT (8) PORTABLE CHANGEABLE MESSAGE SYSTEMS (PCMS) THROUGHOUT CONSTRUCTION, WITH FINAL PLACEMENT TO BE DETERMINED BY ENGINEER.
15. CONTRACTOR SHALL DEPLOY TWELVE (12) CONSTRUCTION FUNDING SIGN PLACEMENT THROUGHOUT CONSTRUCTION, WITH FINAL PLACEMENT TO BE DETERMINED BY ENGINEER.

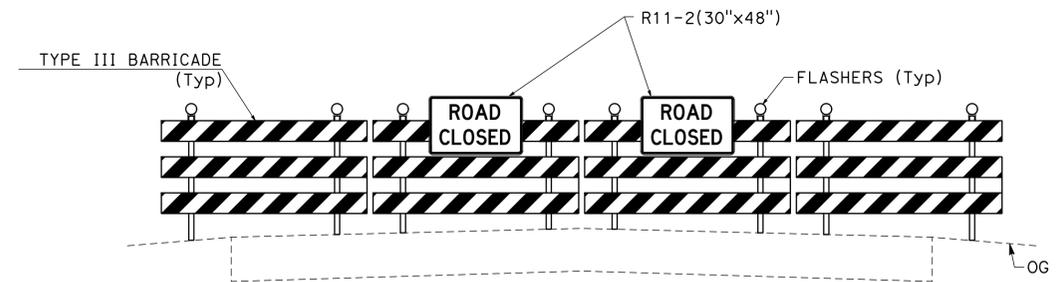

1 TH-1 TEMPORARY BARRICADE ROAD CLOSURE DETAIL

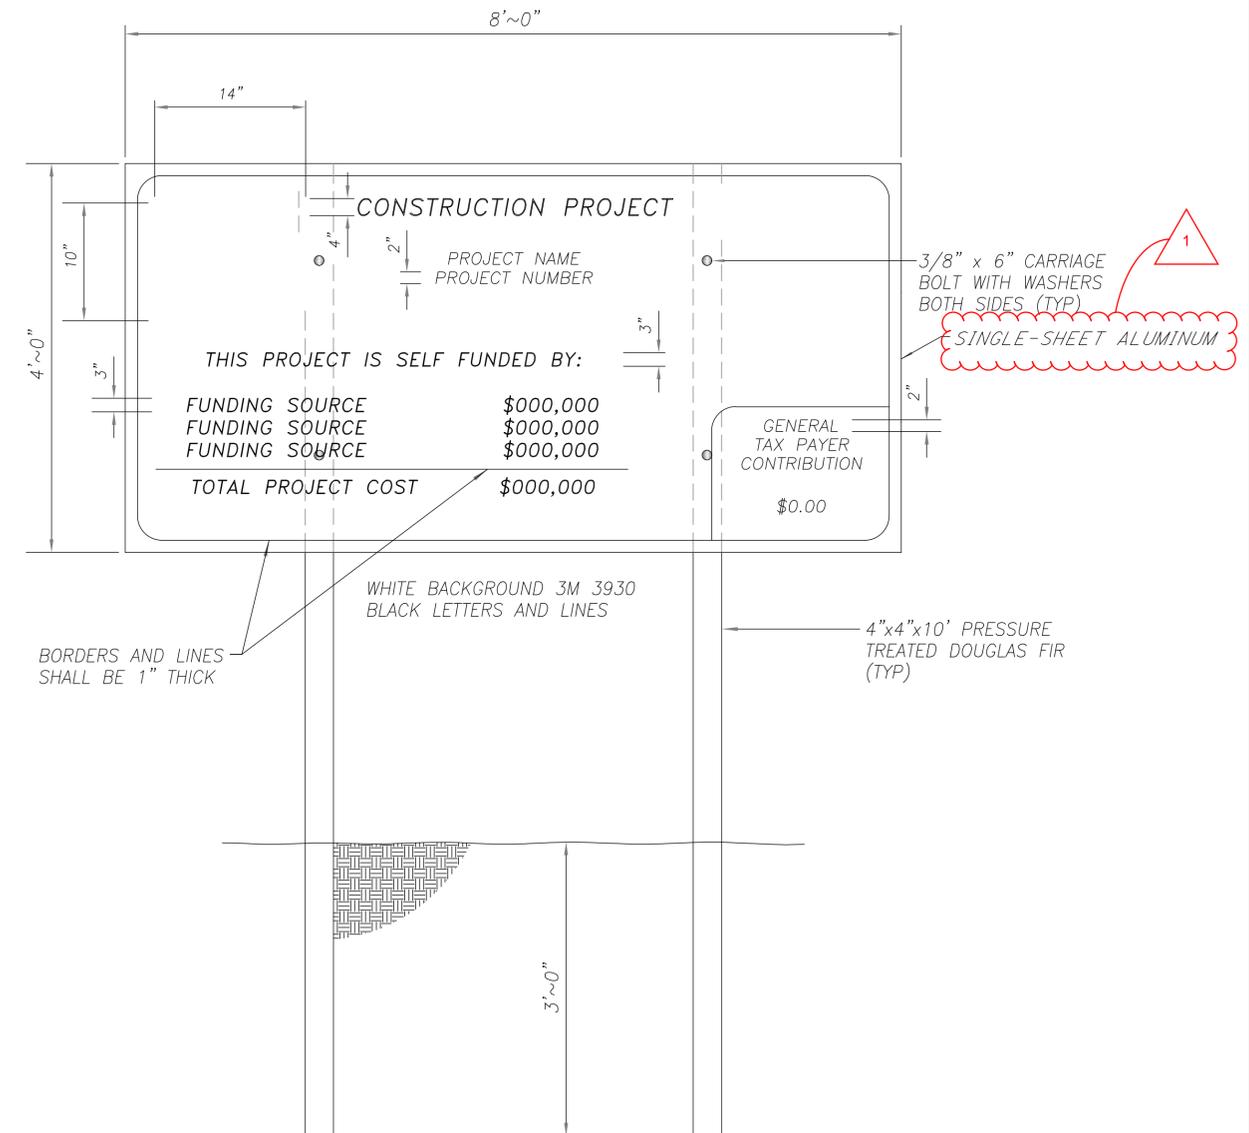

2 TH-1 CONSTRUCTION FUNDING SIGN

100% PLANS

DESIGNED BY: POORE, B.
 DRAWN BY: FRANCO, N.
 CHECKED BY: NORIEGA, E.
 SCALE: NOT TO SCALE
 DATE: 5/21/2025
 JOB NO.: 24-00061

NOTE:
 ALL REFERENCES AND WRITTEN DIMENSIONS SHALL SUPERCEDE ALL SCALED DISTANCES AND SHALL BE VERIFIED IN THE FIELD. ANY DISCREPANCY SHALL BE BROUGHT TO THE ATTENTION OF THE ENGINEER PRIOR TO THE COMMENCEMENT OF WORK.



MARK THOMAS
 701 UNIVERSITY AVENUE, SUITE 200
 SACRAMENTO, CALIFORNIA 95825
 (916) 381-9100 FAX:(916)381-9180
 markthomas.com

CITY OF TURLOCK
 MUNICIPAL SERVICES
 DEPARTMENT
 156 S. BROADWAY
 SUITE 150
 (209) 668-5520



**CITY OF TURLOCK
 ROADS PROGRAM CIP
 PROJECT 23-067 PACKAGE #3
 TRAFFIC HANDLING**

Sheet **103**
 of
126 Sheets

TH-1

NOTES (SS-1 TO SS-15):

1. ALL TRAFFIC STRIPES & PAVEMENT MARKINGS TO BE THERMOPLASTIC AND PER CALTRANS STANDARD PLANS UNLESS OTHERWISE NOTED.
2. THIS PLAN IS ACCURATE FOR SIGNING AND STRIPING WORK WITHIN THE PUBLIC RIGHT OF WAY ONLY.
3. EXACT POSITION AND LOCATION OF ALL ROADSIDE SIGNS SHALL BE DETERMINED IN THE FIELD BY THE ENGINEER.
4. SIGN NUMBER PER CALIFORNIA MUTCD 2014 EDITION.
5. IN LOCATIONS WHERE CURB AND GUTTER IS RECONSTRUCTED IN FRONT OF A FIRE HYDRANT, CONTRACTOR TO REPLACE BLUE PAVEMENT MARKER (BB) PER CITY OF TURLOCK DETAIL W-3.

ABBREVIATIONS (SS-1 TO SS-15):


- SNS STREET NAME SIGN
SSBM STRAP AND SADDLE BRACKET METHOD

LEGEND (SS-1 TO SS-15):

- | | | | |
|--|---|--|---------------------------|
| | CALTRANS STRIPING DETAIL NUMBER
L= LENGTH | | "STOP" PAVEMENT MARKING |
| | REMOVE CALTRANS STRIPING DETAIL NUMBER
L= LENGTH | | "SLOW" PAVEMENT MARKING |
| | EXISTING ROADSIDE SIGN TO REMAIN | | "SCHOOL" PAVEMENT MARKING |
| | INSTALL ROADSIDE SIGN | | "XING" PAVEMENT MARKING |
| | RELOCATE/RESET EXISTING ROADSIDE SIGN | | "AHEAD" PAVEMENT MARKING |
| | REMOVE EXISTING ROADSIDE SIGN | | "YIELD" PAVEMENT MARKING |
| | EXISTING ROADSIDE SIGN | | |
| | ROADSIDE SIGN (ONE-POST) | | |
| | BC/EC | | |
| | ANGLE POINT | | |
| | TYPE I ARROW | | |

CONSTRUCTION NOTES (SS-1 TO SS-15):


1. INSTALL 12" WHITE THERMOPLASTIC LIMIT LINE & STOP LETTERS
 2. INSTALL WHITE THERMOPLASTIC CROSSWALK CITY DETAIL C-17
 3. INSTALL STOP LETTERS
 4. INSTALL SLOW LETTERS YELLOW
 5. INSTALL SCHOOL LETTERS YELLOW
 6. INSTALL XING LETTERS YELLOW
 7. INSTALL AHEAD LETTERS
 8. INSTALL TYPE I ARROW
 9. INSTALL YELLOW THERMOPLASTIC CROSSWALK CITY DETAIL C-17
- XX REMOVE THERMOPLASTIC TRAFFIC STRIPE/PAVEMENT MARKING

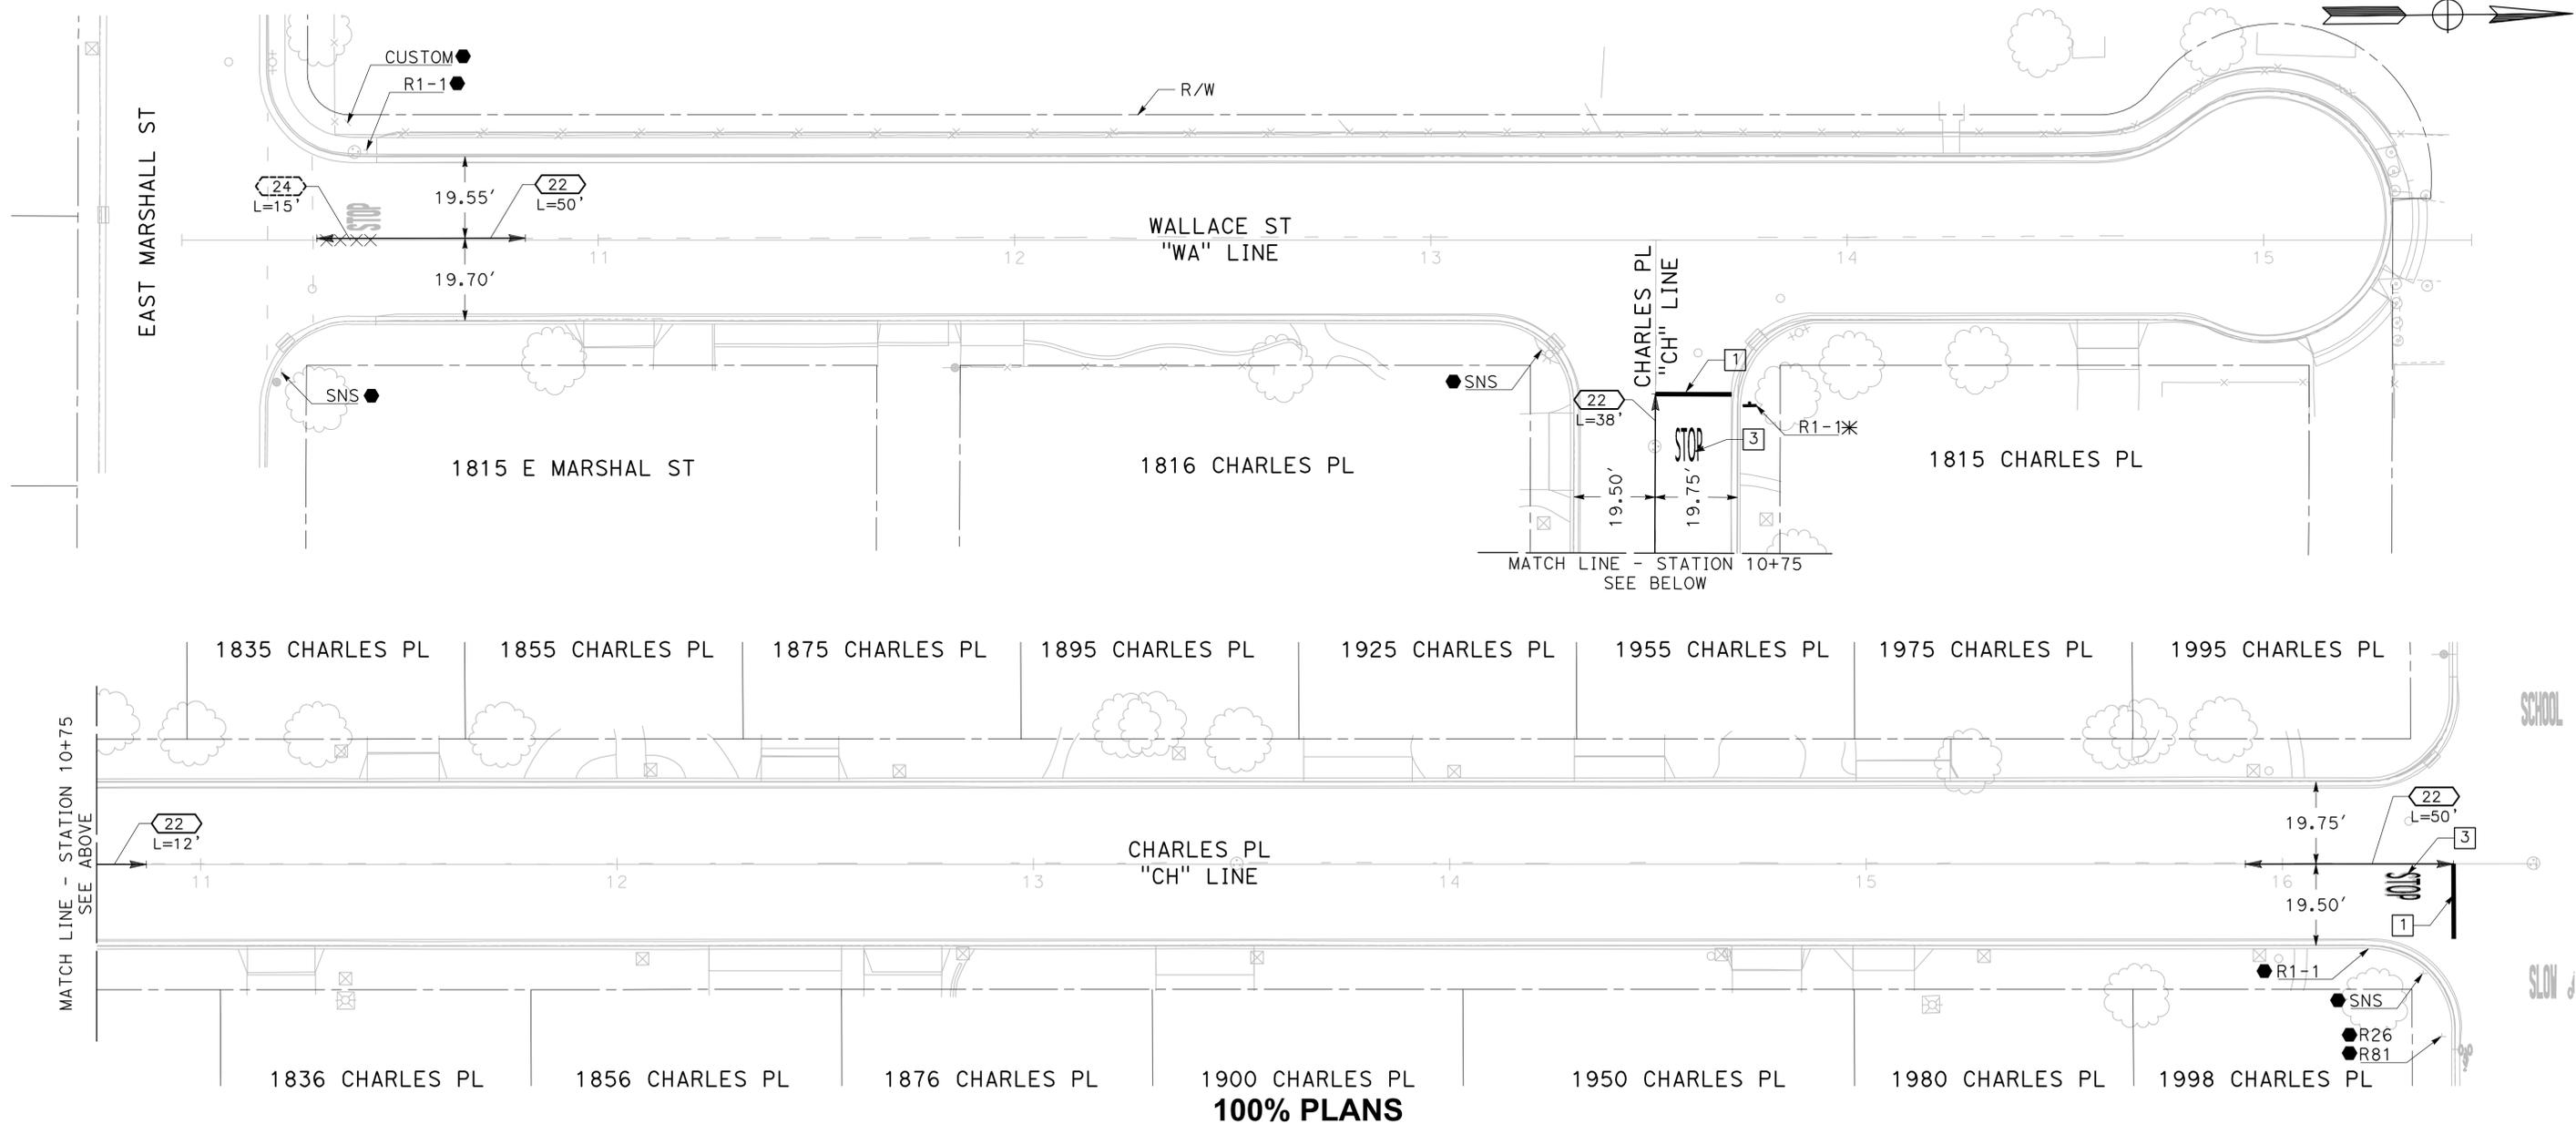

100% PLANS

DESIGNED BY: POORE, B.
DRAWN BY: FRANCO, N.
CHECKED BY: NORIEGA, E.
SCALE: 1"=20'
DATE: 5/22/2025
JOB NO.: 24-00061

NOTE:
ALL REFERENCES AND WRITTEN DIMENSIONS SHALL SUPERCEDE ALL SCALED DISTANCES AND SHALL BE VERIFIED IN THE FIELD. ANY DISCREPANCY SHALL BE BROUGHT TO THE ATTENTION OF THE ENGINEER PRIOR TO THE COMMENCEMENT OF WORK.

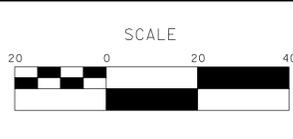




MARK THOMAS
701 UNIVERSITY AVENUE, SUITE 200
SACRAMENTO, CALIFORNIA 95825
(916) 381-9100 FAX:(916)381-9180
markthomas.com

CITY OF TURLOCK
MUNICIPAL SERVICES
DEPARTMENT
156 S. BROADWAY
SUITE 150
(209) 668-5520



**CITY OF TURLOCK
ROADS PROGRAM CIP
PROJECT 23-067 PACKAGE #3
SIGNAGE AND STRIPING**



Sheet **112**
of
126 Sheets
SS - 1

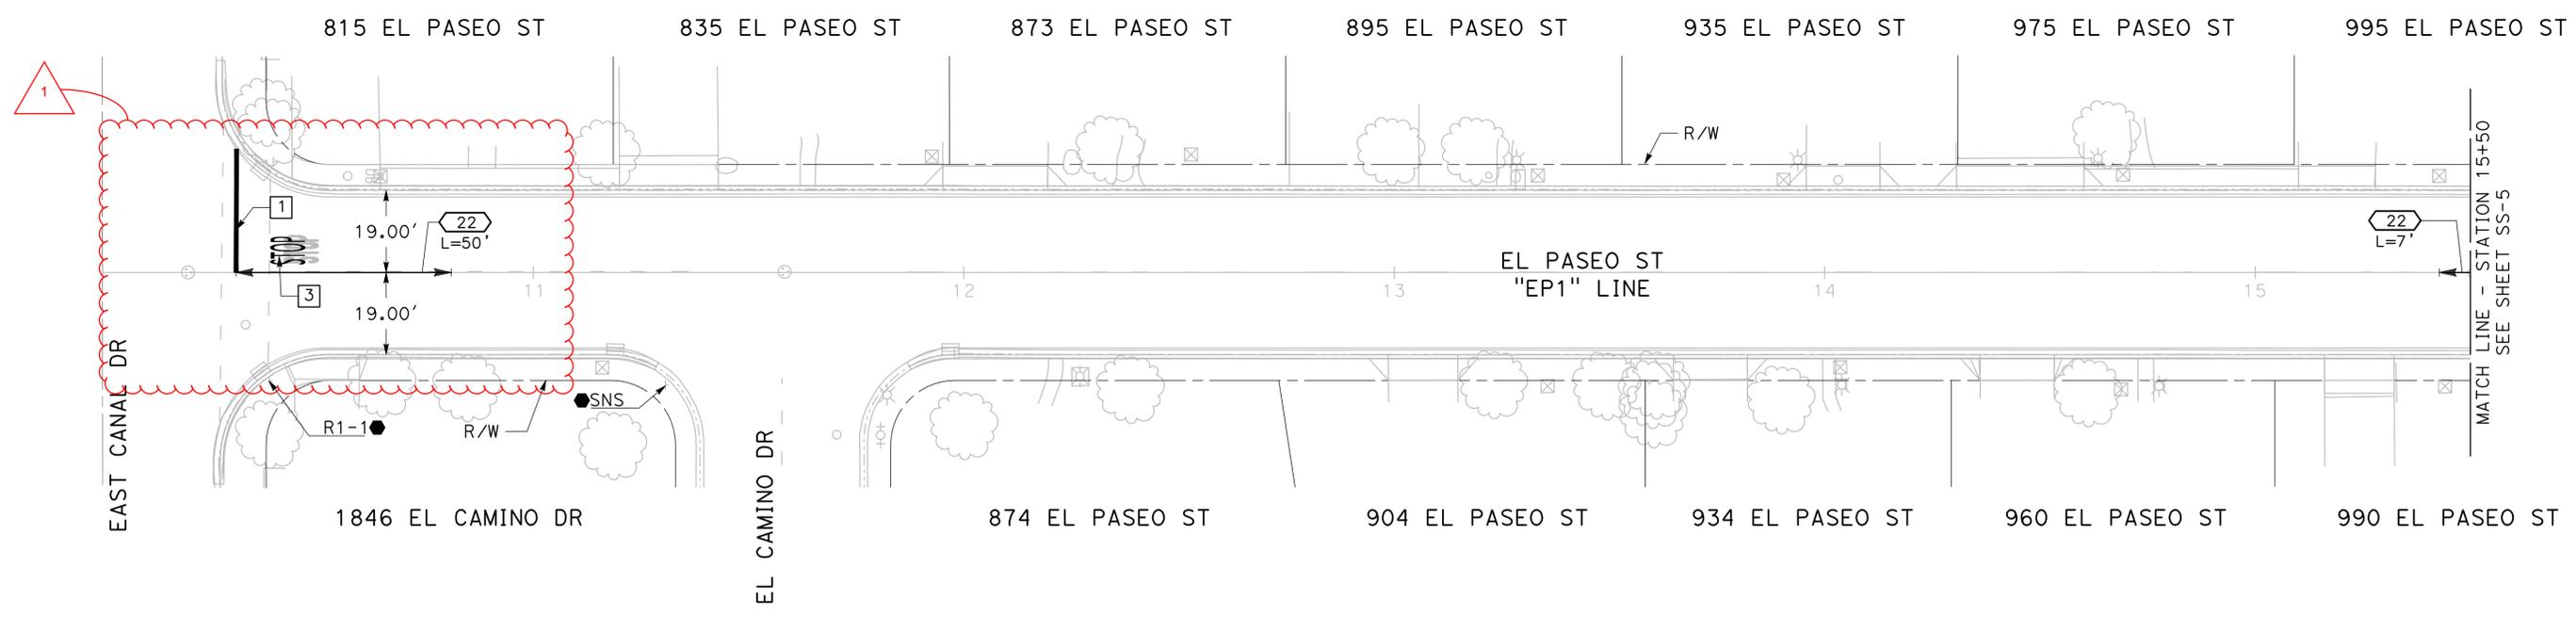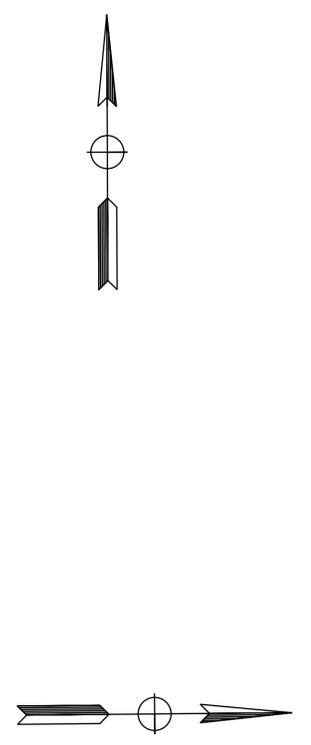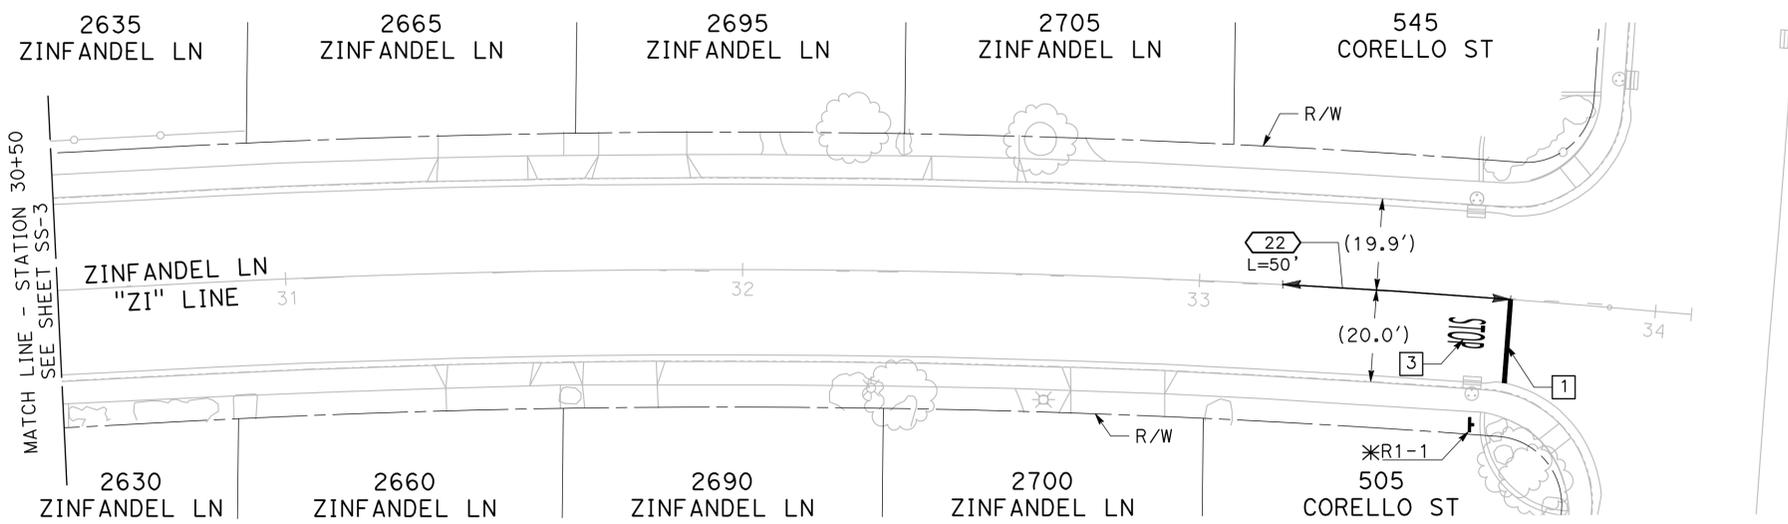

100% PLANS

DESIGNED BY: POORE, B.
 DRAWN BY: FRANCO, N.
 CHECKED BY: NORIEGA, E.
 SCALE: 1"=20'
 DATE: 5/21/2025
 JOB NO.: 24-00061

NOTE:
 ALL REFERENCES AND WRITTEN DIMENSIONS SHALL SUPERCEDE ALL SCALED DISTANCES AND SHALL BE VERIFIED IN THE FIELD. ANY DISCREPANCY SHALL BE BROUGHT TO THE ATTENTION OF THE ENGINEER PRIOR TO THE COMMENCEMENT OF WORK.

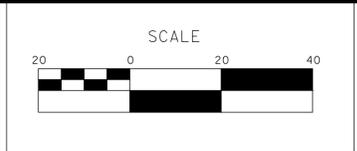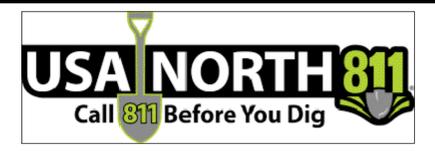



MARK THOMAS
 701 UNIVERSITY AVENUE, SUITE 200
 SACRAMENTO, CALIFORNIA 95825
 (916) 381-9100 FAX:(916)381-9180
 markthomas.com

CITY OF TURLOCK
 MUNICIPAL SERVICES DEPARTMENT
 156 S. BROADWAY
 SUITE 150
 (209) 668-5520



CITY OF TURLOCK
ROADS PROGRAM CIP
PROJECT 23-067 PACKAGE #3
SIGNAGE AND STRIPING


Sheet **115**
 of
126 Sheets
SS - 4

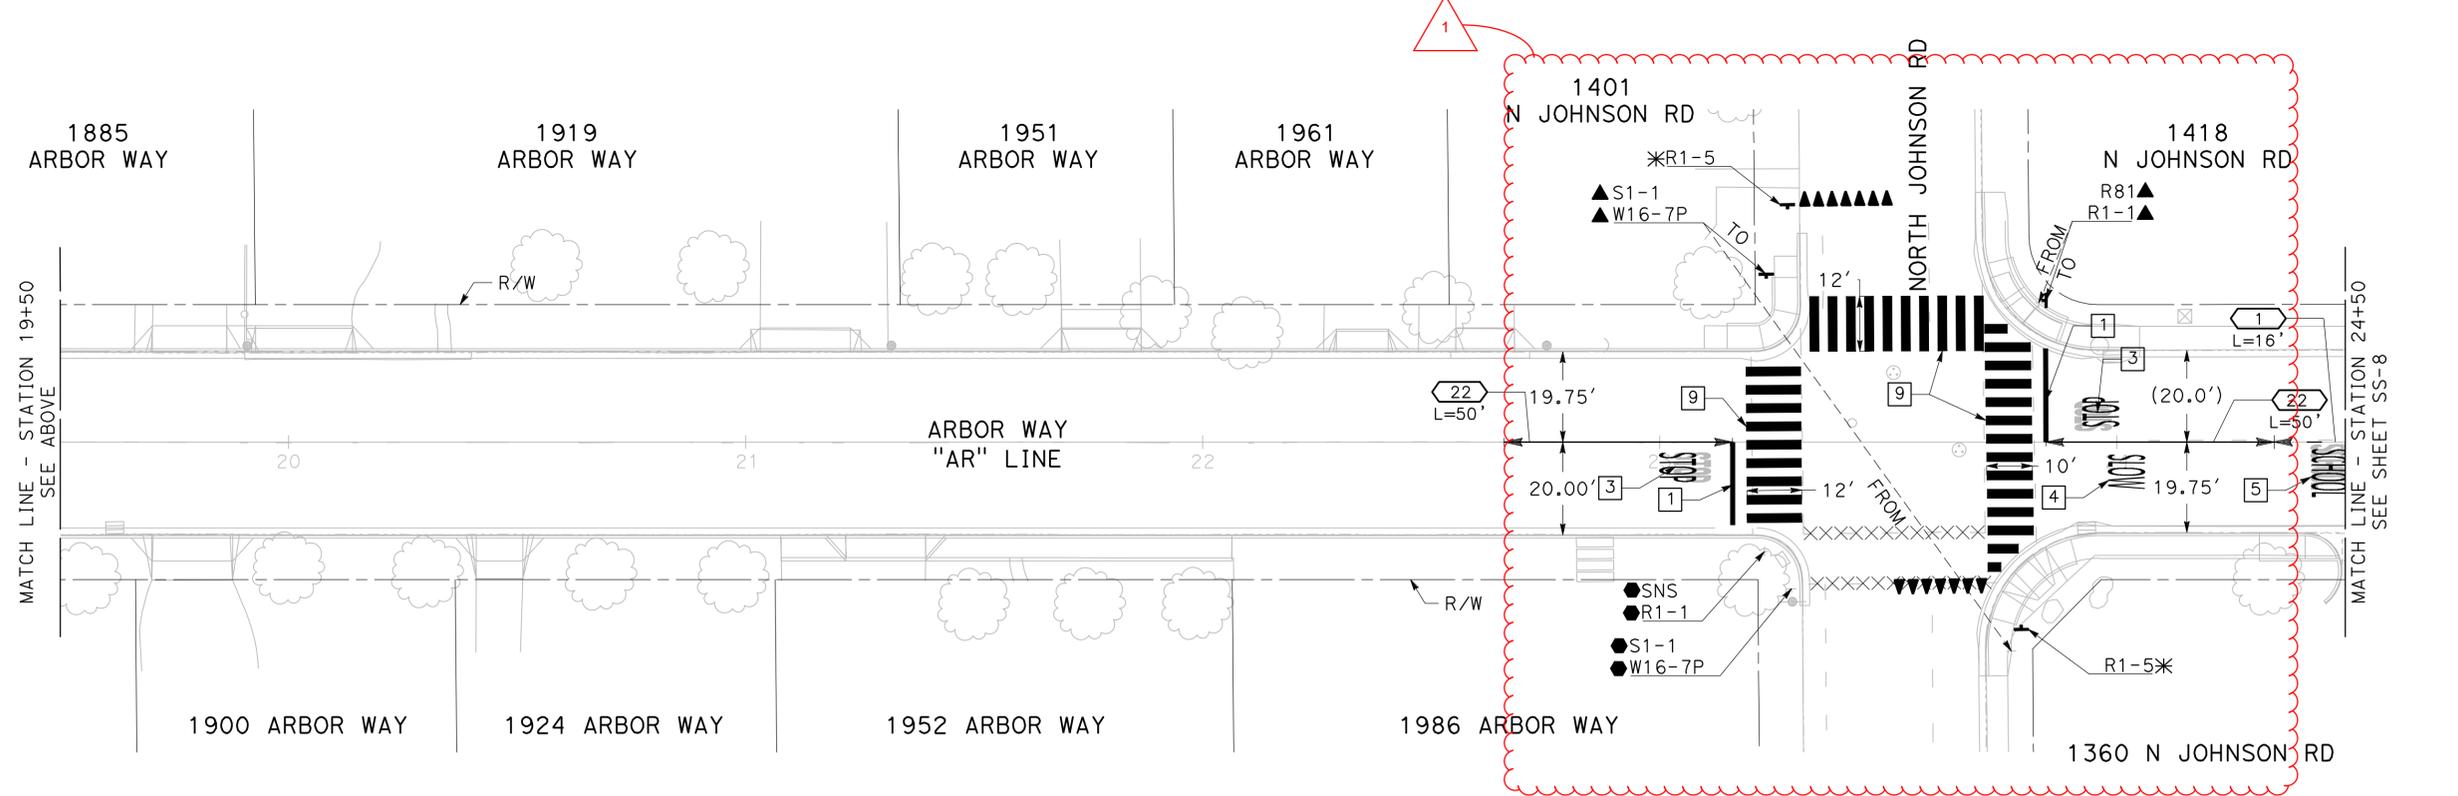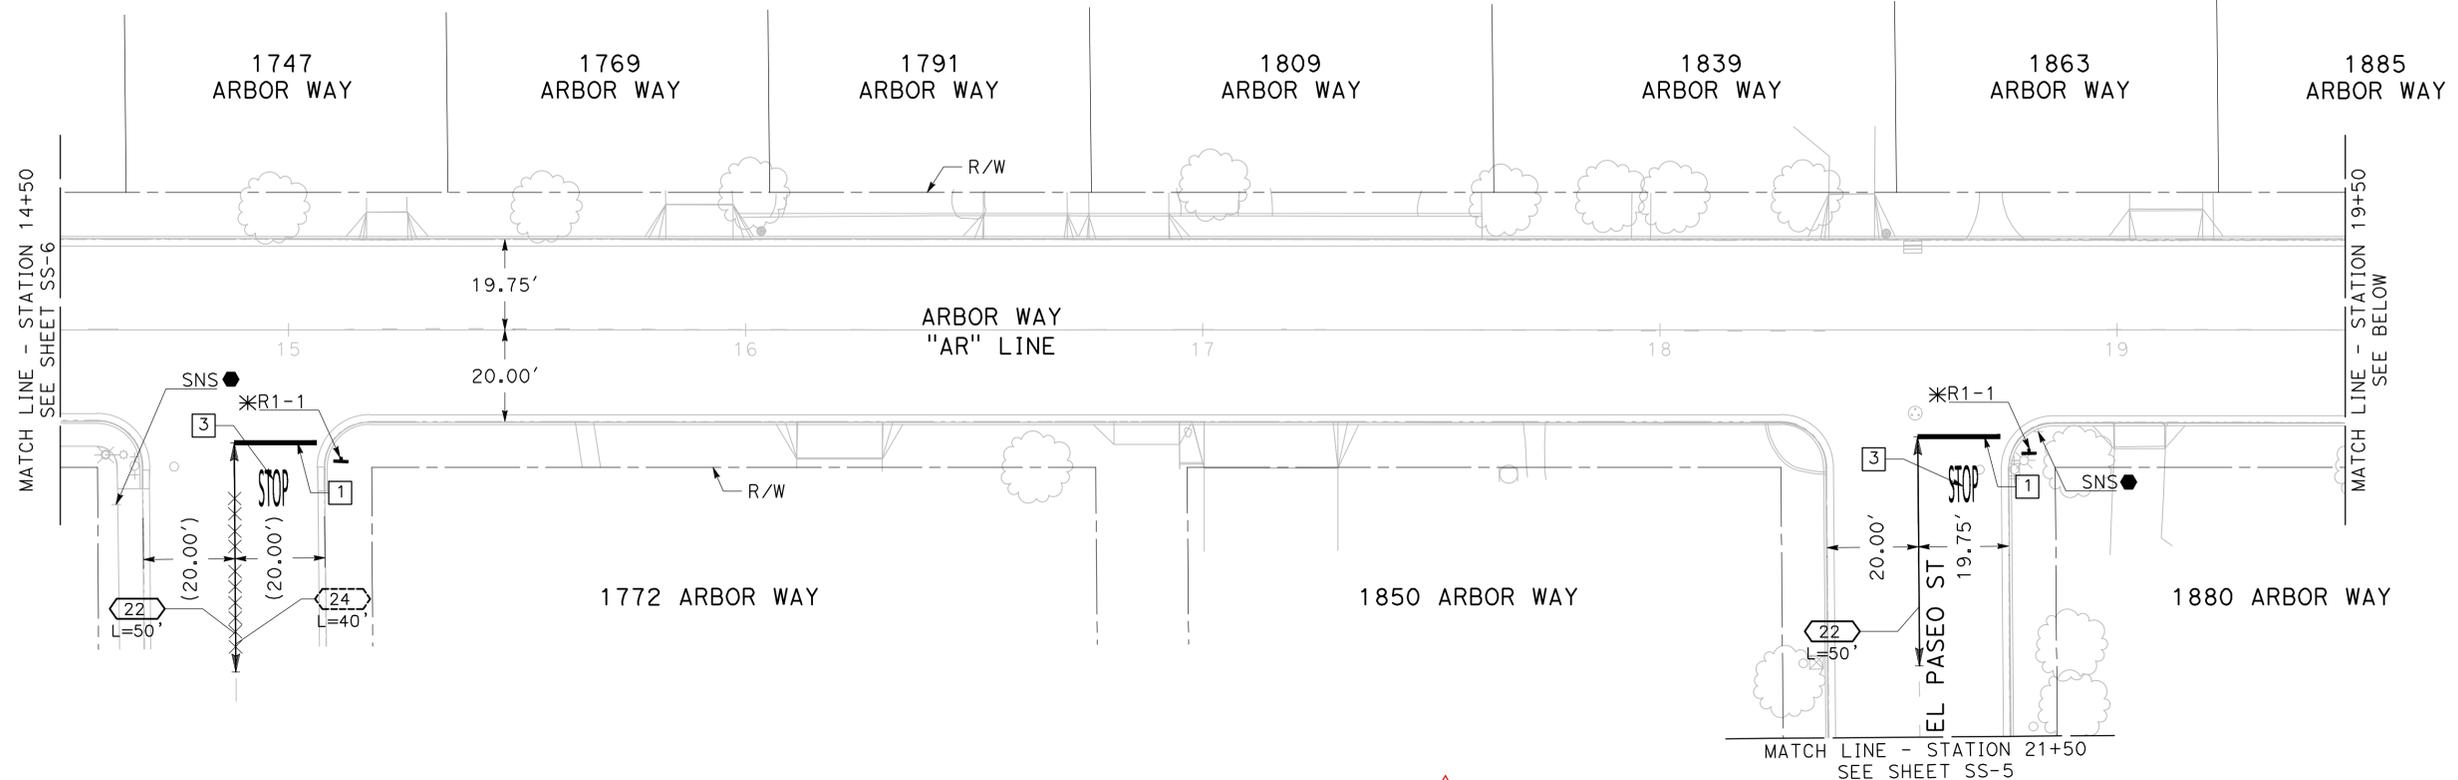

100% PLANS

DESIGNED BY: POORE, B.
 DRAWN BY: FRANCO, N.
 CHECKED BY: NORIEGA, E.
 SCALE: 1"=20'
 DATE: 5/22/2025
 JOB NO.: 24-00061

NOTE:
 ALL REFERENCES AND WRITTEN DIMENSIONS SHALL SUPERCEDE ALL SCALED DISTANCES AND SHALL BE VERIFIED IN THE FIELD. ANY DISCREPANCY SHALL BE BROUGHT TO THE ATTENTION OF THE ENGINEER PRIOR TO THE COMMENCEMENT OF WORK.

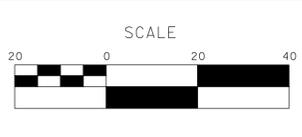



MARK THOMAS
 701 UNIVERSITY AVENUE, SUITE 200
 SACRAMENTO, CALIFORNIA 95825
 (916) 381-9100 FAX:(916)381-9180
 markthomas.com

CITY OF TURLOCK
 MUNICIPAL SERVICES
 DEPARTMENT
 156 S. BROADWAY
 SUITE 150
 (209) 668-5520



**CITY OF TURLOCK
 ROADS PROGRAM CIP
 PROJECT 23-067 PACKAGE #3
 SIGNAGE AND STRIPING**


Sheet **118**
 of
126 Sheets
SS-7

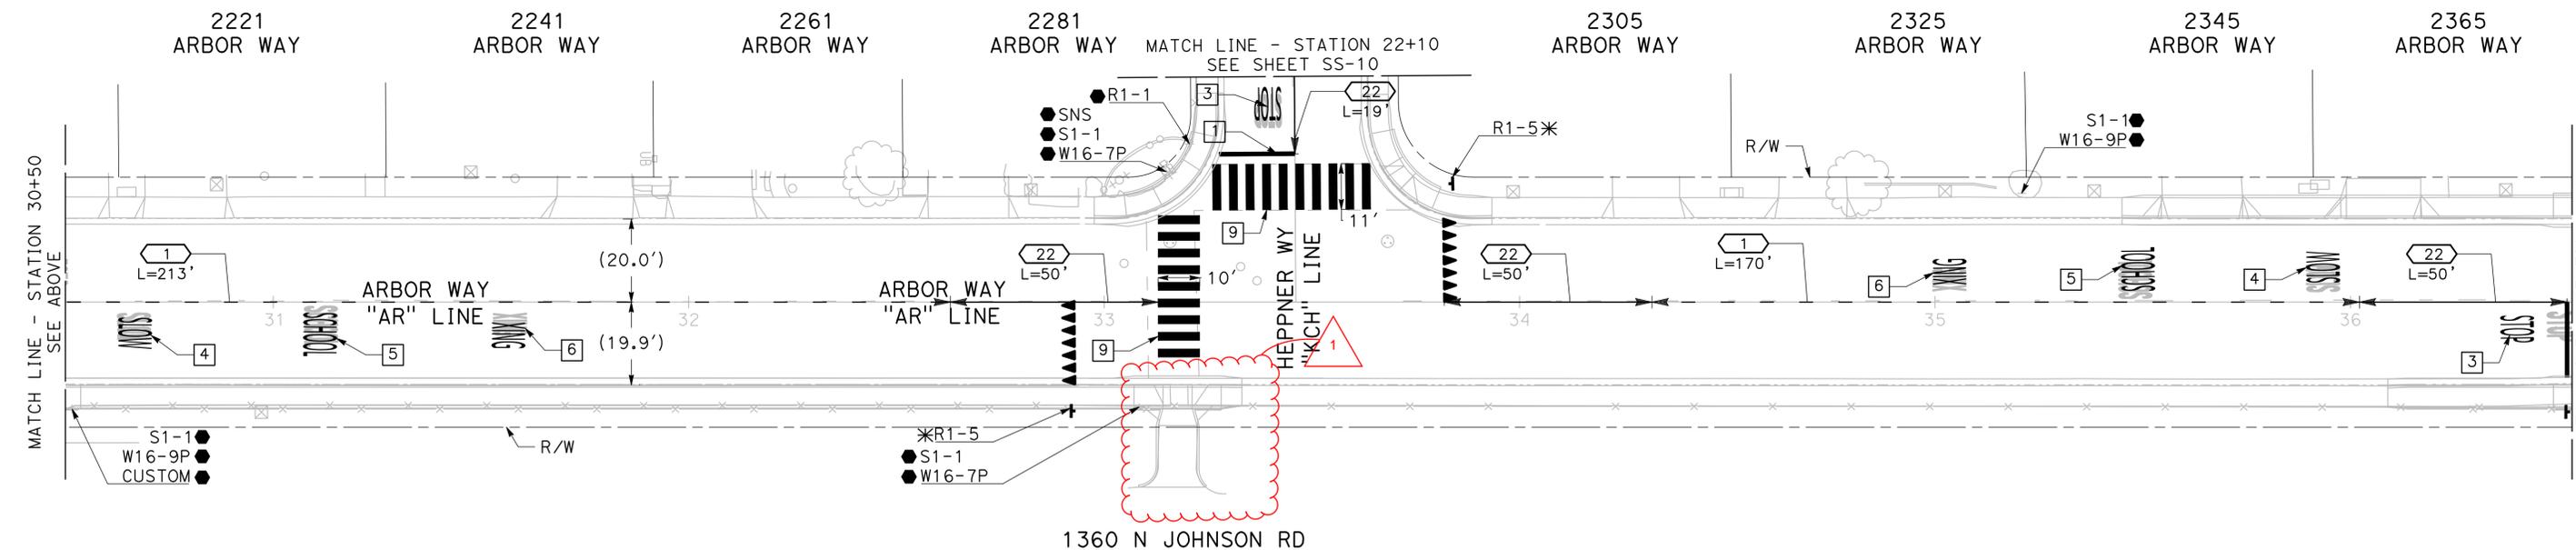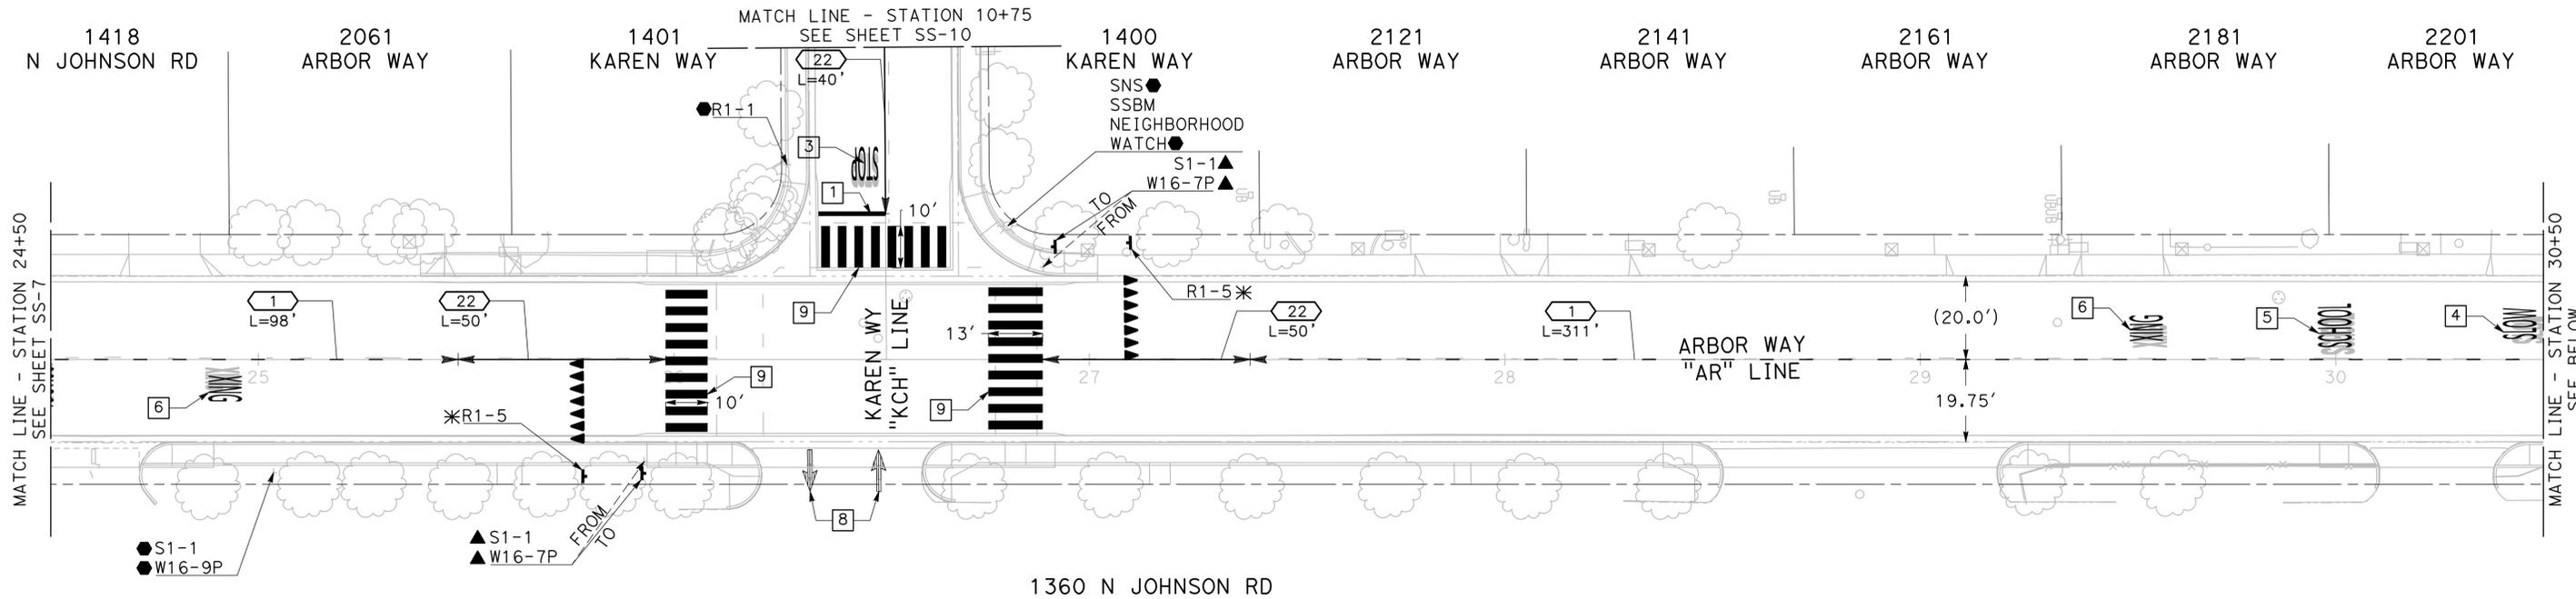

100% PLANS

DESIGNED BY: POORE, B.
 DRAWN BY: FRANCO, N.
 CHECKED BY: NORIEGA, E.
 SCALE: 1"=20'
 DATE: 5/21/2025
 JOB NO.: 24-00061

NOTE:
 ALL REFERENCES AND WRITTEN DIMENSIONS SHALL SUPERCEDE ALL SCALED DISTANCES AND SHALL BE VERIFIED IN THE FIELD. ANY DISCREPANCY SHALL BE BROUGHT TO THE ATTENTION OF THE ENGINEER PRIOR TO THE COMMENCEMENT OF WORK.

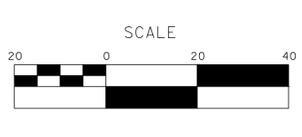


MARK THOMAS
 701 UNIVERSITY AVENUE, SUITE 200
 SACRAMENTO, CALIFORNIA 95825
 (916) 381-9100 FAX:(916)381-9180
 markthomas.com

CITY OF TURLOCK
 MUNICIPAL SERVICES DEPARTMENT
 156 S. BROADWAY
 SUITE 150
 (209) 668-5520



**CITY OF TURLOCK
 ROADS PROGRAM CIP
 PROJECT 23-067 PACKAGE #3
 SIGNAGE AND STRIPING**


Sheet **119**
 of **126** Sheets
SS - 8

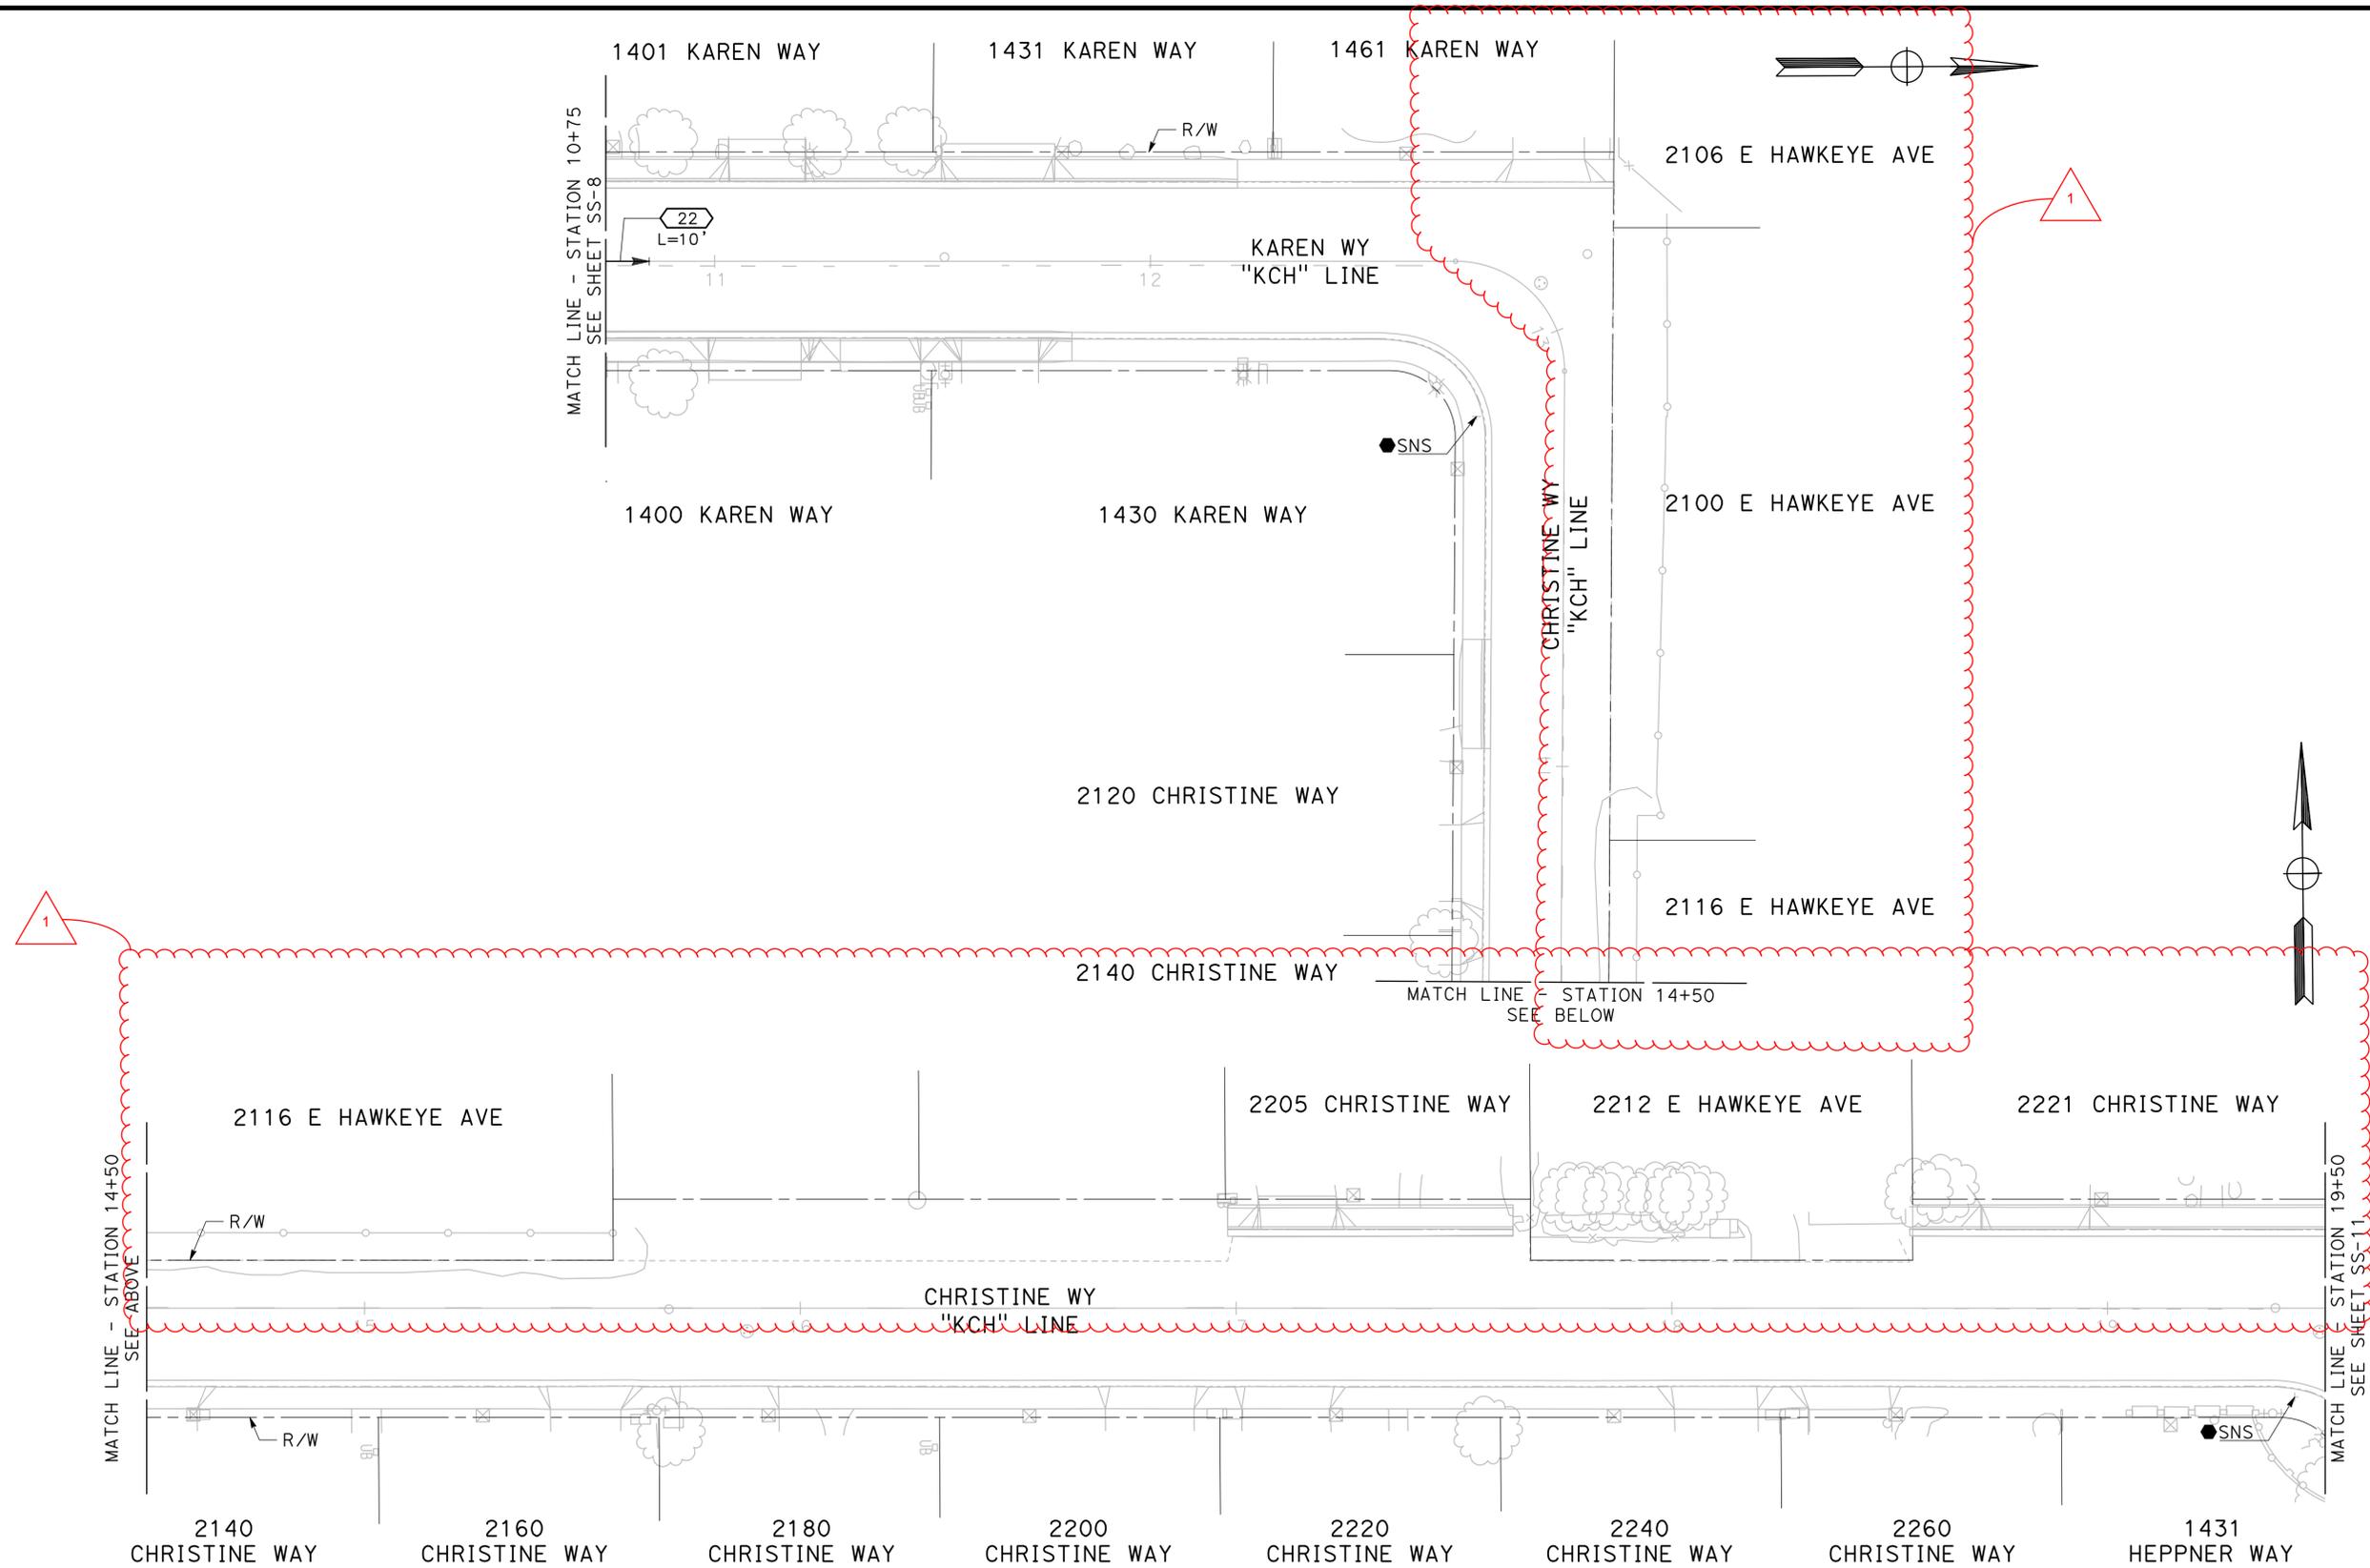

100% PLANS

DESIGNED BY: POORE, B.
 DRAWN BY: FRANCO, N.
 CHECKED BY: NORIEGA, E.
 SCALE: 1"=20'
 DATE: 5/21/2025
 JOB NO.: 24-00061

NOTE:
 ALL REFERENCES AND WRITTEN DIMENSIONS SHALL SUPERCEDE ALL SCALED DISTANCES AND SHALL BE VERIFIED IN THE FIELD. ANY DISCREPANCY SHALL BE BROUGHT TO THE ATTENTION OF THE ENGINEER PRIOR TO THE COMMENCEMENT OF WORK.

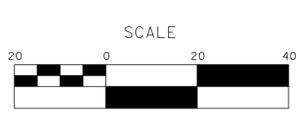


MARK THOMAS
 701 UNIVERSITY AVENUE, SUITE 200
 SACRAMENTO, CALIFORNIA 95825
 (916) 381-9100 FAX:(916)381-9180
 markthomas.com

CITY OF TURLOCK
 MUNICIPAL SERVICES DEPARTMENT
 156 S. BROADWAY
 SUITE 150
 (209)668-5520



CITY OF TURLOCK
ROADS PROGRAM CIP
PROJECT 23-067 PACKAGE #3
SIGNAGE AND STRIPING



Sheet **121**
 of
 126 Sheets
SS-10

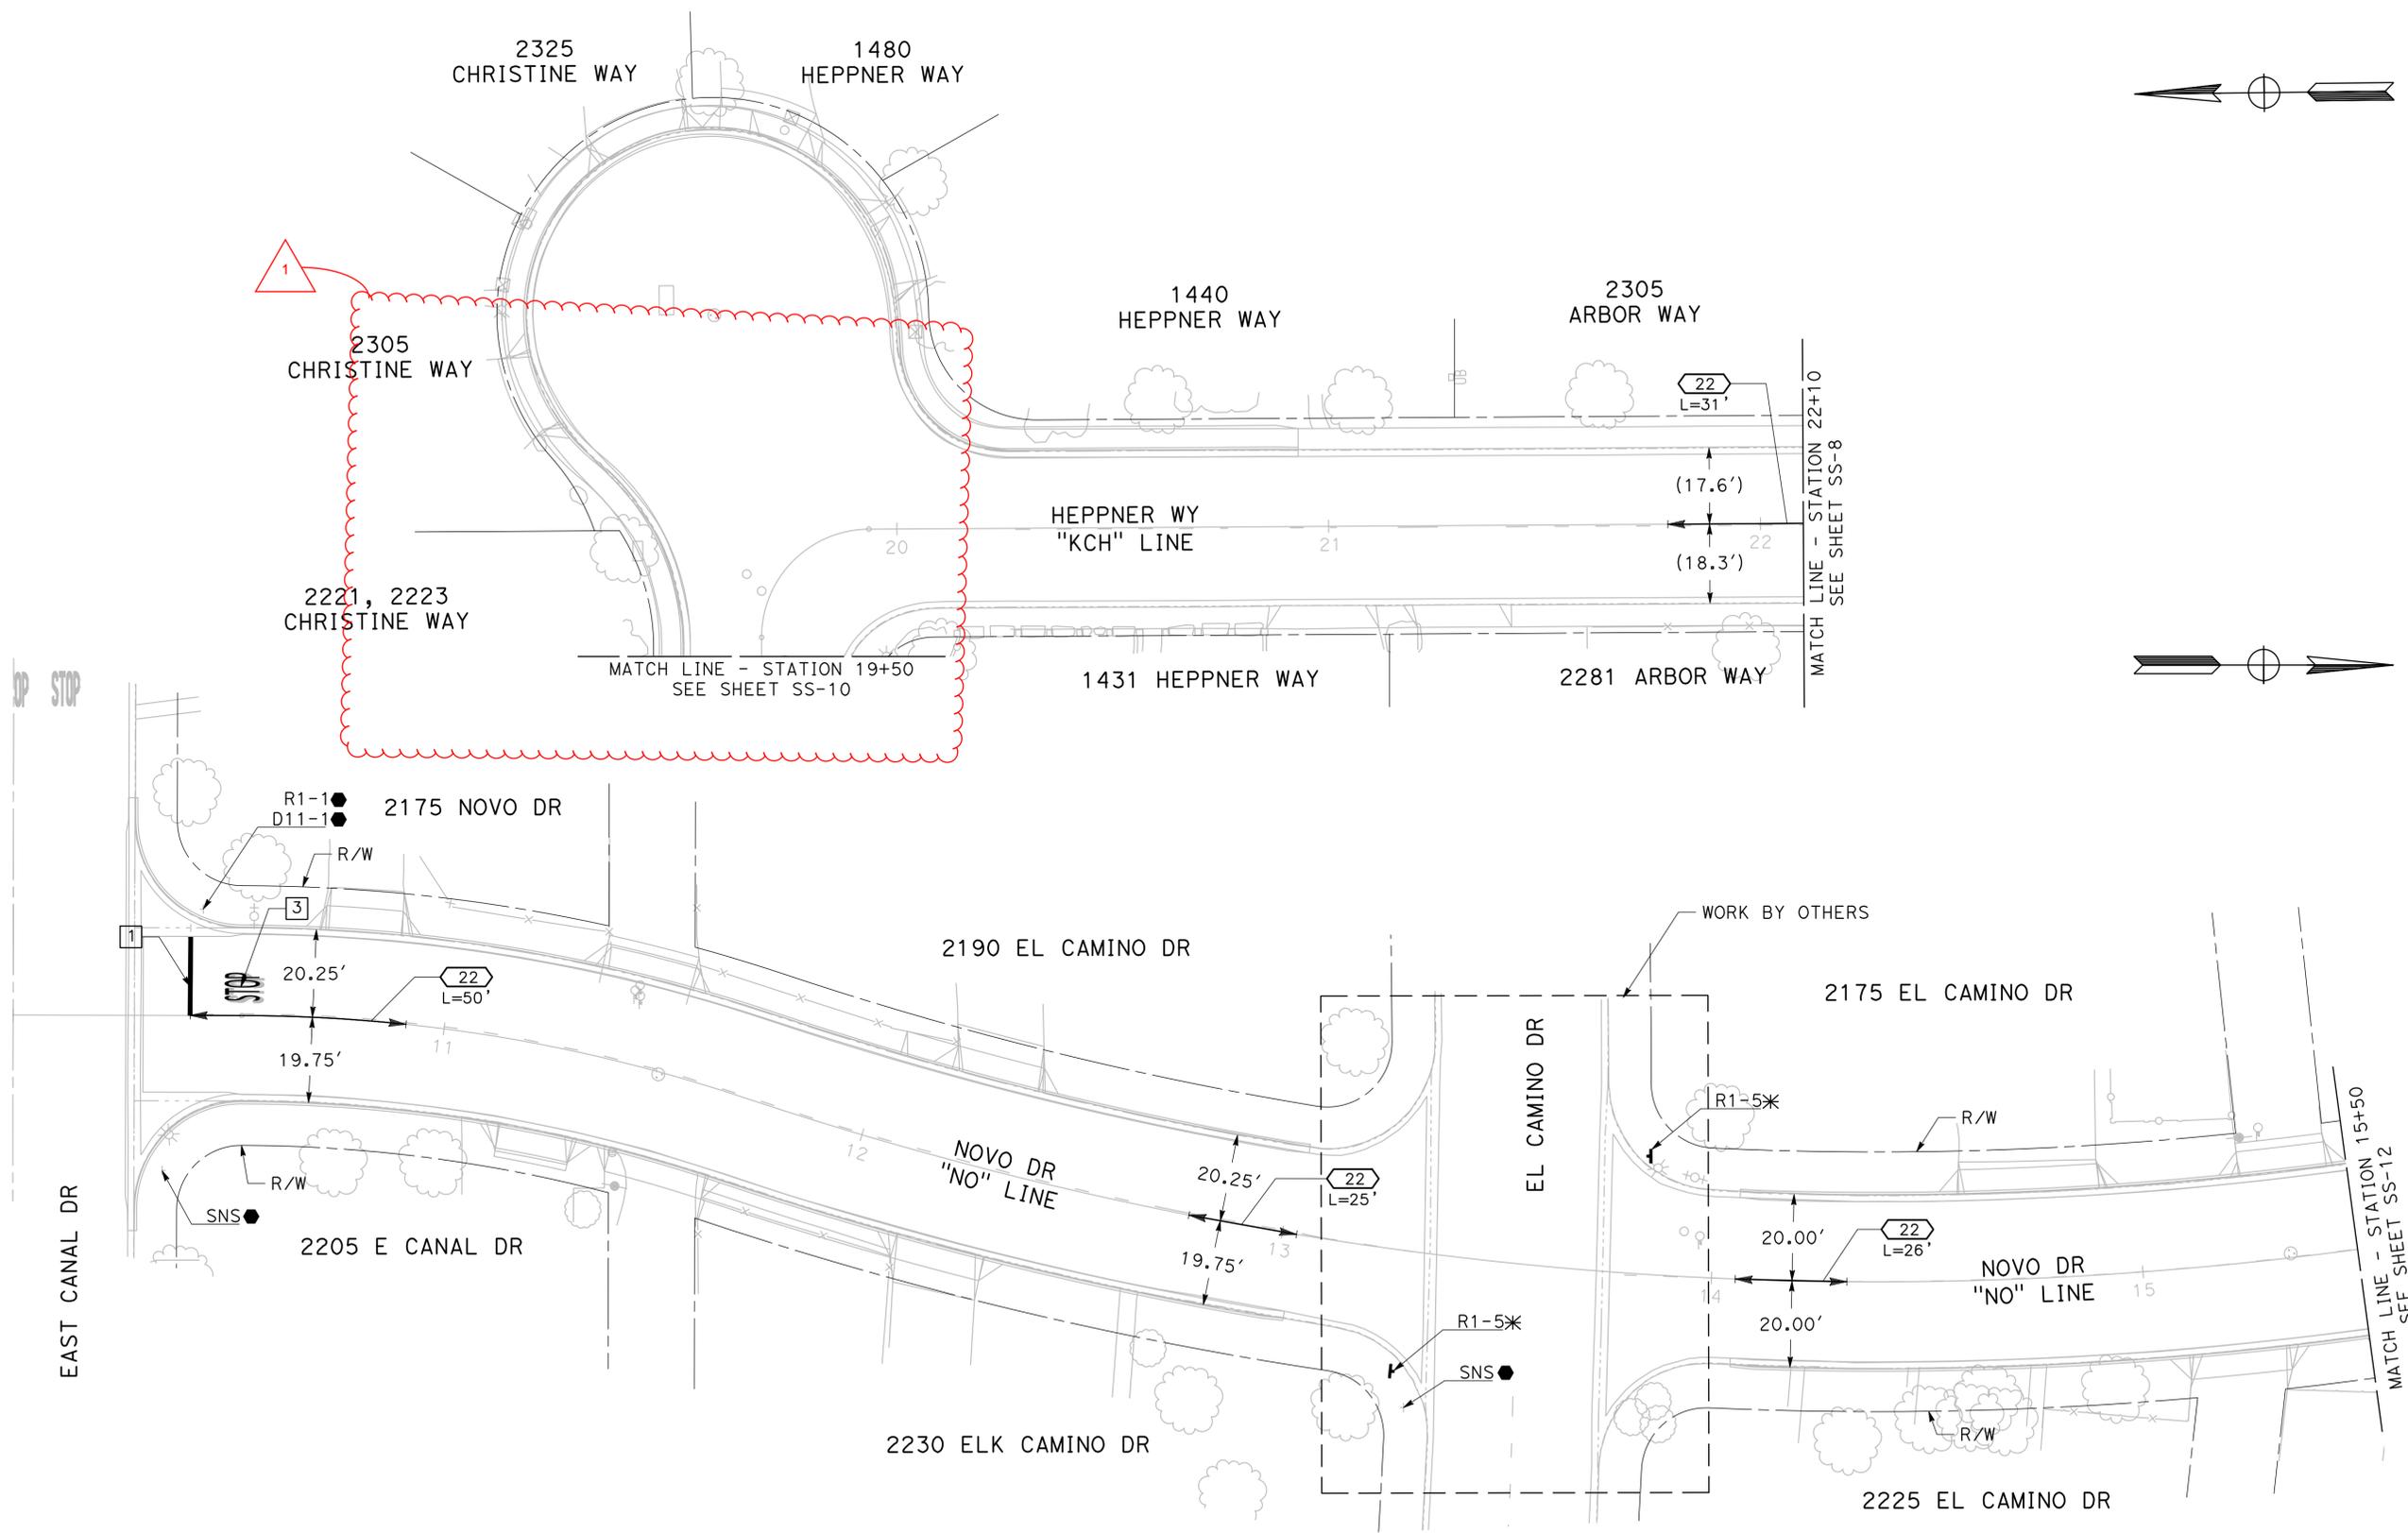

100% PLANS

DESIGNED BY: POORE, B.
 DRAWN BY: FRANCO, N.
 CHECKED BY: NORIEGA, E.
 SCALE: 1"=20'
 DATE: 5/21/2025
 JOB NO.: 24-00061

NOTE:
 ALL REFERENCES AND WRITTEN DIMENSIONS SHALL SUPERCEDE ALL SCALED DISTANCES AND SHALL BE VERIFIED IN THE FIELD. ANY DISCREPANCY SHALL BE BROUGHT TO THE ATTENTION OF THE ENGINEER PRIOR TO THE COMMENCEMENT OF WORK.

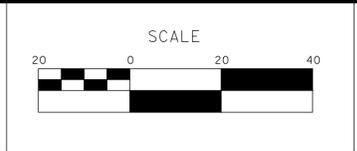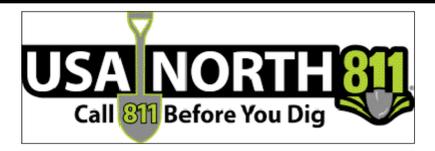




MARK THOMAS
 701 UNIVERSITY AVENUE, SUITE 200
 SACRAMENTO, CALIFORNIA 95825
 (916) 381-9100 FAX:(916)381-9180
 markthomas.com

CITY OF TURLOCK
 MUNICIPAL SERVICES DEPARTMENT
 156 S. BROADWAY
 SUITE 150
 (209) 668-5520



CITY OF TURLOCK
ROADS PROGRAM CIP
PROJECT 23-067 PACKAGE #3
SIGNAGE AND STRIPING


Sheet **122**
 of
 126 Sheets
SS-11

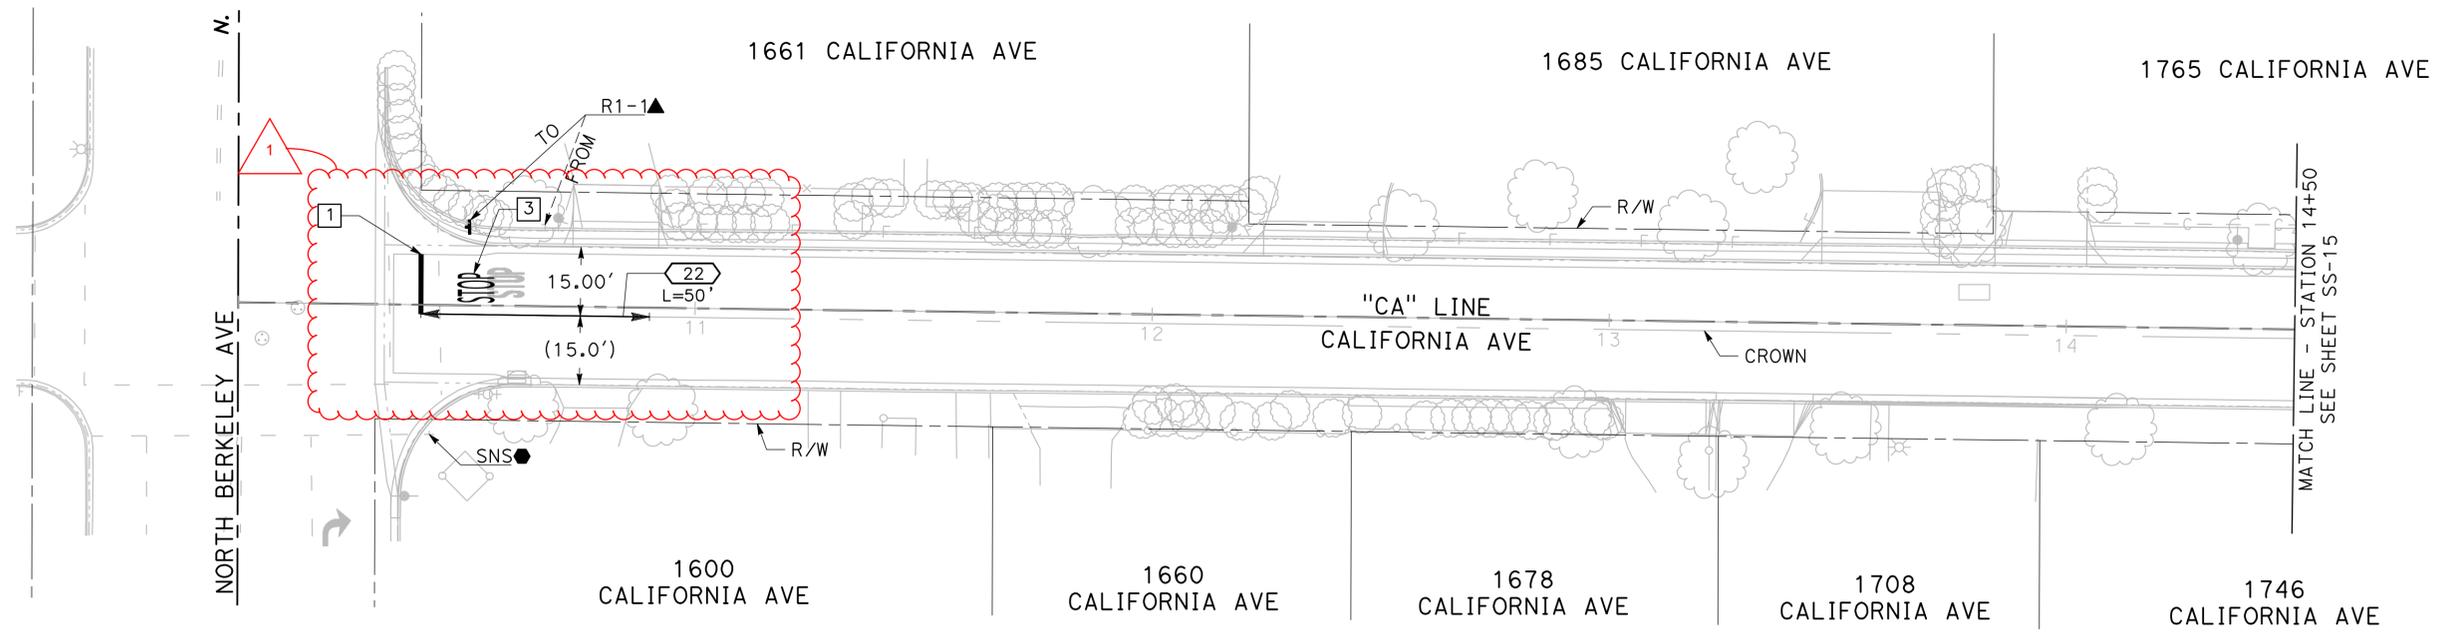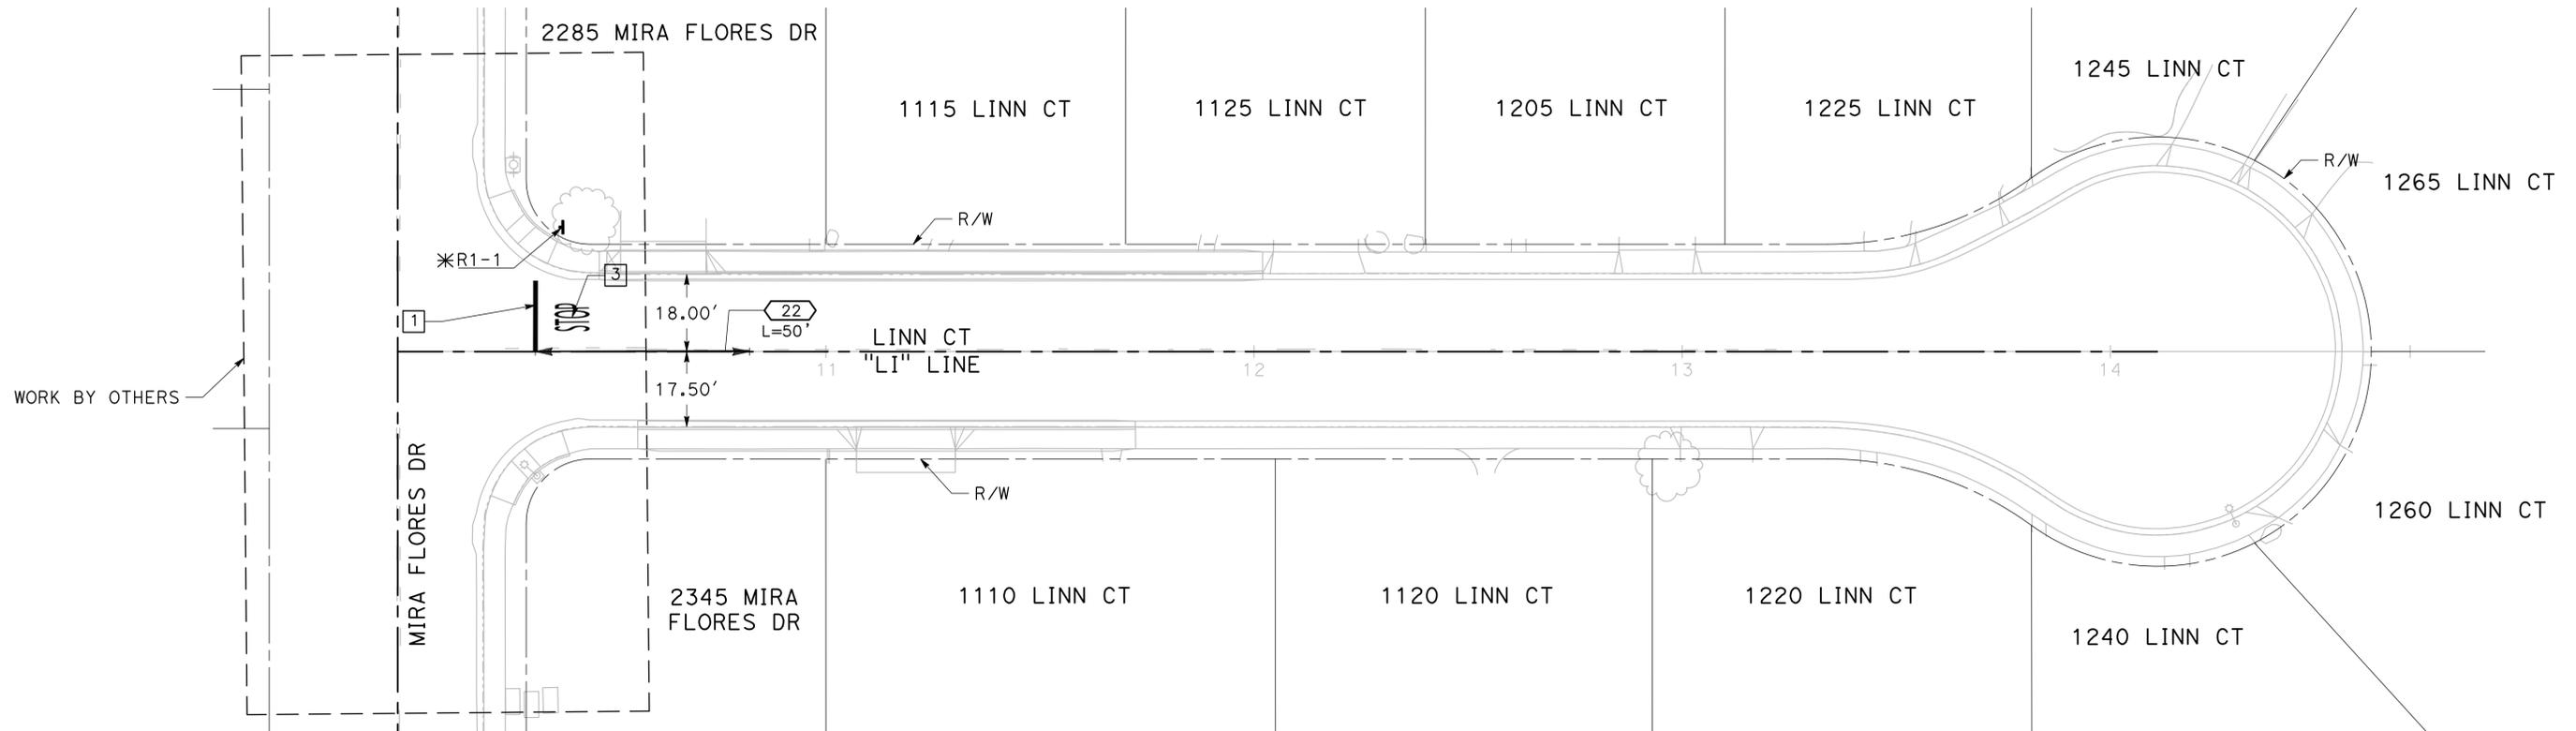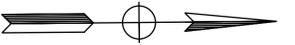

100% PLANS

DESIGNED BY: POORE, B.
 DRAWN BY: FRANCO, N.
 CHECKED BY: NORIEGA, E.
 SCALE: 1"=20'
 DATE: 5/21/2025
 JOB NO.: 24-00061

NOTE:
 ALL REFERENCES AND WRITTEN DIMENSIONS SHALL SUPERCEDE ALL SCALED DISTANCES AND SHALL BE VERIFIED IN THE FIELD. ANY DISCREPANCY SHALL BE BROUGHT TO THE ATTENTION OF THE ENGINEER PRIOR TO THE COMMENCEMENT OF WORK.

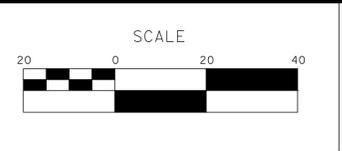

MARK THOMAS
 701 UNIVERSITY AVENUE, SUITE 200
 SACRAMENTO, CALIFORNIA 95825
 (916) 381-9100 FAX:(916)381-9180
 markthomas.com

CITY OF TURLOCK
 MUNICIPAL SERVICES DEPARTMENT
 156 S. BROADWAY
 SUITE 150
 (209) 668-5520



CITY OF TURLOCK
ROADS PROGRAM CIP
PROJECT 23-067 PACKAGE #3
SIGNAGE AND STRIPING

Sheet **125**
 of
 126 Sheets
SS-14

TABLE OF CONTENTS

Contents

NOTICE TO CONTRACTORS.....	1
PROPOSAL 5	
PROPOSAL SUBMITTAL CHECKLIST.....	6
BIDDING FORM.....	7
INFORMATION REQUIRED OF BIDDER.....	14
BIDDER’S BOND.....	16
SUB-CONTRACTORS.....	18
IRAN CONTRACTING ACT CERTIFICATION.....	20
AGREEMENT 21	
1. Contract Documents:.....	22
2. Term.....	22
3. Scope of Work.....	22
4. Contract Price.....	23
5. Time for Performance.....	24
6. Termination.....	27
7. Liability for Breach:.....	27
8. Compensation:.....	28
9. Disputes Pertaining to Payment for Work:.....	29
10. Permits and Care of Work:.....	29
12. Superintendence by Contractor:.....	30
13. Inspection and Testing by City:.....	30
14. Conformity with Law and Safety:.....	31
15. Other Contracts:.....	31
16. Bonds:.....	31
17. Indemnification:.....	32
18. Contractor's Insurance:.....	32
20. Taxes:.....	35
21. Independent Contractor:.....	36
22. Contractor Not Agent:.....	36
23. Arbitration of Disputes:.....	36
24. Provisions Cumulative:.....	37
25. Notices:.....	37
26. City Contract Administrator:.....	38
27. Interpretation:.....	38
28. Antitrust Claims:.....	38

29.	Use of City Project Number:	38
30.	No Conflict of Interest:	38
31.	Confidentiality:	38
32.	Modification:	39
33.	Waiver:	39
34.	Assignment:	39
35.	Authority:	39
36.	Governing Law:	39
37.	Severability:	39
38.	Execution and Counterparts:	40
39.	Mandatory and Permissive:	40
40.	Headings:	40
41.	Attorney’s Fees and Costs:	40
42.	Necessary Acts and Further Assurances:	40
43.	Recitals:	40
	SCOPE OF SERVICES	42
	PAYMENT BY FORCE ACCOUNT	43
	WORKERS’ COMPENSATION INSURANCE CERTIFICATION	48
	PERFORMANCE BOND	49
	PAYMENT BOND	51
	SPECIAL PROVISIONS	54
	SECTION 1 SPECIFICATIONS AND PLANS	54
	1.01 SPECIFICATIONS:	54
	1.02 CONTRACTOR’S RESPONSIBILITY:	55
	1.03 COMPLETENESS AND ACCURACY OF PLANS AND SPECIFICATIONS:	55
	SECTION 2 PROPOSAL REQUIREMENTS AND CONDITIONS	56
	2.01 GENERAL:	56
	2.02 EXISTING UTILITIES, FACILITIES, AND SITE CONDITIONS:	56
	2.03 [NOT USED]:	57
	2.04 [NOT USED]:	57
	2.05 ESCROW BID DOCUMENTS:	57
	SECTION 3 AWARD AND EXECUTION OF CONTRACT	61
	3.01 GENERAL:	61
	SECTION 4 BEGINNING OF WORK, TIME OF COMPLETION AND DELAY DAMAGES	62
	SECTION 5 GENERAL	63
	5.01 LABOR NONDISCRIMINATION:	63
	5.02 PREVAILING WAGE:	63
	5.03 DIFFERING SITE CONDITIONS:	63
	5.04 REMOVAL OF ASBESTOS AND HAZARDOUS SUBSTANCES:	64
	5.05 SIGNIFICANT CHANGES IN THE CHARACTER OF WORK	65
	5.06 UNAVOIDABLE DELAYS	65

5.07	SUBCONTRACTING:	65
5.08	PROMPT PROGRESS PAYMENT TO SUBCONTRACTORS:	66
5.09	PROMPT PAYMENT OF FUNDS WITHHELD TO SUBCONTRACTORS:	66
5.10	PAYMENTS:	67
5.11	[NOT USED]:	67
5.12	GUARANTY:	67
5.13	PUBLIC SAFETY:	67
5.14	SOUND CONTROL REQUIREMENTS:	68
5.15	WORKING HOURS:	69
5.16	UNDERGROUND SERVICE ALERT REQUIREMENTS:	69
5.17	DUST CONTROL:	69
5.18	WATERING:	70
5.19	USE OF HYDRANTS FOR CONSTRUCTION PURPOSES:	70
5.20	PROGRESS SCHEDULE:	70
5.21	PRESERVATION OF PROPERTY:	71
5.22	ORDER OF WORK:	73
5.23	AS-BUILTS:	75
5.24	SURVEYING:	75
5.25	TESTING:	76
5.26	SUBMITTALS:	77
5.27	NOTICE OF POTENTIAL CLAIM:	80
5.28	PRESERVATION OF EXISTING MONUMENTS:	80
5.29	INTERNET BASED CONSTRUCTION MANAGEMENT SYSTEM:	80
5.30	BUSINESS LICENSE:	84
5.31	TEMPORARY CONSTRUCTION POWER:	84
5.32	SALVAGE MATERIALS:	84
5.33	PERMITS:	84
5.34	UTILITY COORDINATION:	85
5.35	UTILITY VERIFICATION:	85
SECTION 6	CONTROL OF MATERIALS	89
SECTION 7	(BLANK)	91
SECTION 8	PROSECUTION AND PROGRESS	92
SECTION 9	DESCRIPTION OF WORK	94
SECTION 10	TECHNICAL SPECIAL PROVISIONS	95
10.01	POTHOLE EXISTING UTILITIES	96
10.02	CONSTRUCTION AREA SIGNS	96
10.03	TRAFFIC CONTROL SYSTEM	97
10.04	PORTABLE CHANGEABLE MESSAGE SIGN	98
10.05	CONSTRUCTION FUNDING SIGNS	98
10.06	JOB SITE MANAGEMENT	99
10.07	STORM WATER POLLUTION PREVENTION PLAN (SWPPP)	100
10.08	CONSTRUCTION STAKING	101
10.09	REMOVE EXISTING IMPROVEMENTS	102

10.10 REMOVE CONCRETE CURBS	105
10.11 REMOVE CONCRETE (FLATWORK)	106
10.12 REMOVE ASPHALT CONCRETE PAVEMENT	106
10.13 REMOVE BARRIER	107
10.14 COLD PLANING AC PAVEMENT	107
10.15 SAWCUTTING	109
10.16 EARTHWORK.....	109
10.16A UNSUITABLE MATERIAL	110
10.17 HOT MIX ASPHALT (Type A).....	111
10.18 FULL DEPTH RECLAMATION - CEMENT	114
10.19 AGGREGATE BASE CLASS 2.....	116
10.20 MINOR CONCRETE	117
10.21 EXCAVATE AND EXPOSE	119
10.22 SLURRY CEMENT (2-SACK)	119
10.23 DETECTABLE WARNING SURFACE	120
10.24 ADJUST DRAINAGE INLET TO GRADE	120
10.25 REPLACE DRAINAGE INLET (SD-3).....	121
10.26 INSTALL DRAINAGE INLET (SD-3).....	121
10.27 12” REINFORCED CONCRETE PIPE	122
10.28 RELOCATE FIRE HYDRANT	123
10.29 REMOVE AND REPLACE MONUMENT	123
10.30 ADJUST FRAMES AND COVERS TO GRADE	123
10.31 CHAIN LINK FENCE (CL-4).....	124
10.32 4’ CHAIN LINK GATE (CL-4).....	124
10.33 REMOVE FENCE	125
10.34 INSTALL ROADSIDE SIGN – ONE POST	125
10.35 RELOCATE ROADSIDE SIGN	126
10.36 THERMOPLASTIC STRIPING AND MARKINGS.....	126
10.37 REMOVE THERMOPLASTIC TRAFFIC STRIPE	126
10.38 REMOVE THERMOPLASTIC PAVEMENT MARKING.....	127
10.39 VIDEO SEWER AND STORM DRAIN INSPECTION	127
10.40 MOBILIZATION & DEMOBILIZATION	128
SECTION 11 (BLANK)	130
SECTION 12 (BLANK)	131
SECTION 13 (BLANK)	132
SECTION 14 (BLANK)	133
APPENDIX A: PAVEMENT DESIGN REPORT	134
APPENDIX B: PROJECT VICINITY MAPS FOR COORDINATION	180
APPENDIX C: QUALITY ASSURANCE PLAN	181

CITY OF TURLOCK

Project No. 23-067 Package #3

BID SCHEDULE

Item	Description	Quantity	Unit	Unit Price	Total
Roadway Items					
1.	Potholes Existing Utilities	1	LS	\$ _____	\$ _____
2.	Construction Area Signs	1	EA	\$ _____	\$ _____
3.	Traffic Control System	1	LS	\$ _____	\$ _____
4.	Portable Changeable Message Sign	8	EA	\$ _____	\$ _____
5.	Construction Funding Sign	12	EA	\$ _____	\$ _____
6.	Job Site Management	1	LS	\$ _____	\$ _____
7.	Prepare Storm Water Pollution Prevention Plan	1	LS	\$ _____	\$ _____
8.	Erosion and Dust Control BMPs	1	LS	\$ _____	\$ _____
9.	Construction Staking	1	LS	\$ _____	\$ _____
10.	Clearing and Grubbing	1	LS	\$ _____	\$ _____
11.	Remove Concrete (Curb Ramps, Sidewalk, Valley Gutter, Driveways, Curb and Gutter)	8570	SY	\$ _____	\$ _____
12.	Roadway Excavation (<i>F</i>)	2800	CY	\$ _____	\$ _____
13.	Unsuitable Material	1250	CY	\$ _____	\$ _____
14.	Remove Asphalt Concrete Pavement	180	SF	\$ _____	\$ _____
15.	Cold Plane AC Pavement (Var Depth)	45200	SY	\$ _____	\$ _____
16.	Hot Mix Asphalt (Type A)	11600	TON	\$ _____	\$ _____
17.	Full Depth Reclamation-Cement	48800	SY	\$ _____	\$ _____

Item	Description	Quantity	Unit	Unit Price	Total
18.	Cement (Full Depth Reclamation-Cement)	1030	TON	\$ _____	\$ _____
19.	Mix Design (Full-Depth Reclamation-Cement)	1	LS	\$ _____	\$ _____
20.	Aggregate Base (Class 2)	120	CY	\$ _____	\$ _____
21.	Minor Concrete (Curb and Gutter)	17700	LF	\$ _____	\$ _____
22.	Minor Concrete (Retaining Curb)	87	LF	\$ _____	\$ _____
23.	Minor Concrete (Curb Ramp)	3570	SF	\$ _____	\$ _____
24.	Minor Concrete (Sidewalk)	27100	SF	\$ _____	\$ _____
25.	Minor Concrete (Valley Gutter)	3590	SF	\$ _____	\$ _____
26.	Minor Concrete (Driveway)	24500	SF	\$ _____	\$ _____
27.	Excavate and Expose Utility	6450	LF	\$ _____	\$ _____
28.	Concrete Slurry (2-sack)	1000	LF	\$ _____	\$ _____
29.	Detectable Warning Surface (Truncated Domes)	650	SF	\$ _____	\$ _____
30.	Adjust Drainage Inlet to Grade	15	EA	\$ _____	\$ _____
31.	Replace Drainage Inlet (SD-3)	4	EA	\$ _____	\$ _____
32.	Install Drainage Inlet (SD-3)	1	EA	\$ _____	\$ _____
33.	12" Reinforced Concrete Pipe	54	LF	\$ _____	\$ _____
34.	Relocate Fire Hydrant	2	EA	\$ _____	\$ _____
35.	Remove and Replace Monument	6	EA	\$ _____	\$ _____
36.	Adjust Manhole Frame and Cover (Sewer)	21	EA	\$ _____	\$ _____
37.	Adjust Manhole Frame and Cover (Storm Drain)	1	EA	\$ _____	\$ _____
38.	Adjust Frame and Cover to Grade (Water Valve)	38	EA	\$ _____	\$ _____
39.	Adjust Frame and Cover to Grade (Water Meter)	1	EA	\$ _____	\$ _____

Item	Description	Quantity	Unit	Unit Price	Total
40.	Chain Link Fence (Type CL-4)	480	LF	\$ _____	\$ _____
41.	4' Chain Link Gate (Type CL-4)	1	EA	\$ _____	\$ _____
42.	Remove Fence	970	LF	\$ _____	\$ _____
43.	Install Roadside Sign – One Post	27	EA	\$ _____	\$ _____
44.	Relocate Roadside Sign	9	EA	\$ _____	\$ _____
45.	Thermoplastic Traffic Stripe	3360	LF	\$ _____	\$ _____
46.	Thermoplastic Pavement Markings	4630	SF	\$ _____	\$ _____
47.	Remove Thermoplastic Traffic Stripe	240	LF	\$ _____	\$ _____
48.	Remove Thermoplastic Pavement Marking	130	SF	\$ _____	\$ _____
49.	Video Sewer and Storm Drain Inspection	1	LS	\$ _____	\$ _____
Mobilization					
50.	Mobilization	1	LS	\$ _____	\$ _____
TOTAL BID					\$ _____

(F) Denotes Final Pay Item Per Section 9-1.02C of The State Standard Specifications.

If work in those areas affected by the right-of-entry agreements delays the current controlling operation by more than sixty (60) calendar days, the delay will be considered a right of way delay and the Contractor will be compensated for the delay in conformance with the provisions in Section 8 1.07, "Delays," of the State Standard Specifications. No additional compensation will be considered for a delay less than sixty (60) calendar days.

The City may cancel the portion of the work affected by the right-of-entry agreements. In the event of cancelation, the Contractor shall be compensated for all work executed upon a unit basis in proportion to the amount of the work completed, or upon a cost plus-ten-percent (10%) basis, whichever is the lesser. Materials on the ground, in process of fabrication or in route upon the date of notice of cancelation specially ordered for the Project and which cannot be utilized by Contractor, shall be compensated for by City at cost, including freight, provided Contractor shall take all steps possible to minimize this obligation.

The Contractor's attention is directed to Section 7-11 of the City Standard Specifications regarding cooperation between contractors. The Contractor shall coordinate with the Contractors of the projects listed below. See map and cover sheet for each project attached to these specifications in Appendix B.

- Project No. 23-031, Plan Package 2, Roads Program Capital Improvement Project
- Project No. 23-033, Roads Program Capital Improvement Project
- Project No. 23-040, Water Line Replacement for 2024 Roads Program Construction
- Project No. 23-067, Plan Packages 1 & 2, Roads Program Capital Improvement Project
- Project No. 23-068, Plan Packages 1, 2, & 3, Roads Program Capital Improvement Project
- Project No. 23-069, Roads Program Capital Improvement Project

The Contractor shall protect in place the improvements constructed from the projects listed below, which are currently under warranty with the Contractor of that project. The Contractor shall repair any damage caused to these improvements at no additional cost to the City.

- Project No. 22-001, Package 1, Citywide Street Rehabilitation and Improvement Project
- Project No. 20-002, Southwest Quadrant Road Rehabilitation Project
- Project No. 21-021, Pedras Road Rehabilitation Project
- Project No. 23-031, Plan Package 1, Roads Program Capital Improvement Project
- Project No. 23-031, Plan Package 2, Roads Program Capital Improvement Project
- Project No. 23-032, Roads Program Capital Improvement Project
- Project No. 23-033, Roads Program Capital Improvement Project

Contractor shall coordinate all work on E. Marshall Street, Wallace Street, ~~and Charles Place, and Johnson Road~~ with the Turlock Unified School District (TUSD). The sidewalk and fence removal along the west side of Wallace Street must be completed no later than July 25, 2025. All work along E. Marshall Street, Wallace Street, and Charles Place shall be completed prior to the start of the school year on August 12, 2025.

2. Construction area signs.
3. Implementation of SWPPP best management practices once the SWPPP has been accepted.

Submit a notification 72 hours before starting job site activities.

8.02 PROJECT MILESTONES

This section describes damages due to the City should the Contractor fail to meet certain project milestones. Attention is directed to Section 5 “Time of Performance” of the Agreement for liquidated damages for the Contractor’s failure to perform all work on this project by the Completion Date.

The Contractor shall perform all required earthwork, grading, and initial paving (first lift) no later than eight (8) calendar days after the date when existing asphalt concrete surfaces have been demolished by way of cold plane grinding from any given area. On road sections that require video inspections of the sewer and storm drain mains in accordance with Section 10.36, this time restriction may be extended to twelve (12) total calendar days. In the event the Contractor fails to complete the required work in the timeframe indicated, the City may deduct from payments or credits due Contractor a sum equal to \$500 for each and every calendar day delay in finishing the work.

During road closures, the work must progress continuously until the work is complete and the roadway is fully reopened to traffic.

disturbance of compacted backfill, and prevent flotation or movement of structures, pipelines and sewers. If an NPDES (National Pollutant Discharge Elimination System) permit is required for disposal of water from construction dewatering activities, it shall be obtained by the Contractor prior to any dewatering activities.

The contract lump sum price paid for job site management includes full compensation for furnishing all labor, materials, tools, equipment, and incidentals and for doing all the work involved in [discharging accumulated stormwater, groundwater, or surface water from excavations or temporary containment facilities as outlined in Section 13-4.03G of the Caltrans Standard Specifications](#); spill prevention and control; material management; waste management; and non-stormwater management, including identifying, sampling, testing, handling, and disposing of hazardous waste resulting from your activities, as specified in State Standard Specifications and these Special Provisions, and as ordered by the Engineer.

Full compensation for furnishing all labor, materials, tools, equipment, and incidentals, and for doing all the work involved in dewatering activities, shall be considered as included in the lump sum price paid for job site management and no additional compensation will be allowed therefore.

10.07 STORM WATER POLLUTION PREVENTION PLAN (SWPPP)

Prior to commencing construction, a Contractor shall submit to the Engineer a completed SWPPP signed and certified by a Qualified SSWPP Developer (QSD). Once approved, Contractor shall submit SWPPP and Notice of Intent (NOI) with the California Department of Water Quality Control Board. Contractor shall adhere to the SWPPP at all times. Contractor shall file the annual report when the project is completed.

All construction activities shall comply with the requirements of the “*State Water Resources Control Board Phase II Small MS4 General Permit Order No. 2013-0001-DWQ, NPDES General Permit No. CAS000004 for Storm Water Discharge Associated within Construction Activity*”.

Erosion and Dust Control BMPs

Contractor is responsible to furnish, install, maintain, and remove when not needed, appropriate and effective best management practices (BMPs) required by the Permit to reduce erosion and sediment transport and all potential pollutant sources.

Furnish, install, maintain, and remove temporary erosion and sediment control measures as required by the Permit.

Furnish, install, maintain, and remove temporary tracking control measures including street sweeping and dust control measures specified in Section 5.17, "Dust Control", of these Special Provisions. Maintain a clean and safe worksite at all times, including street sweeping. If the Contractor fails to maintain a clean worksite, the City may order street sweeping or corrective action at the Contractor's cost.

The Lump Sum amount for Prepare SWPPP and Erosion and Dust Control BMPs shall include, but not

10.15 SAWCUTTING

The Contractor shall sawcut or leave a neat edge on the existing pavement at the pavement removal limits specified on the approved Plans in a manner consistent with the applicable governing agency requirements and specifications.

Sawcutting shall be accomplished by the use of a power driven saw. The depth of cut shall be deep enough to produce a clean, straight break without loosening, cracking, or damaging adjoining asphalt or concrete. Waste material from sawcut operations shall be broom cleaned or vacuumed, and disposed of. Cleaning of sawcut area by washing and directing waste to public storm drains shall not be permitted.

The cost for Sawcutting shall be included in the various other bid items and no additional compensation will be made therefore.

10.16 EARTHWORK

Earthwork shall conform to the provisions in Section 19, "Earthwork", of State Standard Specifications and these Special Provisions.

Surplus excavated material shall become the property of Contractor and shall be disposed of outside the right-of-way and shall conform to the provisions in Section 7-10, "Disposal of Materials Outside the Right of Way", of City Standard Specifications.

Contractor shall not store any backfill, paving, or excavated material within the City right of way unless approved by Engineer.

~~When unsuitable materials are encountered, make reasonable efforts, as determined by the Engineer, to either dry out the soil or add moisture as needed to achieve proper compaction. Subgrade material that is pumping, or unstable due to oversaturation shall not be considered Unsuitable Material pursuant to this section. Prior to notifying the Engineer that you have encountered Unsuitable Material, you shall perform Quality Control Testing verifying that material is not exceeding its Optimum Moisture Content requiring additional drying out effort. The Quality Control Testing Results shall accompany the notification to the Engineer that you have encountered Unsuitable Material. In lieu of moisture conditioning the in-place soils, you may remove and replace soil at your expense.~~

All imported borrow shall be backfill material complying with Section 19-7 of State Standard Specifications. All backfill material shall be compacted at 95% relative compaction for the entire depth of imported material. The minimum compacted section shall be six inches and shall be composed of import borrow, existing material, or a combination of both. The contractor shall provide a submittal to the Engineer for review prior to importing or placing material.

Roadway excavation will be measured and paid by the cubic yard and the volume is determined from the average end areas and the distance between them. This item will be a final pay item. See section 9-1.02C of the State Standard Specifications.

The above price and payment for roadway excavation shall include full compensation for furnishing all labor, material, tools, equipment and incidentals, and for doing all the work involved in importing, excavating, hauling, compacting, and removing the surplus material, as shown on the plans, specified in State Standard Specifications and these Special Provisions, and as directed by Engineer.

10.16A UNSUITABLE MATERIAL

When Unsuitable Materials are encountered, make reasonable efforts, as determined by the Engineer, to either dry out the soil or add moisture as needed to achieve proper compaction.

“Unsuitable Materials” are defined as material encountered below the natural ground surface in embankment areas or below the grading plane in excavation areas that the Engineer determines to be in any of the following conditions:

1. Of such unstable nature that it cannot be compacted to the specified density using ordinary methods at optimum moisture content.
2. Too wet to be properly compacted and cannot be dried before incorporating it into the work.
3. Excessive moisture alone is not sufficient cause for determining that the material is unsuitable inappropriate for the planned use.

Contractor shall notify the Engineer before removing the Unsuitable Material if:

1. Removal is not otherwise described. You request separate payment for the removal and replacement under Item #13 - Unsuitable Material

Subgrade material that is pumping, or unstable due to oversaturation shall not be considered Unsuitable Material pursuant to this section. Prior to notifying the Engineer that you have encountered Unsuitable Material, you shall perform Quality Control Testing verifying that material is not exceeding its Optimum Moisture Content requiring additional drying out effort. The Quality Control Testing Results shall accompany the notification to the Engineer that you have encountered Unsuitable Material. In lieu of moisture conditioning the in-place soils, you may remove and replace soil at your expense.

Typical removal and replacement alternatives may consist of either Option 1 or 2:

1. Remove 6 inches of unsuitable material and replace with Class 2 Aggregate Base over a Tensar NX750 Geogrid. The surface of the AB should meet the requirements of Section 26 of the Caltrans Standard Specifications and be compacted to at least 95% relative compaction based on the ASTM D1557 method. The geogrid should be placed per the manufacturer’s recommended guidelines.
2. Remove 6 inches of unsuitable material and replace with compacted asphalt grindings over a Mirafi 160N filter fabric to provide a stabilized base prior to placing the deep lift asphalt. The filter fabric should be placed per the manufacturer’s recommended guidelines.

When Unsuitable Material is identified by the Contractor and confirmed by the Engineer, the above price and payment shall include full compensation for furnishing all labor, material, tools, equipment and incidentals, and for doing all the work involved in removal and placement alternative 1 or 2 as specified in these Special Provisions, and as directed by Engineer.

The contract price paid per cubic yard (CY) for Unsuitable Material shall include full compensation for furnishing all labor, materials, tools, equipment, and incidentals and for performing all work involved in Unsuitable Material as specified in these Special Provisions and as directed by the Engineer. This includes, but is not limited to, removing and disposing of the Unsuitable Material and furnishing, placing, and compacting the replacement material.

10.17 HOT MIX ASPHALT (Type A)

Preconstruction Meetings

Hold a preconstruction meeting with the Engineer per section 36-1.01D(2) of the State Standard Specifications. Discuss project specifications and the processes for producing materials and quality control measures for pavement smoothness including visual inspection of finished HMA surface.

Prepare Existing Surface

Contractor shall prep the existing surface prior to placing HMA. Prepping the surface shall consist of sweeping and vacuuming the entire area to remove debris, organic matter, dirt, etc. Any work that will be required to fill potholes or make the surface suitable for paving shall be paid as extra work, through force account.

For full-depth asphalt pavement sections, the underlying subgrade or subbase shall be compacted to at least 95 percent of the maximum dry density (per ASTM D1557) prior to AC paving. Where existing base to remain, Contractor shall compact and prepare per the Aggregate Base requirements in these Special Provisions prior to AC paving.

Prior to any removal of existing asphalt concrete or cold planing, verify all existing ground lines. If you contest the existing ground lines shown in the plans, you must submit your survey information. The Engineer will then have 10 working days to review the submittal. If you begin any removal or cold planing prior to the approval of this submittal, the existing ground lines shown in the plans will be deemed accurate and will be used for calculating quantities of removal or cold planing.

Full compensation for furnishing all labor, materials, tools, equipment, and incidentals, and for doing all of the work involved with preparing the existing surface as specified above, shall be considered as included in the price paid for hot mix asphalt (Type A) and no additional compensation will be allowed therefor.

Materials

Hot Mix Asphalt (HMA) shall conform to the provisions in Section 39-2, "Hot Mix Asphalt," of State Standard Specifications.

Notify the Engineer of the start location by station and start time at least 2 business days before each day of smoothness measurements. The Engineer must be present for smoothness measurements.

Payment

HMA will be subject to payment adjustments for Price Index Fluctuations per Section 9-1.07 of State Standards Specifications. The contract price paid per ton of HMA (Type A) shall include full compensation for furnishing all labor, materials, tools, equipment and incidentals, and for doing all the work involved in placing, compacting, and quality-control of hot mix asphalt including surface preparation, tack coat placement, and pavement smoothness, as shown on the plans, as specified in State Standard Specifications and these Special Provisions, and as directed by the Engineer. This item includes full depth AC Patch adjacent to proposed curbs and gutters, curb ramps and other hardscape construction.

10.18 FULL DEPTH RECLAMATION - CEMENT

Full depth reclamation - cement shall comply with Section 30, "Recycled Pavement" and Section 30-4, "Full Depth Recycling - Cement," of State Standard Specifications.

Work shall consist of pulverizing existing asphalt concrete, base, and subgrade soil following cold planing of existing asphalt concrete. Re-grade based on PG grades on plans and haul away excess material to allow for the net placement of new asphalt concrete. Add cement and water to the blended material in accordance with these and State Standard Specifications. Compact, fine grade to the grades required, cure and micro-crack the completed cement treated surface, prior to placement of asphalt concrete. Micro-cracking of the cement treated surface must be completed 48 to 56 hours after placement.

The Contractor shall be aware of existing utilities within the project limits that have not been potholed and may be within 24" vertical clearance of the FDR operation. The depth of existing utilities, where identified by Subsurface Utility Engineering/ Ground Penetrating Radar, has been provided on the plans. It is the Contractor's responsibility to pothole existing utilities, as described elsewhere in the specifications, and provide a report on the depth of the existing facilities to the Engineer. If the existing facility is determined to be within the 24" of the FDR operation, the Engineer may elect to proceed with the work based on the following options to avoid relocating the utility:

- -Top of utility is less than 24" below bottom of the FDR section - Contractor shall Excavate and Expose Utility to the top half of the existing utility using hand or other methods as approved by the utility owner. Excavated material will be set adjacent to the trench for inclusion in the FDR mixing operation or disposed of by the Contractor. Contractor to use appropriate means and methods during mixing and compaction of the FDR-C to avoid damaging underground utilities. A bid item has been provided for the work necessary to Excavate and Expose Utility.
- ~~Top of utility is 24" to 6" below bottom of the FDR section - Contractor shall excavate above the utility to the minimum allowable FDR depth using hand or other methods as approved by the Engineer to remove existing roadway base and subgrade to a maximum of 6" above the existing utility to remain. Excavated material will be set adjacent to the trench for~~

~~inclusion in the FDR mixing operation and spread back into the trench prior to the FDR compaction operation.~~

- Top of utility is less than 6" below bottom of the section FDR, or less than 12" below bottom of the section FDR for High Risk Utility Facilities as defined in Section 5.35 - Contractor shall Excavate and Expose Utility to the top half of the existing utility using hand or other methods as approved by the Engineer, then place a Cement Slurry (2-sack) on top of the utility as shown in the Construction Details on the Plans. The trench and slurry shall extend one foot on either side of the utility. Trench spoils shall be disposed of by the Contractor. The Cement Slurry backfill shall have a minimum depth of 6" above the top of the utility. A full depth HMA (Type A) pavement section shall be placed over the protective Concrete Slurry (2-sack). Bid items have been provided for the work and materials necessary to Excavate and Expose Utility and to place the Cement Slurry (2-sack).
- ~~Top of utility is less than 6" below bottom of the section FDR - Contractor shall excavate above the utility until the top half of the utility is exposed using hand or other methods as approved by the Engineer to remove existing roadway base and subgrade. The trench shall extend one foot on either side of the utility. Trench spoils shall be disposed of by the Contractor. The Contractor shall place 2-sack slurry cement backfill in the trench to the required grade for HMA paving. The slurry cement backfill shall have a minimum depth of 6" above the top of the utility. Slurry cement backfill shall comply with the City Standard Construction Specifications and will be paid for under the Full Depth Reclamation - Cement bid item.~~

Obtain and test material every **500 feet** from the existing pavement structure by coring. You may perform additional sampling and testing to optimize the cement content and adjust for varying underlying materials. Determine the exact locations of the sampling locations between wheel paths. Do not sample in the shoulders. Sampling locations must provide sufficient representative material for the mix design.

The cement content must be **5 percent** by dry weight of FDR—cement with a dry unit weight of **4.4 lb/sf**, except an increase or decrease in the cement content may be ordered based on your mix design. The mix design shown on the plans and specification is based on the removal of all existing AC pavement. The actual mix design used for the project shall be determined by the Contractor in accordance with 30-4.01C(2)(b) "Mix Design," of the State Standard Specifications. The mix design shown on the plans and Specifications is based on the removal of all existing AC pavement. The actual mix design used for the project shall be your mix design. The mix designs shall be submitted to and authorized by the Engineer prior to cold planning the AC pavement. During progress of the work, if you encounter an isolated area that requires more cement than described in the mix design for that area, notify the Engineer before applying the cement.

A test strip per Section 30-1.01D(3) of the State Standard Specifications is not required.

Attention is directed to the presence of shallow utilities within the limits of work. Contractor must use appropriate means and methods during construction to avoid damaging underground utilities. This

shall be reset or repaved by Contractor, as requested by Engineer, to conform to the new minor concrete construction at no additional cost.

Any portions of curb, gutter, sidewalk or any other City improvement damaged by the Contractor during the course of construction be replaced by the Contractor, at their cost, to the satisfaction of the Engineer. The cost of additional replacement of curb, gutter or sidewalk in excess of the estimated quantities shown in the Bid form and Specifications and found necessary during the process of construction (but not due to damage resulting from carelessness on the part of the Contractor during its operation), shall be paid to the Contractor at the unit prices submitted in their bid.

10.21 EXCAVATE AND EXPOSE UTILITY

As previously discussed in Section 10.18, existing utilities that are within 24" of the bottom of the proposed pavement section shall be excavated as shown on the Construction Detail Sheets in the plans. Where shown in the plans, as directed by the Engineer, or where shallow utilities are encountered, the Contractor shall Excavate and Expose Utilities until the top half of the utility is exposed using hand excavation or other methods as approved by the Engineer to remove existing roadway base and subgrade. Excavated material will be set adjacent to the trench for inclusion in the FDR mixing operation or disposed of by the Contractor.

Quantities of Excavate and Expose Utility will be measured by the linear foot as determined from actual measurement of shallow utilities that require protection during construction.

Payment for Excavate and Expose Utility shall be at the contract unit price per linear foot and shall include full compensation for furnishing all labor, materials, tools, equipment, and incidentals, and for doing all the work involved in removing and disposing of roadway pavement and subgrade material, including breaking, removal, hauling, and disposal of existing HMA, asphalt concrete, base, and subbase, as shown on the plans, as specified in the City Standard Specifications and these Special Provisions, and as directed by the Engineer.

10.22 SLURRY CEMENT (2-SACK)

The Contractor shall place Slurry Cement (2-sack) backfill where existing utilities are within 6" of the bottom of the proposed pavement section as identified in the field during construction.

The Slurry Cement (2-sack) backfill shall be placed within the trench per Section 10.18 of these technical specifications and as shown in the plans. The Slurry Cement (2-sack) backfill shall have a minimum depth of 6" above the top of the utility as shown in the Construction Detail Sheets in the plans. The backfill shall comply with the City Standard Construction Specifications.

Quantities of Slurry Cement (2-sack) backfill placed as shown on the plans or directed by the Engineer will be measured by the linear foot as determined from the actual length of Slurry Cement (2-sack) backfill that is placed during construction.

The contract price paid per linear foot for Slurry Cement (2-sack) backfill shall include full compensation for furnishing all labor, materials, tools, equipment, backfill, slurry, and incidentals, and

for doing all the work involved in furnishing and placing the concrete slurry, cleaning the surface, complete in place, as shown on the plans, and as specified in City Standard Specifications and these Special Provisions, and as directed by the Engineer.

10.231 DETECTABLE WARNING SURFACE

Detectable warning surfaces must be installed per the locations shown on the plans and in accordance with City Standard Drawing C-15 and Section 13-10, "Detectable Warning Surface", of the City Standard Specifications and these Special Provisions.

The Contractor shall install detectable warning surfaces in a manner that extends the entire width of the opening of the ramp for a depth of 3 feet.

Submit a 5-year manufacturer's replacement warranty against defects in a prefabricated detectable warning surface. The 5-year manufacturer's replacement warranty for a prefabricated detectable warning surface must cover defects in dome shape, color fastness, sound-on-can acoustic quality, resilience, and attachment. The 5-year warranty period starts at Contract acceptance.

Quantities of detectable warning surface placed as shown on the plans or directed by the Engineer will be measured by the square foot as determined from measurement of the area covered by the detectable warning surface.

The contract price paid per square foot for detectable warning surface shall include full compensation for furnishing all labor, materials, tools, equipment, and incidentals, and for doing all the work involved in furnishing and placing the detectable warning surface, complete in place, as shown on the plans, and as specified in City Standard Specifications and these Special Provisions, and as directed by the Engineer.

10.242 ADJUST DRAINAGE INLET TO GRADE

Contractor shall adjust storm drain inlet in accordance to the details shown in the plans. Adjusting storm drain inlets consists of removing partially the inlet and either lowering or raising the drainage structures.

Adjust to grade with new materials that are similar in character to the existing materials.

Where storm drain inlets are adjusted before placing the uppermost layer of pavement or surfacing, limit the work area so that adjusting the inlet and final paving or surfacing withing the same work day. The top of the inlet grate or cover must be protected during paving operation by heavy plywood covers, steel plate covers, or other authorized methods. Excess paving material must be removed before rolling.

Where inlets are adjusted after placing the uppermost layer of pavement or surfacing, do not adjust the inlet to final grade until the paving or surfacing has been completed immediately adjacent to the inlet.

10.286 RELOCATE FIRE HYDRANT

Relocate existing fire hydrants as shown on the plans, and as directed by the Engineer. All work involved in relocating fire hydrants shall comply with Section 15-8 Fire Hydrants and Standard Drawing No. W-1 of the City of Turlock Standards.

The fire hydrant relocations shall be coordinated with the Engineer to ensure the hydrants are not out of operation for an extended amount of time. The Engineer shall dictate to the Contractor how long they are allowed to have each hydrant out of operation while the work is being completed.

The quantity for Relocate Fire Hydrant will be paid for as units determined from actual count. This item shall include all work necessary to complete the hydrant relocation including, but not limited to, the following:

- Trenching/Excavation
- Trench bracing or stabilization methods
- Concrete removal
- Pipe connections/ joints
- Pipe extensions
- Relocating the existing hydrant assembly to the proposed location shown on the plans
- Trust blocks
- Concrete pad
- Backfill

The contract unit prices paid for Relocate Fire Hydrant shall include full compensation for furnishing all labor, materials, tools, equipment, and incidentals, and for doing all the work involved in relocating the existing fire hydrant, as described above, as shown on the plans, and as specified in these Special Provisions, and as directed by the Engineer.

10.297 REMOVE AND REPLACE MONUMENT

Remove and replace survey monument as shown on the plans. New survey monument work must be performed by a licensed surveyor or civil engineer in the state of California and the work must comply with City Standard Drawing No. M-1.

The quantities of remove and replace monument will be paid for as units determined from actual count.

The contract unit prices paid for remove and replace monuments shall include full compensation for furnishing all labor, materials, tools, equipment, and incidentals, and for doing all the work involved in removing existing and installing new monuments, including disposing excavated materials, backfilling, furnishing and installing monument box, cast iron lid, brick footings, concrete collar and hot mix asphalt paving, complete in place, as shown on the plans, and as specified in these Special Provisions, and as directed by the Engineer.

10.3028 ADJUST FRAMES AND COVERS TO GRADE

Frames and covers of new and existing utility manhole, shall be adjusted to grade and shall conform to the provisions in Section 12-12, "Adjusting Manhole Frames, Monuments and Valve Boxes", of the City Standard Specifications and these Special Provisions.

All city utilities that are within the limits of the full depth reclamation operation shall be lowered (remove lid and frame) and plated before the full depth reclamation operation.

All city utilities shall be raised up to finished grade within 7 days of paving.

All utilities shall be accessible 24 hours per day, 7 days per week throughout construction. The Contractor shall provide reference marks on the nearest curb for all utilities that are lowered.

The contract price paid per each for adjusting frames and covers to grade or adjust manhole frame and cover to grade (including sewer manholes, storm drain manholes, water valves, water meters) shall include full compensation for furnishing all labor, material, tools, equipment and incidentals, and for doing all the work involved in lowering and raising utility manhole frames and cover, complete in place, including structure excavation and backfill, furnishing and installing additional bar reinforcing steel, concrete and HMA (Type A), as shown on the plans, specified in the City Standard Specifications and these Special Provisions, and as directed by Engineer.

10.31~~29~~ CHAIN LINK FENCE (CL-4)

Furnish and install Chain Link Fence (CL-4) as shown on the plans, and as directed by the Engineer. All work involved in constructing the Chain Link Fence (CL-4) shall comply with Section 20 Fencing of the City of Turlock Standards.

The Chain Link Fence (CL-4) shall be 4 feet tall. This item shall include all work necessary to complete the fence installation per the manufacturer's guidelines and consistent with the City's Standards. Where the fence is installed within the limits of the sidewalk, the Contractor shall construct footings to be compliant with ADA standards.

The contract unit prices paid per linear foot of Chain Link Fence (CL-4) shall include full compensation for furnishing all labor, materials, tools, equipment, and incidentals, and for doing all the work involved in installing the Chain Link Fence (CL-4), including excavating, constructing footings, grading, and backfilling, as shown on the plans, and as specified in these Special Provisions, and as directed by the Engineer.

10.32~~0~~ 4' CHAIN LINK GATE (CL-4)

Furnish and install 4' Chain Link Gate (CL-4) as shown on the plans, and as directed by the Engineer. All work involved in constructing the 4' Chain Link Gate (CL-4) shall comply with Section 20 Fencing of the City of Turlock Standards.

The 4' Chain Link Gate (CL-4) shall be 4 feet tall and shall include a gate latch to secure the gate in the closed position. This item shall include all work necessary to complete the gate and latch installation per the manufacturer's guidelines and consistent with the City's Standards. Where the gate is installed within the limits of the sidewalk, the Contractor shall construct footings to be compliant with ADA standards.

The contract unit price paid for 4' Chain Link Gate (CL-4) shall include full compensation for

furnishing all labor, materials, tools, equipment, and incidentals, and for doing all the work involved in installing the 4' Chain Link Gate (CL-4), including excavating, constructing footings, grading, and backfilling, as shown on the plans, and as specified in these Special Provisions, and as directed by the Engineer.

10.33~~1~~ REMOVE FENCE

Remove Fence as shown on the plans, and as directed by the Engineer. Fence removal shall include, but not be limited to, demolition, excavation, concrete footing removal, haul-off and disposal of excavated/ removed materials, or other work required to remove the existing fence for proposed improvements.

[As noted in Section 5.22, the fence removals along the west side of Wallace Street shall be completed no later than July 25, 2025.](#)

At the end of the fence removal limits, the Contractor shall leave a neat end point and cleanly connect the existing fence to any proposed fence work.

Payment for Remove Fence shall be at the contract unit price per linear foot and shall include full compensation for furnishing all labor, materials, tools, equipment, and incidentals and for doing all the work involved in removing the existing fence, hauling, disposal of both existing fence and concrete footings, as specified in these Special Provisions, and as directed by the Engineer.

No additional payment for restoration of adjacent trees, roots, grass, and parkway, to remain-in-place, but damaged by the Contractor during construction, shall be made.

10.34~~2~~ INSTALL ROADSIDE SIGN – ONE POST

Contractor shall install sign posts and foundations in accordance with City Standard ST-11 and ST-12 and these Special Provisions.

Sign panels must comply with the latest version of the California Uniform Traffic Control Devices (CA MUTCD) and City Standard Plates. All signs shall be high intensity prismatic.

The contract price paid per each for Install Roadside Sign-One Post shall include full compensation for furnishing all labor, material, tools, equipment and incidentals, and for doing all the work involved in installing each roadside sign, including, but not limited to, excavation, export, backfill, compaction; new concrete foundations / footings, installation of sign post, sign panels and hardware, complete in place, as shown on the plans, specified in the City Standard Specifications and these Special Provisions, and as directed by Engineer.

Full compensation for furnishing and installing sign panel fastening hardware shall be considered as included in the contract prices paid for the roadside signs requiring the hardware and no separate payment will be made therefor.

10.353 RELOCATE ROADSIDE SIGN

Where indicated on the Plans or as specified by the Engineer, the Contractor shall remove existing signs (posts and panels), then reinstall the signs (posts and panels) and foundations in accordance with City Standard ST-11 and ST-12 and these Special Provisions.

Unless the Engineer specifies otherwise, the existing sign panels shall be reused.

The contract price paid per each for Relocate Roadside Sign shall include full compensation for furnishing all labor, material, tools, equipment and incidentals, and for doing all the work involved in removing the existing roadside sign and reinstalling it as shown on the Plans, including, but not limited to, excavation, export, backfill, compaction; new concrete foundations / footings, installation of sign post, complete in place, as shown on the plans, specified in the City Standard Specifications and these Special Provisions, and as directed by Engineer.

10.364 THERMOPLASTIC STRIPING AND MARKINGS

All traffic stripes and pavement markings shall conform to Section 84-2, "Traffic Stripes and Pavement Markings," of State Standard Specifications. All striping and markings shall be thermoplastic.

Thermoplastic traffic stripes will be measured by the linear foot along the line of the traffic stripes, without deductions for gaps in broken traffic stripes. A double thermoplastic traffic stripe, consisting of two 6-inch wide yellow stripes, will be measured as 1 traffic stripe.

Pavement markings shall be measured by the square foot for the area covered.

Payment for thermoplastic pavement markings or thermoplastic traffic stripe shall include full compensation for performing all work required to install thermoplastic pavement markings and thermoplastic traffic stripes, and shall include furnishing and installing pavement markers and establishing alignment for stripes and layout work, respective to the detail on the State Standard Plans, in accordance with these Special Provisions and as directed by the Engineer.

10.375 REMOVE THERMOPLASTIC TRAFFIC STRIPE

This item shall be bid per linear foot and must conform to Section 84-9 (Existing Markings) of the 2023 Caltrans Standard Specifications.

This quantity shall be measured per linear foot of striping regardless of the existing stripe's detail number. The quantity as shown in the Plans is the total linear foot measurement and does not account for gaps or double line stripes.

The contract price paid per linear foot of Remove Thermoplastic Traffic Stripe shall include full compensation for furnishing all labor, materials, tools, equipment, and incidentals, proper disposal and for doing all work involved in Removing Thermoplastic Traffic Stripe and no additional payments will be made.

Payment for Remove Thermoplastic Traffic Stripe shall include full compensation for performing all work required to remove thermoplastic traffic stripes, including incidentals and proper disposal, in

accordance with these Special Provisions and as directed by the Engineer.

10.38 REMOVE THERMOPLASTIC PAVEMENT MARKING

This item shall be bid per square foot and must conform to Section 84-9 (Existing Markings) of the 2023 Caltrans Standard Specifications.

The contract price paid per square foot of Remove Thermoplastic Pavement Marking shall include full compensation for furnishing all labor, materials, tools, equipment, and incidentals, proper disposal and for doing all work involved in Removing Thermoplastic Pavement Marking in accordance with these Special Provisions and as directed by the Engineer. and no additional payments will be made.

10.396 VIDEO SEWER AND STORM DRAIN INSPECTION

The contractor shall furnish closed circuit television equipment for an interior inspection of the existing sewer and storm drain mains located within the roadway reconstruction limits. The first video inspection to document the existing condition of the sewer and storm drain mains shall be conducted no more than 14 days prior to the removal of the existing roadway. The second video inspection to demonstrate the Contractor did not cause any damage to the sewer or storm drain mains shall be conducted within 24 hours of completing final compaction of the subgrade, or micro-cracking of the FDR-C section. An electronic copy of the video inspection (standard DVD or Mpeg file format) shall be provided to the City within 24 hours of each inspection at no additional cost to the City. With the copy of the video, the Contractor shall certify, in writing, there is no damage to the inspected sewer and storm drain mains. If there is damage, the Contractor shall indicate in writing, the specific damage and location. The certification must be submitted to and authorized by the Engineer prior to placing HMA pavement.

The requirements for the sewer and storm drain video inspections include:

1. The Video Inspection Company is to certify as to their ability to adequately perform the video inspection.
2. Contractor will provide the City 48-hour notice of inspection schedule so the City inspector may be present to monitor the inspection.
3. A flush truck will be required to be on-site to aid in the video inspection.
4. A copy of the video inspection shall be submitted to the City as proof of inspection along with a certification letter stating no damage to the inspected sewer and storm drain lines has occurred.
5. Sewer lateral lines are to be documented by stationing distance from center line of manhole and the inspection form shall provide a map of the inspected lines.
6. Storm drain lateral lines to and between catch basins shall be video inspected as storm drain mains.
7. To facilitate review, a log of the inspections performed shall correlate with the manholes, stationing, etc., shown on the project plans and the video inspection produced.
8. Joints shall have a view perspective, and have each joint inspected by turning the camera 90 degrees to the joint inspecting all 360 degrees of the connection.
9. Sewer laterals shall have a perspective view identifying clock position to the main and a view into the lateral to identify any damage at the lateral connection.
10. If debris are found during the inspection, the inspection must be terminated and restarted once the debris has been removed and more water flushed through the main.

11. Video Inspection shall be performed in the direction of flow.

The payment for sewer and storm drain video inspection including all labor, material, tools, equipment and incidentals, and for doing all the work involved in the sewer and storm drain video inspection shall be included in Contract lump sum price paid for Video Sewer and Storm Drain.

10.4037 MOBILIZATION & DEMOBILIZATION

Mobilization is intended to compensate the Contractor for operations including, but not limited to, those necessary for the movement of personal, equipment, supplies and incidentals to / from the project site; for the payment of premium cost and insurance for the project; for any necessary costs of acquisition of equipment, including purchase and mobilization expense; and for any other work and operations which must be performed or costs that must be incurred incident to the initiation of meaningful work at the site and for which payment is not otherwise provided in the contract.

- (1) When 5 percent of the original contract amount is earned, 50 percent of the amount bid for mobilization, or 5 percent of the original contract amount, whichever is less, may be paid.
- (2) When 10 percent of the original contract amount is earned, 75 percent of the amount bid for mobilization or 7.5 percent of the original contract amount, whichever is less, may be paid.
- (3) When 20 percent of the original contract amount is earned, 95 percent of the amount bid for mobilization, or 9.5 percent of the original contract amount, whichever is less, may be paid.
- (4) When 50 percent of the original contract amount is earned, 100 percent of the amount bid for mobilization, or 10 percent of the original contract amount, whichever is less, may be paid.
- (5) Upon completion of all work on the project, payment of any amount bid for mobilization in excess of 10 percent of the original contract amount will be paid.

The Contract lump sum price paid for mobilization shall include full compensation for establishing temporary construction storage locations, moving equipment to the project site for the establishment of facilities necessary for work on the project, applying for and obtaining all required permits, and for all other work and operations which must be performed or costs incurred prior to beginning work on the various contract items, including all related administration throughout its duration, and demobilization.

The total price bid for mobilization shall include the cost of all mobilization, demobilization, and administration for the entire contract period.

The City shall make the final determination of the allowable percentage of completion for the payment of mobilization and shall approve the percentage paid based on the percent of contract amount actually earned which will be based upon actual work completed.

FINAL PAVEMENT REPORT

Turlock Pavement Rehabilitation Location 1 – N. Johnson Road, Arbor Way, and Zinfandel Lane/Charles Place Neighborhood Turlock, California

Prepared by:



Crawford & Associates, Inc.
4701 Freeport Boulevard
Sacramento, CA 95822

May 8, 2025

Prepared for:



MARK THOMAS

Mark Thomas
2833 Junction Avenue, Suite 110
San Jose, CA 95134

May 8, 2025
Crawford File No. 23-931.3

Mr. Ed Noriega, PE
Mark Thomas
2833 Junction Avenue, Suite 110
San Jose, CA 95134

Subject: **City of Turlock 2024 Multiple Roads Rehabilitation
Location 1
Final Pavement Design Report**
Turlock, California

Dear Mr. Noriega,

Crawford & Associates, Inc. (Crawford) is pleased to submit this Final Pavement Design Report for Location 1 (within the N. Johnson Road, Arbor Way, and Zinfandel Lane/Charles Place neighborhood) as part of the City of Turlock Pavement Rehabilitation efforts in Turlock, California. We prepared this report in accordance with our February 27, 2024 agreement associated with City Contract No 2023-109. A separate report will be prepared for Location 2 (also included in City Contract No 2023-109). The purpose of this report is to provide pavement recommendations for consideration by the City of Turlock and the design team.

Thank you for selecting Crawford to be on your design team. Please call if you have questions or require additional information.

Sincerely,

Crawford & Associates, Inc.,

Reviewed By,



Carmelo Pagan
Staff Engineer

Benjamin Crawford, PE, GE
Principal



Amando Castro, PE
Project Manager



1	INTRODUCTION	1
1.1	SCOPE OF SERVICES	1
2	PROJECT DESCRIPTION	1
3	HISTORICAL DATA	2
4	FIELDWORK	2
4.1	PAVEMENT CONDITION ASSESSMENT	2
4.1.1	SECTION 1	4
4.1.2	SECTION 2	5
4.2	PAVEMENT CORES	5
4.3	SUBGRADE CONDITIONS	7
5	CONCLUSIONS AND RECOMMENDATIONS	7
5.1	SECTION 1	8
5.2	SECTION 2	8
5.3	FULL DEPTH RECLAMATION (FDR)	8
5.4	FULL DEPTH HMA	9
5.5	TRADITIONAL PAVEMENT SECTION	9
6	CONSTRUCTION CONSIDERATIONS	10
7	RISK MANAGEMENT	10
8	LIMITATIONS	10

LIST OF TABLES

Table 1: Pavement Core Results	5
Table 4: Full Depth HMA Sections	9
Table 5: New Pavement Sections	10

FIGURES

Figures 1A-1C Vicinity and Exploration Maps

APPENDIX A

Core Logs and Photos

APPENDIX B

Laboratory Test Results



1 INTRODUCTION

Crawford & Associates, Inc. (Crawford) is pleased to submit this Final Pavement Design Report for Location 1 (generally within the N. Johnson Road, Arbor Avenue and Zinfandel Lane/Charles Place Neighborhood) as part of the City of Turlock Pavement Rehabilitation efforts in Turlock, California. We prepared this report in accordance with our February 27, 2024 agreement associated with City Contract No 2023-109. A separate report will be prepared for Location 2 (also included in City Contract No 2023-109). The purpose of this report is to support the City of Turlock (City) and the design team during project design, plan, and specification development.

1.1 SCOPE OF SERVICES

To prepare this report, Crawford:

- Discussed the proposed improvements with Mr. Ed Noriega, PE and Ms. Cynthia Horner, PE, with Mark Thomas, and Mr. Fred Pezeshk, PE with the City;
- Conducted a site visit and marked USA on April 8, 2024;
- Conducted a pavement conditions assessment on April 19, 2024;
- Performed pavement coring and subsurface soil sampling between April 26 and May 8, 2024;
- Performed laboratory testing (R-values) on representative subgrade samples; and
- Performed calculations and engineering analysis.

2 PROJECT DESCRIPTION

We understand that this project is a part of the City of Turlock's larger CIP to improve the pavement condition index throughout the City. Based on our conversations with the design team and the City, the primary purpose of this project is to rehabilitate and repair 32 residential roadways (approximately 4 miles total) within the eastern portion of the City (within the N. Johnson Road, Arbor Way, and Zinfandel Lane/Charles Place neighborhood). The City desires the following design traffic index (TI) for this project, for local roads a TI of 6 (7 at intersections), for minor and major collectors a TI of 8 (9 at intersections), and for major and principal arterials a TI of 10 (11 at intersections).

Location 1, as defined in City Contract 2023-109, includes rehabilitating the following roadways as part of this project:

- North Johnson Road between East Hawkeye Avenue and East Tuolumne Avenue;
- Hammond Drive between N Johnson Road and N Johnson Road;
- Stuart Place between the South end and Hammond Drive;
- Ashley court between the West end and North Johnson Road;
- Jackson Court between the North end and North Johnson Road;
- Sconyers Court between the East end and North Johnson Road;
- North Quincy Avenue between Marie Drive and East Hawkeye Avenue;
- Linn Court between its North end and Mira Flores Drive;
- La Sombra Court between Mira Flores Drive and Mira Flores Drive;
- Novo Drive between East Canal Drive and Mira Flores Drive;
- Arbor Way between North Berkeley Avenue and North Quincy Road;

- Karen Way between Arbor Way and Christine Way;
- Christine Way between Karen Way and Heppner Way;
- Heppner Way between Arbor Way and Christine Way;
- California Avenue between North Berkeley Avenue and North Johnson Road;
- El Paseo Drive between East Canal Drive and Arbor Way;
- Linda Vista Drive between El Paseo Drive and North Johnson Road;
- Zinfandel Lane between North Johnson Road and Corello Street;
- Charles Place between Wallace Street and North Johnson Road;
- Wallace Street between E. Marshall Street and Charles Place;

3 HISTORICAL DATA

No as-built plans or maintenance reports were made available while this final pavement report was being prepared.

According to information provided by the City, Pavement Condition Index (PCI) values were assigned to the streets included in this project. PCI is a scale to quantify the condition of a street based on the surface condition observed including crack size, quantity, and depth, raveling, and rutting. Generally, PCI values above 75 (fair to good condition) require preservation methods, between 75 and 50 (fair to poor condition) require resurfacing, and below 50 (poor to very poor condition) require rehabilitation or reconstruction. We supplement the PCI assigned to each street with our pavement condition assessment and describe our findings in the sections below.

4 FIELDWORK

Crawford evaluated the condition of the existing pavement by walking the roadway and reviewing the pavement surface conditions. Crawford cored the pavement at 64 locations to measure the existing structural sections of Hot Mix Asphalt (HMA) and Aggregate Base (AB) thicknesses, identify historical overlays, the presence of paving fabric, and collect subgrade samples for laboratory testing.

We provide the overall project alignment in Figure 1A and present the core locations in Figures 1B and 1C.

4.1 PAVEMENT CONDITION ASSESSMENT

During our pavement assessment, we walked the project alignment and noted the current pavement conditions including cracking, patching/potholes, and surface distress. Based on the observations, and the PCI, project alignment can generally be broken down into two sections as presented in Table 1 below.

Table 1: Turlock Pavement Condition Assessment Generalized Sections

Section	Roadway	PCI Assigned
1	Jackson Court	83
	Sconyers Court	68

FINAL PAVEMENT REPORTTurlock Pavement Rehabilitation – Location 1
Turlock, California**Crawford**File: 23-931.3
May 8, 2025

Section	Roadway	PCI Assigned
1	Hammond Drive (1740 Hammond Drive to N Johnson Rd)	71
	La Sombra Court (Mira Flores Dr to La Sombra Ct)	63
	Karen Way	69
	Ashley Court	77
	Jackson Court	83
	Arbor Way (Heppner Wy. to N. Quincy Rd)	53
	Christine Way	56
	Heppner Way	82
2	North Johnson Road (E. Hawkeye to Hammond Dr)	5
	North Johnson Road (Hammond Dr to Sconyers Ct)	28
	Hammond Drive (N. Johnson Rd to 1740 Hammond)	0
	North Quincy Road	25
	Linn Court	27
	Stuart Place	13
	La Sombra Court (La Sombra Ct to La Sombra Ct)	37
	La Sombra Court (La Sombra Ct to Mira Flores Dr)	29
	Novo Drive	34
	Arbor Way (N. Berkley Ave to Edward Dr)	24
	Arbor Way (Edward Dr to N. Johnson Rd)	4
	Arbor Way (N. Johnson Rd to Karen Wy)	13
	Arbor Way (Karen Wy to Heppner Wy.)	20
	California Ave	41
El Paseo Drive (E. Canal Dr to El Capitan Dr)	21	

Section	Roadway	PCI Assigned
2	El Paseo Drive (El Capitan Dr to Arbor Wy.)	34
	Linda Vista Drive	22
	Zinfandel Lane (N. Johnson Rd to Old Vineyard Rd)	14
	Zinfandel Lane (Old Vineyard Rd to N. Quincy Rd)	29
	Zinfandel Lane (N. Quincy Rd to Corrello St)	27
	Charles Place	33
	Wallace Street	15

The assessment of each section is discussed below.

4.1.1 SECTION 1

The streets included in this section were assigned a PCI above 50. This range of PCI correlates to pavement in generally fair to poor condition. The results of our pavement condition assessment generally agree with the assigned PCI values. We observed the streets in Section 1 to be in generally fair condition with low to moderate severity block cracks. Lack of maintenance was observed as vegetation was beginning to grow within the cracks and moderate to high severity raveling was present along all of the streets.



Photo 1: Section 1 Moderate Longitudinal Cracking

4.1.2 SECTION 2

Section 2 represents the heavily distressed roadways with PCI values ranging between 0 and 41. A PCI value below 50 typically indicates heavy distress features (like potholes, alligator cracks, rutting,... etc) and surface treatments will likely not produce the desired end product. Pavement failure in Section 2 is evidenced by the high-severity potholes and heavy alligator cracks we observed during our pavement condition assessment. The patch efforts and filled potholes have failed and are cracks intruding into the patches. Outside of the potholes, we observed high-severity alligator cracking, raveling and rutting (see Photo 2 below).



Photo 2: Section 2 Raveling, Alligator Cracks and Failed Patching

4.2 PAVEMENT CORES

We present the results of our pavement coring and R-value test results in Table 1 below.

Table 2: Pavement Core Results

Section	Core Number	Roadway	AC Thickness (ft)	AB Thickness (ft)	Subgrade Sample Depth (ft)	Existing TI Range	R-value Result
2	C-1	North Johnson Road	0.20	0.37	3.41	4-5	49
	C-2	North Johnson Road	0.16	0.33	2.25	3-4	
	C-3	North Johnson Road	0.16	0.33	4.5	3-4	
	C-4	North Johnson Road	0.16	0.50	4.33	4-5	49
	C-5	North Johnson Road	0.21	0.50	4.29	5-6	
	C-6	North Johnson Road	0.17	0.33	4.5	3-4	
	C-7	Sconyers Court	0.25	0.38	4.37	4-5	
1	C-8	Ashley Court	0.17	0.33	1.83	3-4	49
	C-9 ¹	Jackson Court	0.17	0.54	4.29	5-6	
	C-10	Hammond Drive	0.21	0.37	4.41	4-5	

FINAL PAVEMENT REPORT

Turlock Pavement Rehabilitation – Location 1
Turlock, California

Crawford

File: 23-931.3
May 8, 2025

Section	Core Number	Roadway	AC Thickness (ft)	AB Thickness (ft)	Subgrade Sample Depth (ft)	Existing TI Range	R-value Result	
	C-11	Hammond Drive	0.25	0.50	4.25	5-6	60	
2	C-12	Hammond Drive	0.16	0.50	4.33	4-5		
	C-13	Stuart Place	0.20	0.37	4.41	4-5		
	C-14 ¹	California Avenue	0.33	--	4.66	4-5		
	C-15 ¹	California Avenue	0.29	--	3.91	3-4		
	C-16 ¹	California Avenue	0.16	0.37	2.91	7-8		
	C-17	Arbor Way	0.25	0.25	4.5	5-6		
	C-18	Arbor Way	0.16	--	4.83	2-3		
	C-19 ¹	Arbor Way	0.20	0.45	4.33	6-7		
	C-20 ¹	Arbor Way	0.25	0.25	2.08	5-6		
1	C-21	Arbor Way	0.16	0.50	3.33	6-7	60	
	C-22	Karen Way	0.22	0.33	4.43	5-6		
	C-23	Christine Way	0.16	0.33	3.16	6-7		
	C-24	Heppner Way	0.23	0.26	2.0	5-6		
2	C-25	North Quincy Road	0.16	0.33	4.5	4-5		60
	C-26	North Quincy Road	0.37	0.16	3.79	5-6		
	C-27 ¹	El Paseo Street	0.10	--	3.02	4-3		
	C-28	El Paseo Street	0.45	--	4.54	5-6		
	C-29 ¹	El Paseo Street	0.08	--	2.58	5-6		
	C-30 ¹	Linda Vista Street	0.29	--	4.70	3-4		
	C-31	La Sombra Court	0.25	0.33	1.08	5-6		
	C-32	La Sombra Court	0.25	0.16	2.25	4-5		
	C-33	Linn Court	0.20	0.29	2.5	4-5		
	C-34	Novo Drive	0.16	0.25	4.58	4-5		
	C-35	Novo Drive	0.12	--	4.87	1-2		
	C-36 ¹	Wallace Street	0.45	--	3.37	3-4	23	
	C-37 ¹	Charles Place	0.41	--	3.91	2-3		
	C-38	Charles Place	0.33	--	3.37	2-3		
C-39	Zinfandel Lane	0.08	0.16	3.66	1-2			
C-40	Zinfandel Lane	0.16	0.16	2.5	1-2			
C-41	Zinfandel Lane	0.20	0.12	3.16	1-2			
2	C-42	Zinfandel Lane	0.16	0.25	4.08	2-3	49	
	C-43	North Johnson Road	0.16	--	--	3-4		
	C-44	North Johnson Road	0.16	0.41	--	4-5		
1	C-45	Sconyers Court	0.16	0.41	--	4-5	49	
	C-46	Ashley Court	0.13	0.47	--	3-4		
2	C-47	Jackson Court	0.16	0.47	--	5-6	60	
	C-48	Hammond Drive	0.16	0.54	--	4-5		
	C-49	Stuart Place	0.13	0.54	--	4-5		
	C-50	California Avenue	0.16	0.33	--	4-5		
1	C-51 ¹	Arbor Way	0.08	--	--	4-5	60	
	C-52	Karen Way	0.16	0.25	--	5-6		
	C-53	Christine Way	0.16	0.29	--	6-7		
2	C-54	Heppner Way	0.13	5.5	--	5-6	60	
2	C-55	North Quincy Road	0.16	0.33	--	4-5		

Section	Core Number	Roadway	AC Thickness (ft)	AB Thickness (ft)	Subgrade Sample Depth (ft)	Existing TI Range	R-value Result
	C-56 ¹	El Paseo Street	0.16	--	--	5-6	23
	C-57 ¹	Linda Vista Street	0.13	--	--	3-4	
	C-58	La Sombra Court	0.16	0.67	--	5-6	
	C-59	La Sombra Court	0.16	0.67	--	4-5	
	C-60	Linn Court	0.16	0.33	--	4-5	
	C-61	Novo Drive	0.16	0.42	--	4-5	
	C-62	Wallace Street	0.08	--	--	3-4	
	C-63	Charles Place	0.13	--	--	2-3	
	C-64	Zinfandel Lane	0.16	0.46	--	1-2	

-- Not encountered.

¹ Oil Road Encountered

We used the Caltrans Highway Design Manual, Chapter 630 methodology to back-calculate the traffic index the existing pavement sections. We established in-place/aged gravel factors for the asphalt and aggregate base and used R-values obtained from our laboratory testing. The existing asphalt thickness was generally between 2 to 3 inches, however anomalies were encountered on Wallace Street, El Paseo Street, and Charles Place where approximately 5 inches of HMA was observed. No fabric was present in our cores and aggregate base thickness ranged between 1.5 and 6.5 inches. Oiled gravel/sand was encountered underneath cores 9, 14, 15, 16, 19, 20, 27, 29, 30, 36, and 37 and the thicknesses ranged between 1 to 7 inches.

4.3 SUBGRADE CONDITIONS

We visually classified the encountered subgrade as Poorly-graded Sand with Silt (SP-SM) to Silty Sand (SM). R-Value laboratory tests performed on three subgrade samples (C-5, C-30, and C-42) yielded results of 23, 49, and 60, respectively. We present the core logs with further subgrade descriptions in Appendix A, and laboratory results in Appendix B.

5 CONCLUSIONS AND RECOMMENDATIONS

The PCI for the pavement in Section 1 correlates with preservation-type treatments, like seals or micro-surfacing; however, the existing structural sections fail to support the desired design traffic index and the existing curb and gutter limit rehabilitation alternatives. The existing HMA sections encountered in all of our cores indicate an insufficiency in the structural sections eliminating the potential for a mill and overlay.

Our pavement condition assessment for Section 2 generally agrees with the PCI assigned to each street. The streets are in very poor condition and likely no longer supporting the traffic loading it is currently experiencing. Complete reconstruction or robust rehabilitation is warranted for the streets in Section 2.

We provide our recommended pavement strategies and options for the two sections below. It is our understanding that streets in this project are classified as local roads and minor collectors. Therefore, we provide pavement sections that satisfy a design TI ranging between 6 to 9. Below we provide a rehabilitation strategy that takes into consideration the current condition of the two sections, the existing pavement section thicknesses, and the design TI.

5.1 SECTION 1

Section 1 is fair to poor condition with moderate severity block cracks and fair condition patches. The existing section is significantly deficient when compared to the City's desired traffic index. The cracks present are exasperated by the high severity raveling. Many of the cracks show signs of water seepage, impacting the AB and subgrade.

The existing pavement thicknesses in Section 1 result in an average traffic index of 3 to 4, therefore, to achieve a traffic index of 6 (7 at intersections), an increase in the existing pavement sections would be required. An increase in the section thickness can be accomplished in three ways:

- 1) Remove the existing pavement section and replace it with a structurally adequate section using either full-depth HMA (recommendations in Section 5.4 of this report) or a traditional pavement section with HMA and AB (recommendations in Section 5.5 of this report).
- 2) Perform full-depth reclamation (FDR), which increases the section from the top down (recommendations in Section 5.3 of this report) and is typically more economical than a remove and replace (option 1 above).
- 3) Traditional remove and replace. This is the costliest option and we provide this as a reference for the City to compare to other rehabilitation options.

5.2 SECTION 2

Section 2 is in very poor condition and significant pavement failure was observed during our pavement assessment. To improve the PCI rating and meet the design traffic index, a significant rehabilitation strategy is required. This strategy includes:

- 1) Full Depth Reclamation (FDR). FDR is likely the most cost effective method of rehabilitation, and the minimum design sections can support TI's greater than the design TI.
- 2) Full Depth HMA. In lieu of a mill and overlay, complete removal of the HMA section, regrading to meet grade constraints, and placing a new HMA section to satisfy the design TI is an appropriate option for rehabilitation. This option is likely costlier than an FDR, however, still provides the support required to meet the design TI and not interfere with grade constraints.
- 3) While a mill and overlay (with a grade increase) could provide a sufficient HMA structural section to support the design TI, the remaining HMA (after milling) would be in very poor condition providing a base not conducive for an overlay (much of the remaining HMA would likely unravel during milling and cause constructability issues). The cracks would likely propagate to the surface within 5 years but a temporary increase in the PCI would occur. We do not recommend this option.

5.3 FULL DEPTH RECLAMATION (FDR)

FDR is the process of recycling the existing pavement section (HMA, AB, and subgrade) with cement and water. The FDR mix is then graded to meet the required grade constraints and compacted. Because FDR does not have the skid resistance or strength of HMA, a structural HMA wearing coarse is required.

In-Place Recycle rehabilitation should consist of thoroughly dismantling and mixing the existing (after milling) HMA, AB, and subgrade material with Portland cement (the amount will be

determined if this option is selected) and water to the required depth. Following mixing process, compact the recycled section to 95% relative compaction (ASTM D1557) at least 2% above optimum moisture content.

All exposed surfaces should be kept moist or bituminous cure sealed if exposure is expected to be greater than 3 days. We recommend microcracking the finished recycled section prior to HMA placement; this will help prevent shrinkage cracks from propagating through the HMA section. Finally, the In-Place Recycle section should be proof rolled for stability prior to placing HMA.

Table 3: Full Depth Recycled Sections

Roadway Section	Traffic Index	Thicknesses (ft)		
		HMA ²	FDR ^{3,4}	Total Pavement Thickness
Local Road	6.0 ¹	0.25	0.75	1.00
	7.0	0.25	1.00	1.25
Minor/Major Collector	8.0	0.30	1.15	1.45
	9.0	0.35	1.30	1.65

¹Traffic Index is based on the required HMA section, however actual Traffic Index is slightly higher due to using a minimum FDR section.

²New HMA wearing coarse.

³The depth and location of existing utilities would need to be determined to confirm ability to recycle in-place.

⁴Full Depth Recycling method ($G_r = 1.2$) based on a minimum developed unconfined compressive strength of 300 psi (CTM 373). Minimum recommended FDR section is 0.70 feet

Full Depth Reclamation (FDR) is more cost effective and relatively fast as compared to remove and replace methods (traditional pavement sections or full depth HMA). If FDR is selected, we can complete mix design(s) at a range of appropriate cement contents for bidding purposes.

5.4 FULL DEPTH HMA

We provide full depth HMA structural sections as an alternative to meet the design TI for the project using a design R-value of 23. This alternative requires the removal of the existing HMA, moisture conditioning and recompacting the exposed subgrade prior to placement of the new HMA.

Table 4: Full Depth HMA Sections

Roadway Section	Traffic Index	Hot Mix Asphalt (ft)
Local Road	6.0	0.65
	7.0	0.75
Minor/Major Collector	8.0	0.85
	9.0	0.95

5.5 TRADITIONAL PAVEMENT SECTION

We provide traditional pavement structural sections as an alternative to meet the design TI for the project using a design R-value of 23.

Table 5: New Pavement Sections

Roadway Section	Traffic Index	Thicknesses (ft)		
		HMA	AB	Total Pavement Thickness
Local Road	6.0	0.25	0.80	1.05
	7.0	0.30	0.95	1.25
Minor/Major Collector	8.0	0.40	1.10	1.50
	9.0	0.45	1.25	1.5

6 CONSTRUCTION CONSIDERATIONS

During our fieldwork, underground utilities were marked and avoided. The presence of underground utilities could significantly impact the rehabilitation alternatives for this project. Should any form of bottom-up construction methods be selected (such as FDR), special attention to existing utilities should be given. The contractor should be responsible for locating any utility within the project limits. Based on our experience and discussion with contractors, a minimum separation/cover of 1.25 ft to 1.5 ft (depending on the type of utility) between the utility and the proposed scarification/recycled section should be used to reduce impacts to utilities.

7 RISK MANAGEMENT

Our experience, and that of our profession, clearly indicates that the risks of costly design, construction, and maintenance problems can be significantly lowered by retaining the Geotechnical Engineer of Record to provide additional services during design and construction. For this project, Crawford should be retained as the Geotechnical Engineer of Record to:

- Review and provide comments on the civil plans and specifications prior to construction;
- Monitor construction to check and document our report assumptions. At a minimum, Crawford should monitor grading, scarification and compaction of the roadway subgrade;
- Update this report if design changes occur, 2 years or more lapse between this report and construction, and/or site conditions have changed.

If we are not retained to perform the above applicable services, we are not responsible for any other party’s interpretation of our report, and subsequent addendums, letters, and discussions.

8 LIMITATIONS

Crawford performed services in accordance with generally accepted geotechnical engineering principles and practices currently used in this area. Where referenced, we used ASTM or Caltrans standards as a general (not strict) *guideline* only. We do not warranty our services.

Crawford based this report on the current site conditions. We assume the soil, AB, and HMA conditions encountered during our fieldwork are representative of the subsurface and pavement conditions at the site. Actual conditions between core and boring locations can be different.


Our scope did not include evaluation of on-site hazardous materials, site geology, site seismicity, or flooding potential.

The pavement core locations shown in Figures 1A to 1D are based on visual comparisons made in the field between site features and features shown on aerial mapping, therefore they are approximate.

Modern design and construction are complex, with many regulatory restrictions, involved parties, and construction alternatives. It is common to experience changes and delays. The owner should set aside a reasonable contingency fund based on complexities and cost estimates to cover changes and delay

FIGURES

Figures 1 – Vicinity Map
Figures 2 – Exploration Maps

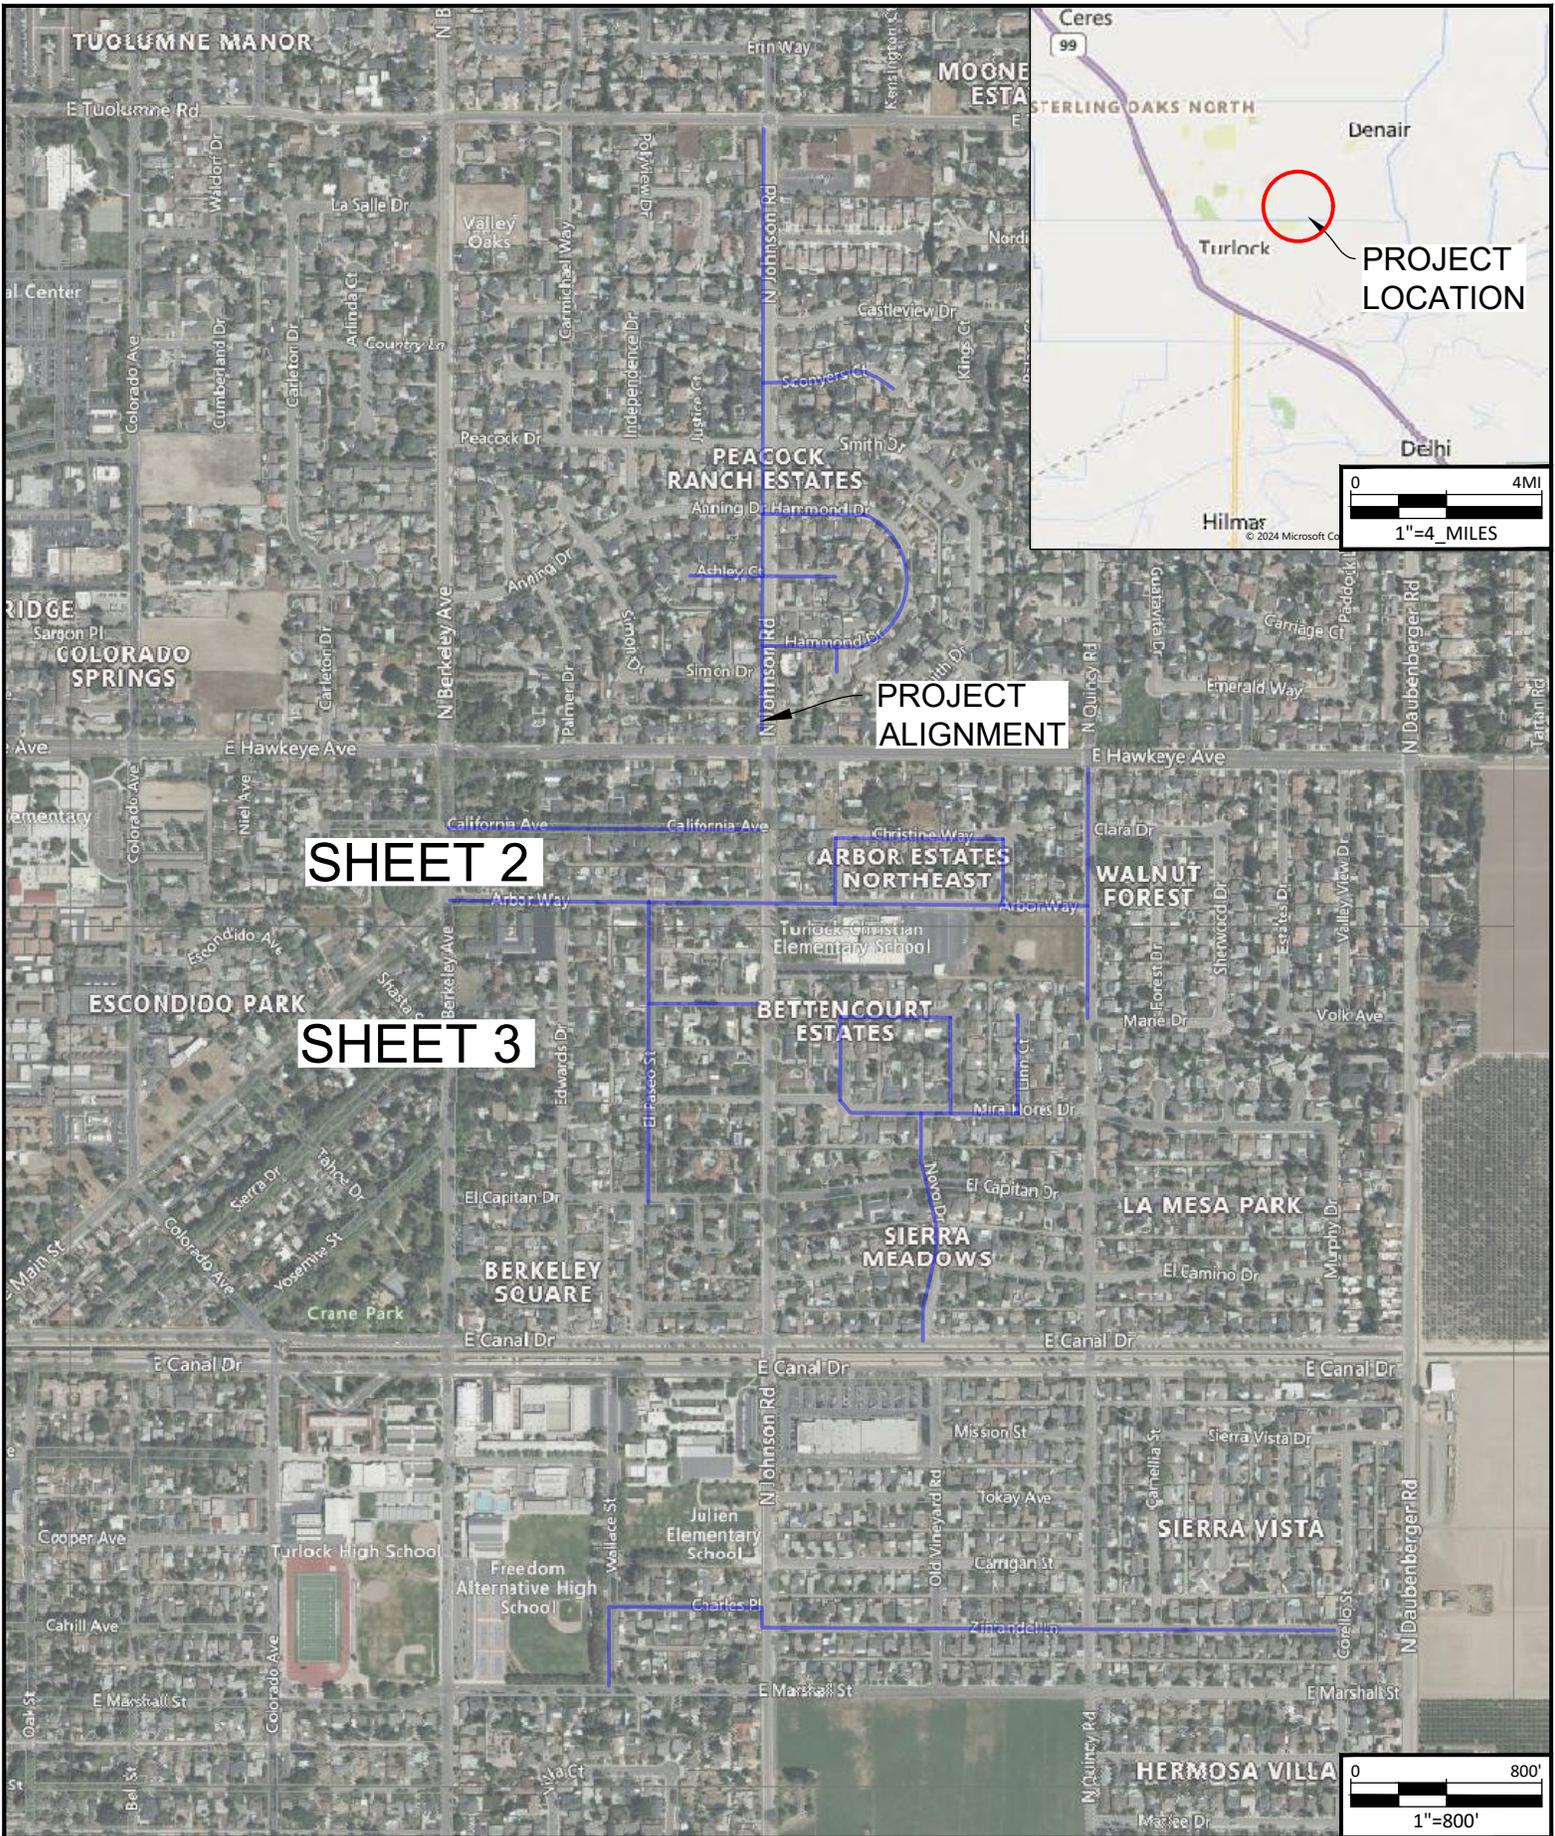

SHEET 2

SHEET 3

PROJECT ALIGNMENT

PROJECT LOCATION



NORTH

Source:
 Basemap: AutoCAD Civil3D Geolocation Tool, using
 Bing Maps




**TURLOCK PAVEMENT
 REHABILITATION
 LOCATION 3**

TURLOCK, CA


Figure 1
 Vicinity
 Map

Prj. No: 23-931.3
 Date: 06/04/2024

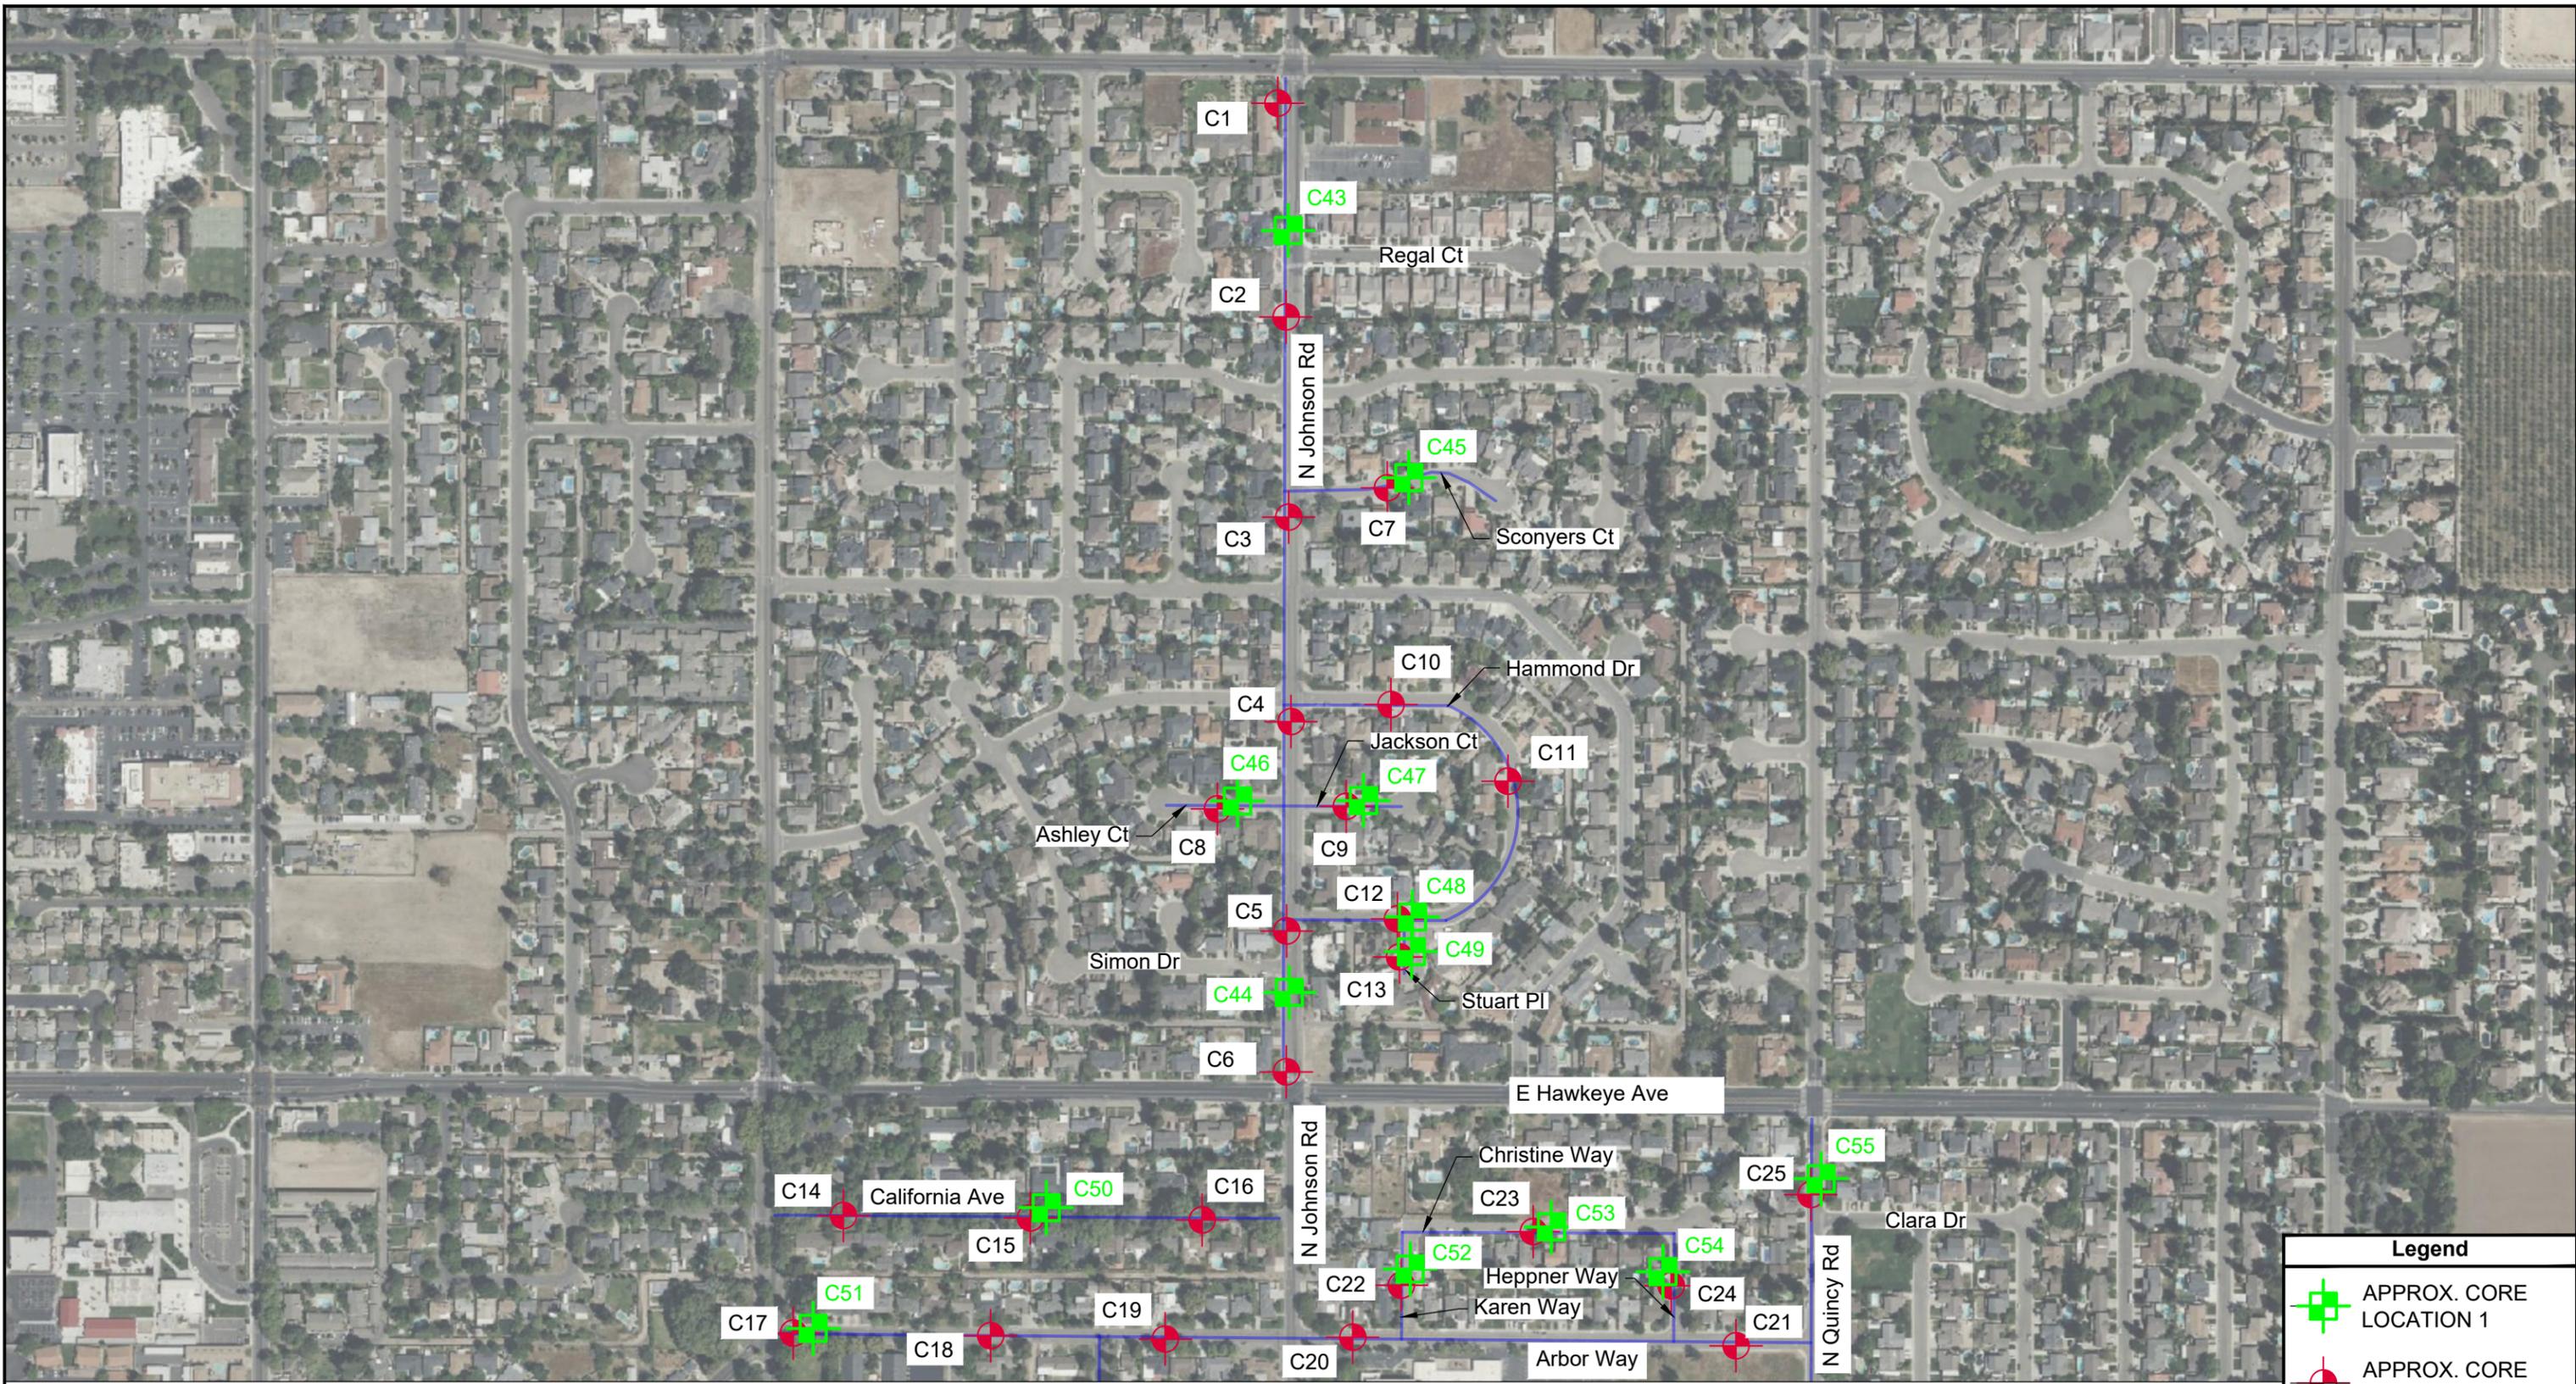

MATCHLINE- SEE SHEET 2 EXPLORATION MAP

Legend	
	APPROX. CORE LOCATION 1
	APPROX. CORE LOCATION 1
	PROJECT ALIGNMENT

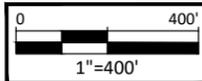

Source:
 Basemap: AutoCAD Civil3D Geolocation Tool, using
 Bing Maps




TURLOCK PAVEMENT
 REHABILITATION
 LOCATION 1 & 3


 TURLOCK, CA

Figure 2
 Exploration
 Map 1 of 2
 Prj. No: 23-931.3
 Date: 07/04/2024

MATCHLINE- SEE SHEET 1 EXPLORATION MAP

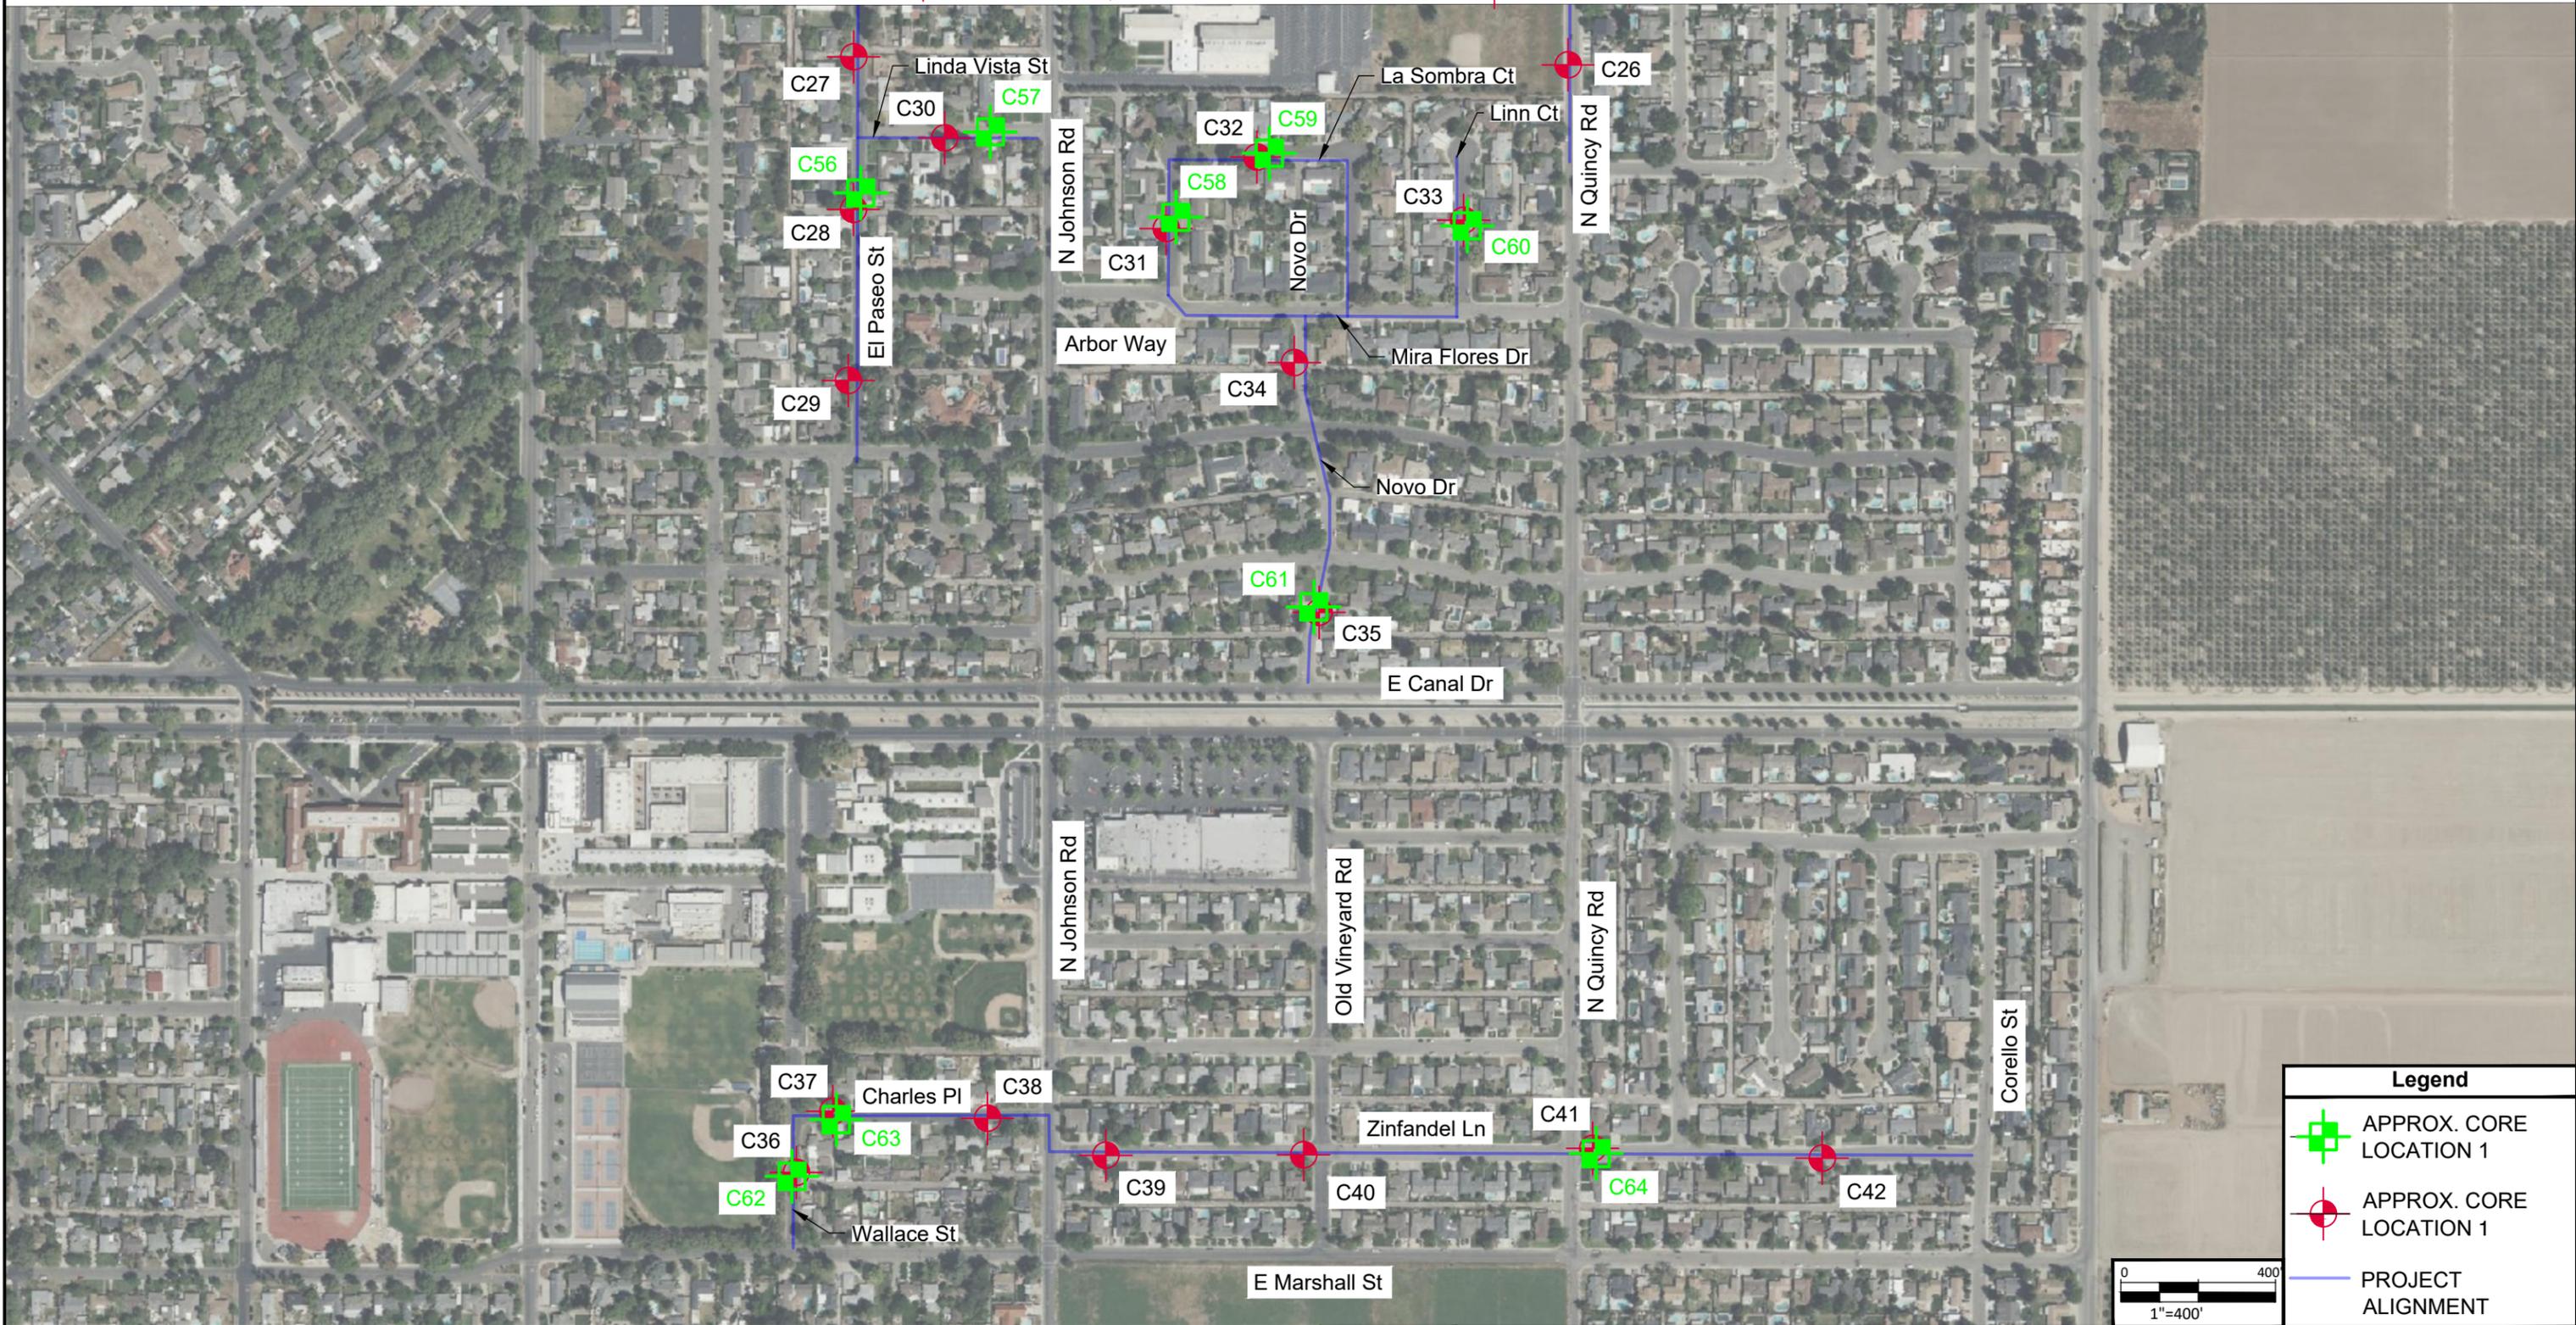

Legend	
	APPROX. CORE LOCATION 1
	APPROX. CORE LOCATION 1
	PROJECT ALIGNMENT

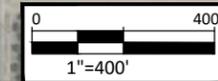

Source:
 Basemap: AutoCAD Civil3D Geolocation Tool, using
 Bing Maps



TURLOCK PAVEMENT
 REHABILITATION
 LOCATION 1 & 3

 TURLOCK, CA

Figure 2
 Exploration
 Map 2 of 2

 Prj. No: 23-931.3
 Date: 07/04/2024

APPENDIX A

Core Logs

PAVEMENT REPORT

Turlock Pavement Rehabilitation – Location 1
Turlock, California

Crawford & Associates, Inc.

File: 23-931.3

Core No.	AC (in)	AB (in)	Subgrade	Additional Notes	Photo
C-1	2.5	4.5	Silty Sand (SM)		 A photograph of a cylindrical core sample of asphalt concrete. The sample is dark with some lighter aggregate visible. It is placed on a rough, grey surface. To the left of the sample is a white rectangular label with handwritten text: "23-931.3", "#1 AC", and "05/03/24". To the right of the sample is a yellow measuring tape showing a height of approximately 2.5 inches.
C-2	2	4	Silty Sand (SM)		 A photograph of a cylindrical core sample of asphalt concrete, similar to C-1. It is placed on a rough, grey surface. To the left of the sample is a white rectangular label with handwritten text: "23-931.3", "#2 AC", and "05/03/24". To the right of the sample is a yellow measuring tape showing a height of approximately 2 inches.

PAVEMENT REPORT

Turlock Pavement Rehabilitation – Location 1
Turlock, California

Crawford & Associates, Inc.

File: 23-931.3

Core No.	AC (in)	AB (in)	Subgrade	Additional Notes	Photo
C-3	2	4	Silty Sand (SM)		 A photograph of a cylindrical core sample of asphalt concrete (AC) with aggregate, resting on a concrete surface. A yellow measuring tape is placed vertically to the right of the core, showing a height of approximately 4 inches. In the background, a white board has handwritten text: "23-931.3", "#3 AC", and "05/02/24".
C-4	2	6	Silty Sand (SM)		 A photograph of a cylindrical core sample of asphalt concrete (AC) with aggregate, resting on a concrete surface. A yellow measuring tape is placed vertically to the right of the core, showing a height of approximately 6 inches. In the background, a white board has handwritten text: "23-931.3", "#4 AC", and "05/02/24".

PAVEMENT REPORT

Turlock Pavement Rehabilitation – Location 1
Turlock, California

Crawford & Associates, Inc.

File: 23-931.3

Core No.	AC (in)	AB (in)	Subgrade	Additional Notes	Photo
C-5	2.5	6	Silt with SAND (ML)		 A photograph of a cylindrical core sample labeled C-5. The core is dark with visible aggregate and is placed on a white board. The board has handwritten text: "23-931.3", "#5 AC", and "05/02/24". A yellow measuring tape is visible on the right side of the board, showing markings from 2 to 10 inches.
C-6	2	4	Sandy Silt (ML)		 A photograph of a cylindrical core sample labeled C-6. The core is dark and appears to be composed of silt and sand. It is placed on a white board with handwritten text: "23-931.3", "AC #6", and "5/8/24". A yellow measuring tape is visible on the right side of the board, showing markings from 2 to 20 inches.

PAVEMENT REPORT

Turlock Pavement Rehabilitation – Location 1
Turlock, California

Crawford & Associates, Inc.

File: 23-931.3

Core No.	AC (in)	AB (in)	Subgrade	Additional Notes	Photo
C-7	3	4.5	Silty SAND (SM)		
C-8	2	4	Silty SAND (SM)		

PAVEMENT REPORT

Turlock Pavement Rehabilitation – Location 1
Turlock, California

Crawford & Associates, Inc.

File: 23-931.3

Core No.	AC (in)	AB (in)	Subgrade	Additional Notes	Photo
C-9	2	6.5	Silt with SAND (ML)		 A photograph of a cylindrical core sample of asphalt concrete (AC) labeled C-9. The sample is dark and contains some aggregate. It is placed on a gravel surface next to a white box with handwritten text: "23-931.3", "#9 AC", and "5/02/24". A yellow measuring tape is visible on the right side of the box, showing the sample is approximately 2 inches high.
C-10	2.5	4.5	Silt with SAND (ML)		 A photograph of a cylindrical core sample of asphalt concrete (AC) labeled C-10. The sample is dark and contains some aggregate. It is placed on a gravel surface next to a white box with handwritten text: "23-931.3", "#10 AC", and "5/02/24". A yellow measuring tape is visible on the right side of the box, showing the sample is approximately 2.5 inches high.

PAVEMENT REPORT

Turlock Pavement Rehabilitation – Location 1
Turlock, California

Crawford & Associates, Inc.

File: 23-931.3

Core No.	AC (in)	AB (in)	Subgrade	Additional Notes	Photo
C-11	3	6	Silt with SAND (ML)		 A photograph of a cylindrical core sample of asphalt concrete. The sample is dark and appears to be composed of silt and sand. It is placed on a gravel surface. To the left of the sample is a white rectangular label with handwritten text: "23-931.3", "#11 AC", and "5/02/24". To the right of the sample is a yellow measuring tape showing inches from 2 to 8.
C-12	2	6	Silt with SAND (ML)		 A photograph of a cylindrical core sample of asphalt concrete. The sample is dark and appears to be composed of silt and sand. It is placed on a gravel surface. To the left of the sample is a white rectangular label with handwritten text: "23-931.3", "#12 AC", and "5/02/24". To the right of the sample is a yellow measuring tape showing inches from 2 to 9.

PAVEMENT REPORT

Turlock Pavement Rehabilitation – Location 1
Turlock, California

Crawford & Associates, Inc.

File: 23-931.3

Core No.	AC (in)	AB (in)	Subgrade	Additional Notes	Photo
C-13	2.5	4.5	Silt with SAND (ML)		 A photograph of a cylindrical core sample of asphalt concrete. The sample is dark and contains some aggregate. It is placed on a light-colored surface. To the left of the sample is a white rectangular label with handwritten text: "23-931.3", "#13 AC", and "5/02/24". To the right of the sample is a yellow measuring tape showing inches from 2 to 7.
C-14	4	---	Silt with SAND (ML)		 A photograph of a cylindrical core sample of asphalt concrete. The sample is dark and contains some aggregate. It is placed on a light-colored surface. To the left of the sample is a white rectangular label with handwritten text: "23-931.3", "#14 AC", and "5/02/24". To the right of the sample is a yellow measuring tape showing inches from 2 to 9.

PAVEMENT REPORT

Turlock Pavement Rehabilitation – Location 1
Turlock, California

Crawford & Associates, Inc.

File: 23-931.3

Core No.	AC (in)	AB (in)	Subgrade	Additional Notes	Photo
C-15	3.5	---	Silt with SAND (ML)		
C-16	2.5	4.5	Silt with SAND (ML)		

PAVEMENT REPORT

Turlock Pavement Rehabilitation – Location 1
Turlock, California

Crawford & Associates, Inc.

File: 23-931.3

Core No.	AC (in)	AB (in)	Subgrade	Additional Notes	Photo
C-17	3	3	Silt with SAND (ML)		
C-18	2	---	Silt with SAND (ML)		

PAVEMENT REPORT

Turlock Pavement Rehabilitation – Location 1
Turlock, California

Crawford & Associates, Inc.

File: 23-931.3

Core No.	AC (in)	AB (in)	Subgrade	Additional Notes	Photo
C-19	2.5	5.5	Silt with SAND (ML)		
C-20	3	3	Sandy Silt (ML)		

PAVEMENT REPORT

Turlock Pavement Rehabilitation – Location 1
Turlock, California

Crawford & Associates, Inc.

File: 23-931.3

Core No.	AC (in)	AB (in)	Subgrade	Additional Notes	Photo
C-21	2	6	Sandy Silt (ML)		
C-22	2.75	4	Sandy Silt (ML)		

PAVEMENT REPORT

Turlock Pavement Rehabilitation – Location 1
Turlock, California

Crawford & Associates, Inc.

File: 23-931.3

Core No.	AC (in)	AB (in)	Subgrade	Additional Notes	Photo
C-23	2	4	Sandy Silt (ML)		 A photograph of a cylindrical core sample of pavement. The core is composed of dark aggregate material with some lighter-colored sand and silt. A yellow measuring tape is placed vertically next to the core, showing a measurement of approximately 4 inches. The core is resting on a sandy surface.
C-24	3	3	Sandy Silt (ML)		 A photograph of a cylindrical core sample of pavement. The core is composed of dark aggregate material with some lighter-colored sand and silt. A yellow measuring tape is placed vertically next to the core, showing a measurement of approximately 3 inches. The core is resting on a sandy surface.

PAVEMENT REPORT

Turlock Pavement Rehabilitation – Location 1
Turlock, California

Crawford & Associates, Inc.

File: 23-931.3

Core No.	AC (in)	AB (in)	Subgrade	Additional Notes	Photo
C-25	2	4	Silt with SAND (ML)		
C-26	4.5	2	Sandy Silt (ML)		

PAVEMENT REPORT

Turlock Pavement Rehabilitation – Location 1
Turlock, California

Crawford & Associates, Inc.

File: 23-931.3

Core No.	AC (in)	AB (in)	Subgrade	Additional Notes	Photo
C-27	6	---	Sandy Silt (ML)		
C-28	5.5	---	Sandy Silt (ML)		

PAVEMENT REPORT

Turlock Pavement Rehabilitation – Location 1
Turlock, California

Crawford & Associates, Inc.

File: 23-931.3

Core No.	AC (in)	AB (in)	Subgrade	Additional Notes	Photo
C-29	8	---	Sandy Silt (ML)		
C-30	3.5	---	Sandy Silt (ML)		

PAVEMENT REPORT

Turlock Pavement Rehabilitation – Location 1
Turlock, California

Crawford & Associates, Inc.

File: 23-931.3

Core No.	AC (in)	AB (in)	Subgrade	Additional Notes	Photo
C-31	3	4	Sandy Silt (ML)		 A photograph of a cylindrical core sample of asphalt pavement. The core is dark with visible aggregate. It is placed on a white surface next to a yellow measuring tape. A white card with handwritten text is visible in the background: "23-931.3", "#31 NB", and "4/29/24".
C-32	3	2	Sandy Silt (ML)		 A photograph of a cylindrical core sample of asphalt pavement. The core is dark with visible aggregate. It is placed on a white surface next to a yellow measuring tape. A white card with handwritten text is visible in the background: "23-931.3", "#32 NB", and "4/29/24".

PAVEMENT REPORT

Turlock Pavement Rehabilitation – Location 1
Turlock, California

Crawford & Associates, Inc.

File: 23-931.3

Core No.	AC (in)	AB (in)	Subgrade	Additional Notes	Photo
C-33	2.5	3.5	Sandy Silt (ML)		 A photograph of a dark, cylindrical core sample (C-33) resting on a light-colored surface. A yellow measuring tape is positioned vertically to the right of the core, showing a scale from 2 to 9 inches. In the background, a white surface has handwritten text: "23-931.3", "#33 NB", and "4/29/24".
C-34	2	3	Sandy Silt (ML)		 A photograph of a light-colored, cylindrical core sample (C-34) resting on a light-colored surface. A yellow measuring tape is positioned vertically to the right of the core, showing a scale from 2 to 7 inches. In the background, a white surface has handwritten text: "23-931.1", "#34 NB", and "4/29/24".

PAVEMENT REPORT

Turlock Pavement Rehabilitation – Location 1
Turlock, California

Crawford & Associates, Inc.

File: 23-931.3

Core No.	AC (in)	AB (in)	Subgrade	Additional Notes	Photo
C-35	1.5	---	Sandy Silt (ML)		
C-36	5.5	---	Sandy Silt (ML)		

PAVEMENT REPORT

Turlock Pavement Rehabilitation – Location 1
Turlock, California

Crawford & Associates, Inc.

File: 23-931.3

Core No.	AC (in)	AB (in)	Subgrade	Additional Notes	Photo
C-37	5	---	Sandy Silt (ML)		
C-38	4	---	Sandy Silt (ML)		

PAVEMENT REPORT

Turlock Pavement Rehabilitation – Location 1
Turlock, California

Crawford & Associates, Inc.

File: 23-931.3

Core No.	AC (in)	AB (in)	Subgrade	Additional Notes	Photo
C-39	1	2	Silt with SAND (ML)		
C-40	2	2	Silt with SAND (ML)		

PAVEMENT REPORT

Turlock Pavement Rehabilitation – Location 1
Turlock, California

Crawford & Associates, Inc.

File: 23-931.3


Core No.	AC (in)	AB (in)	Subgrade	Additional Notes	Photo
C-41	2.5	1.5	SANDY Silt (ML)		
C-42	2	3	Silt with SAND (ML)		

PAVEMENT REPORT

Turlock Pavement Rehabilitation – Location 1
Turlock, California

Crawford & Associates, Inc.

File: 23-931.3

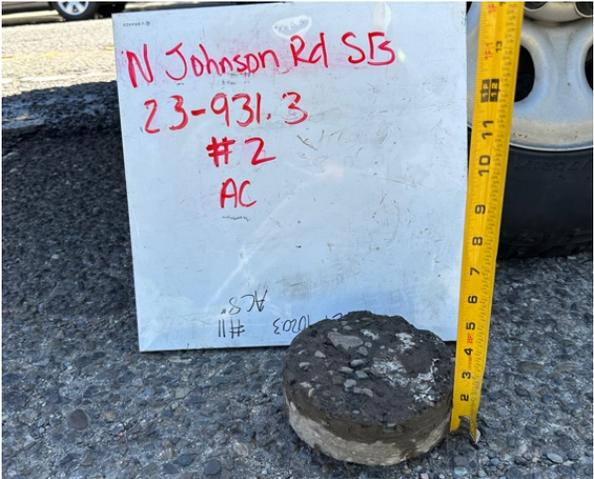Core No.	AC (in)	AB (in)	Subgrade	Additional Notes	Photo
C-43	2	-	Silty SAND (ML)		 A photograph showing a core sample of silty sand. A white sign with red handwritten text reads "23-931.3 #1 AC". A yellow measuring tape is placed vertically next to the sample, showing a height of approximately 2 inches. The sample is a dark, irregular mass of soil and aggregate.
C-44	2	5	Silty SAND (ML)		 A photograph showing a core sample of silty sand. A white sign with red handwritten text reads "N Johnson Rd SFS 23-931.3 #2 AC". A yellow measuring tape is placed vertically next to the sample, showing a height of approximately 2 inches. The sample is a dark, cylindrical mass of soil and aggregate.

PAVEMENT REPORT

Turlock Pavement Rehabilitation – Location 1
Turlock, California

Crawford & Associates, Inc.

File: 23-931.3


Core No.	AC (in)	AB (in)	Subgrade	Additional Notes	Photo
C-45	2	5	Silty SAND (ML)		 A photograph of a cylindrical core sample of silty sand. The sample is placed on a gravel surface. To its left is a white paper bag with handwritten text in red: "Sconyers Ct. WB", "23-931.3", "#3", and "AC". At the bottom of the bag, there is also handwritten text: "AC 8", "#11", and "24 1023". To the right of the core is a yellow measuring tape showing inches from 6 to 11.
C-46	1.5	5.5	Silty SAND (ML)		 A photograph of a cylindrical core sample of silty sand. The sample is placed on a gravel surface. To its left is a white paper bag with handwritten text in red: "Ashley Ct. WB", "23-931.3", "#4", and "AC". At the bottom of the bag, there is also handwritten text: "AC 8", "#11", and "24 1023". To the right of the core is a yellow measuring tape showing inches from 6 to 11.

PAVEMENT REPORT

Turlock Pavement Rehabilitation – Location 1
Turlock, California

Crawford & Associates, Inc.

File: 23-931.3

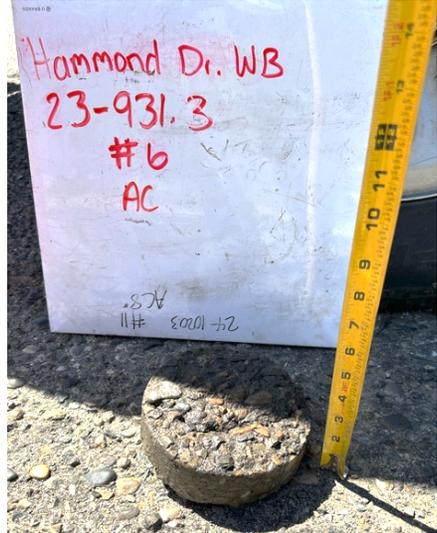
Core No.	AC (in)	AB (in)	Subgrade	Additional Notes	Photo
C-47	2	5.5	Silt with SAND (ML)		
C-48	2	6.5	Sandy SILT (ML)		

PAVEMENT REPORT

Turlock Pavement Rehabilitation – Location 1
Turlock, California

Crawford & Associates, Inc.

File: 23-931.3

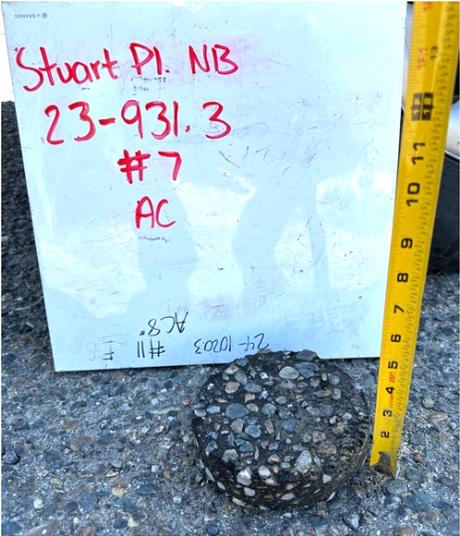Core No.	AC (in)	AB (in)	Subgrade	Additional Notes	Photo
C-49	1.5	6.5	Silty SAND (ML)		
C-50	2	4	Silty SAND (ML)		

PAVEMENT REPORT

Turlock Pavement Rehabilitation – Location 1
 Turlock, California

Crawford & Associates, Inc.

File: 23-931.3



Core No.	AC (in)	AB (in)	Subgrade	Additional Notes	Photo
C-51	1	-	Silt with SAND (ML)	2.5" of oil road	
C-52	2	3	Silt with SAND (ML)		

PAVEMENT REPORT

Turlock Pavement Rehabilitation – Location 1
Turlock, California

Crawford & Associates, Inc.

File: 23-931.3

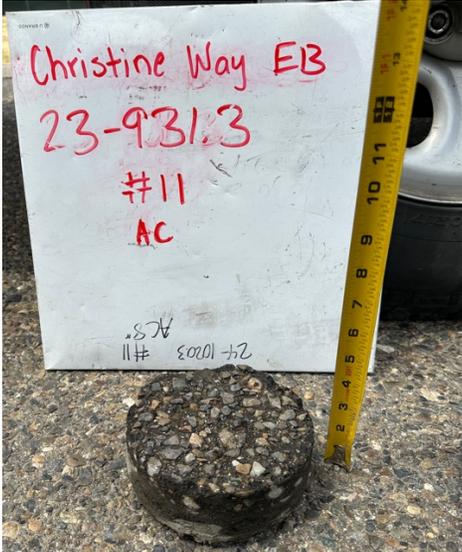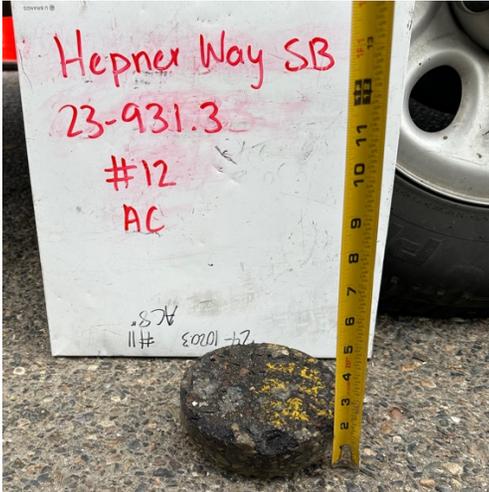
Core No.	AC (in)	AB (in)	Subgrade	Additional Notes	Photo
C-53	2	3.5	Silt with SAND (ML)		
C-54	1.5	5.5	Silt with SAND (ML)		

PAVEMENT REPORT

Turlock Pavement Rehabilitation – Location 1
 Turlock, California

Crawford & Associates, Inc.

File: 23-931.3

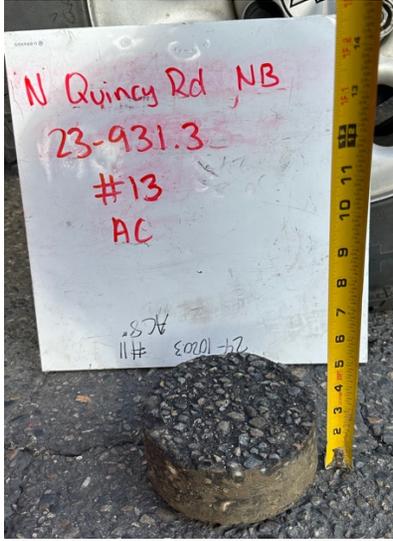Core No.	AC (in)	AB (in)	Subgrade	Additional Notes	Photo
C-55	2	4	Silt with SAND (ML)		
C-56	2		Silt with SAND (ML)	5" of oil road	

PAVEMENT REPORT

Turlock Pavement Rehabilitation – Location 1
 Turlock, California

Crawford & Associates, Inc.

File: 23-931.3

Core No.	AC (in)	AB (in)	Subgrade	Additional Notes	Photo
C-57	1.5	-	Silt with SAND (ML)	3.5" of oil road	
C-58	2	6	Silt with SAND (ML)		

PAVEMENT REPORT

Turlock Pavement Rehabilitation – Location 1
Turlock, California

Crawford & Associates, Inc.

File: 23-931.3


Core No.	AC (in)	AB (in)	Subgrade	Additional Notes	Photo
C-59	2	8	Silt with SAND (ML)		
C-60	2	4	Silt with SAND (ML)		

PAVEMENT REPORT

Turlock Pavement Rehabilitation – Location 1
 Turlock, California

Crawford & Associates, Inc.

File: 23-931.3

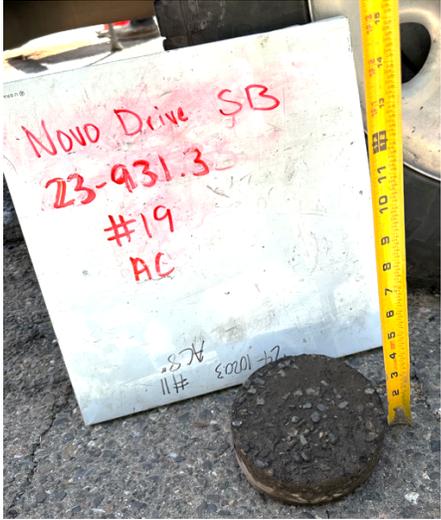Core No.	AC (in)	AB (in)	Subgrade	Additional Notes	Photo
C-61	2	5	Silt with SAND (ML)		
C-62	4	-	Sandy SILT (ML)	3" of oil road	

PAVEMENT REPORT

Turlock Pavement Rehabilitation – Location 1
 Turlock, California

Crawford & Associates, Inc.

File: 23-931.3


Core No.	AC (in)	AB (in)	Subgrade	Additional Notes	Photo
C-63 (Says #20 but correct location is #21)	1.5	-	Sandy SILT (ML)	3.25" of oil road	
C-64	1.5	5.5	Sandy SILT (ML)		

APPENDIX B

Laboratory Test Results

RESISTANCE (R) VALUE TEST
California Test 301

Laboratory No.: L241037
 Project No.: 240017 (Crawford & Associates Project: 23-931.3)
 Sample Date: April 26, 2024
 Report Date: May 20, 2024
 Client: Crawford & Associates, Inc.
 Project Name: 2024 Laboratory Testing - Turlock Pavement Rehabilitation
 Sample Description: Brown Clayey Silt
 Sample Location: C41 @ 4"-34"

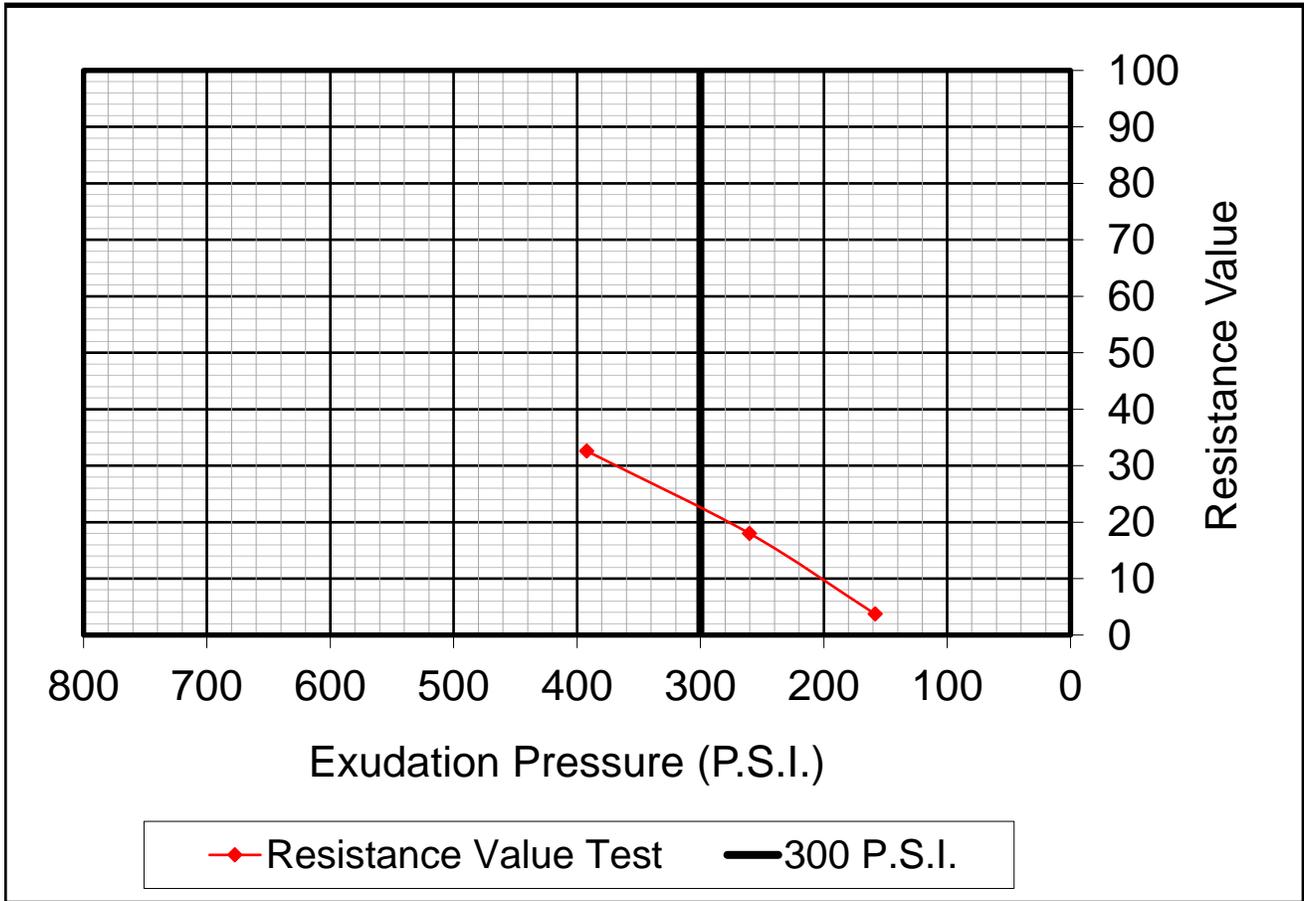

Specimen No.	1	2	3
Moisture Content (%)	22.4	21.3	22.9
Dry Density (PCF)	110.7	112.6	110.1
Resistance Value (R)	18	33	4
Exudation Pressure (PSI)	260	392	158
Expansion Pressure	22	52	0
As Received Moisture Content (%)	22.4		


RESISTANCE VALUE AT 300 P.S.I. 23



Reviewed By: 
Brandon Rodebaugh
 Materials Engineer

RESISTANCE VALUE
California Test Method No. 301

Job Number:	23-931.3	Date Tested:	5/24/2024	R-value:	60
Project:	Turlock Pavement Rahab			Sample :	C30
Classification of Material:	Sm, Silty Sand , Brown			Technician: D.S.	
Initial Sample Weight	1100	1100	1100		
Mold Number	D	F	E		
Air Pressure-PSI	100	75	60		
Initial Moisture %	5.2	5.2	5.2		
Water Added ml/g	50	55	60		
Water Added %	4.8	5.3	5.7		
Final Moist %	10.0	10.5	11.0		
Soil + Mold Weight-Grams	3203.5	3197.3	3162.8		
Mold Weight-Grams	2073	2067	2029		
Soil Weight-Grams	1130.5	1130.3	1133.8		
Height of Sample-Inches	2.55	2.55	2.54		
Density-PCF	122.1	121.6	121.9		
Dial Reading (x.0001 inches)	91	96	107		
Expansion Pressure (psf)	394	416	463		
Stabilometer at 1000 lbs.	24	26	28		
2000 lbs.	42	44	46		
Displacement	4.16	4.19	4.29		
Exudation Pressure-Lbs	7650	3990	3240		
Exudation-PSI	609	318	258		
R-Value Calculated	63	61	59		
Corrected R-Value	63	61	59		

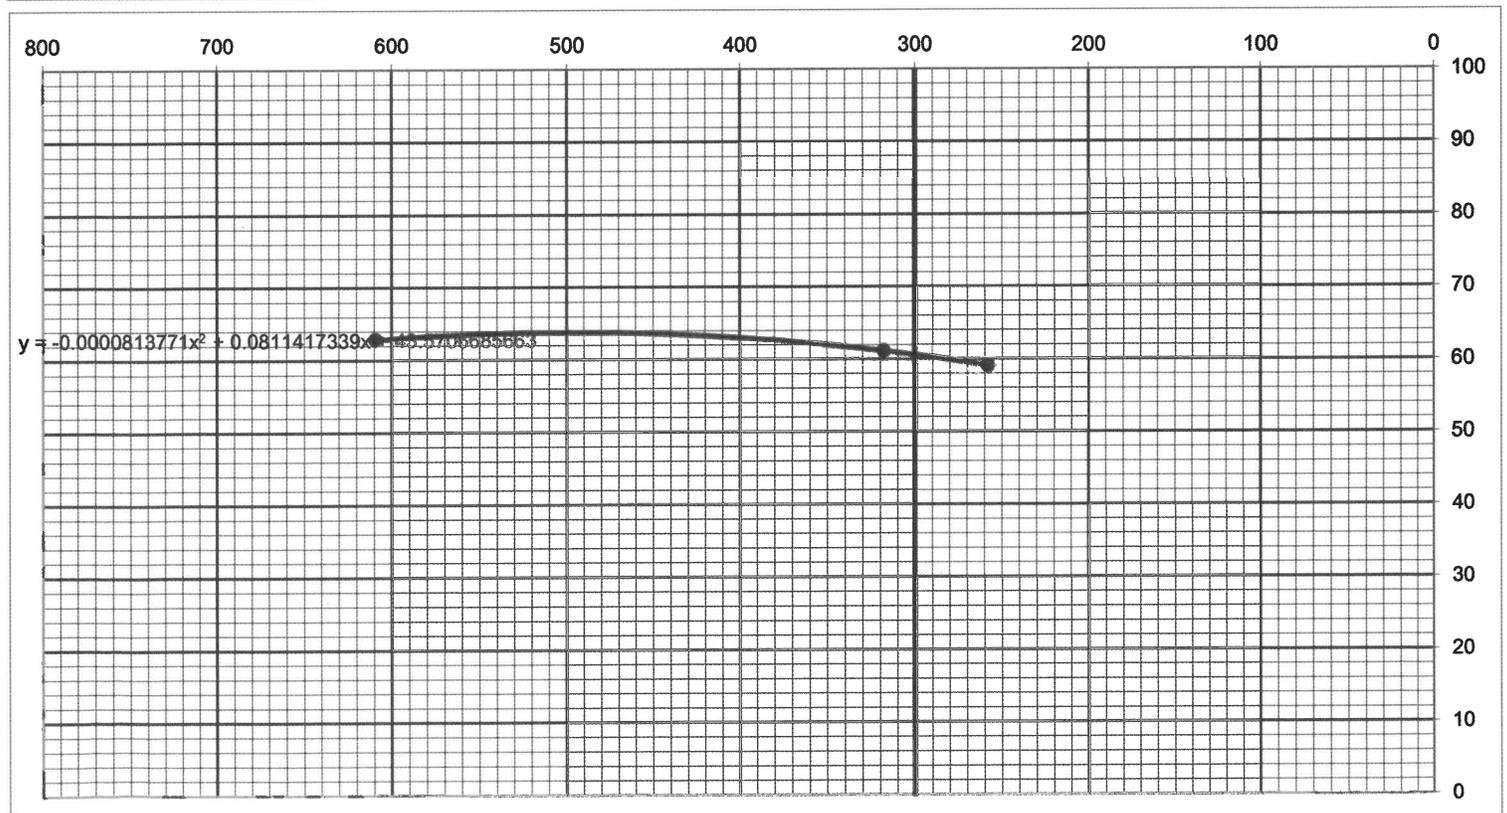

RESISTANCE VALUE
California Test Method No. 301

Job Number:	23-931.3	Date Tested: 5/24/2024		R-value:	49
Project:	Turlock Pavement Rahab			Sample :	C5
Classification of Material:	Sm, Silty Sand , Brown			Technician: D.S.	
Initial Sample Weight	1105	1100	1100		
Mold Number	A	B	C		
Air Pressure-PSI	100	75	50		
Initial Moisture %	5.4	5.4	5.4		
Water Added ml/g	55	57	60		
Water Added %	5.2	5.5	5.7		
Final Moist %	10.6	10.8	11.1		
Soil + Mold Weight-Grams	3218.9	3212.4	3211.1		
Mold Weight-Grams	2086	2085	2083		
Soil Weight-Grams	1132.9	1127.4	1128.1		
Height of Sample-Inches	2.48	2.49	2.47		
Density-PCF	125.1	123.8	124.5		
Dial Reading (x.0001 inches)	78	89	99		
Expansion Pressure (psf)	338	385	429		
Stabilometer at 1000 lbs.	30	31	33		
2000 lbs.	49	54	60		
Displacement	4.88	4.91	4.98		
Exudation Pressure-Lbs	7650	3990	3240		
Exudation-PSI	609	318	258		
R-Value Calculated	54	50	46		
Corrected R-Value	54	50	46		

